E.R.
1 1937 9 96

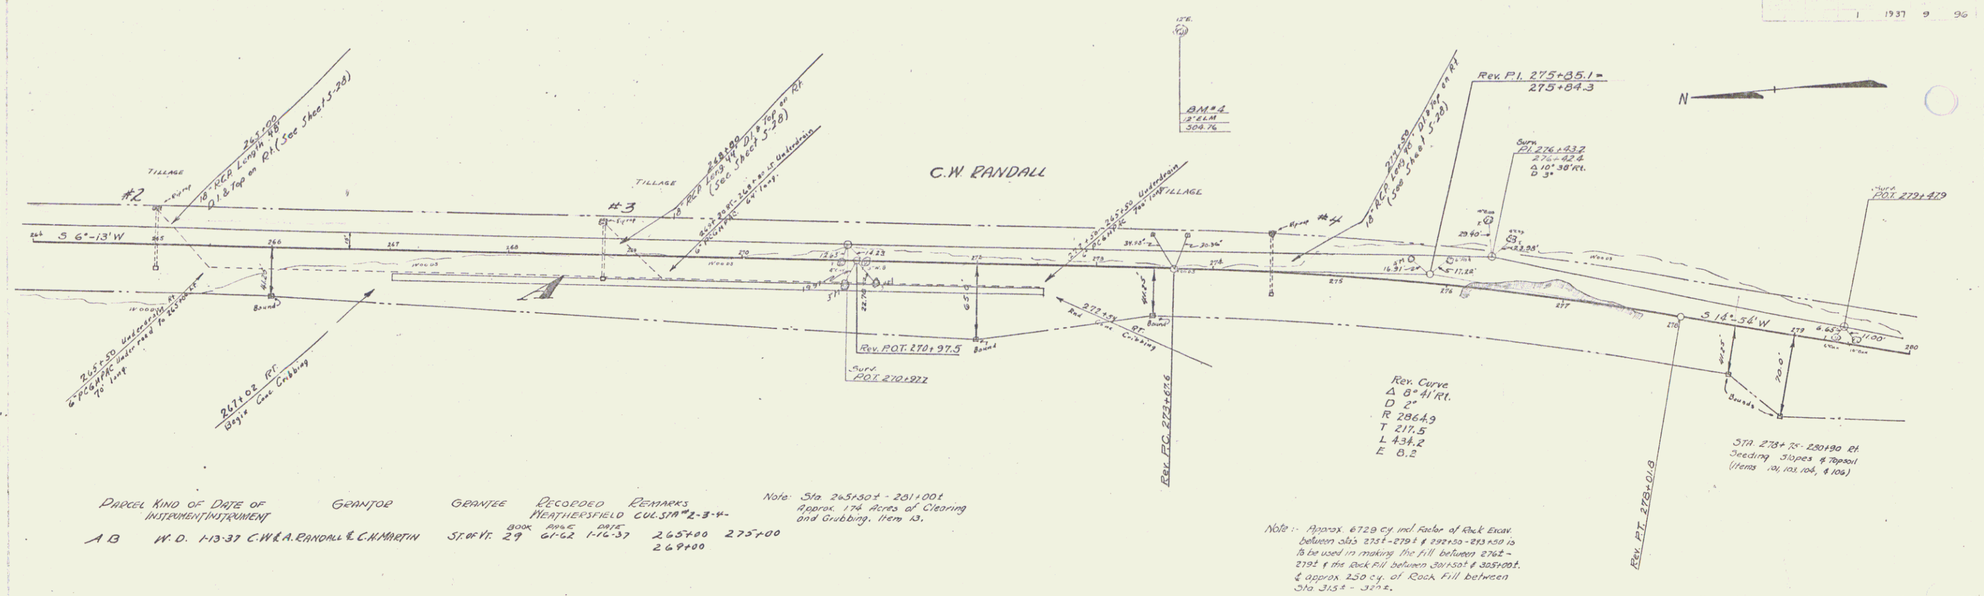

7