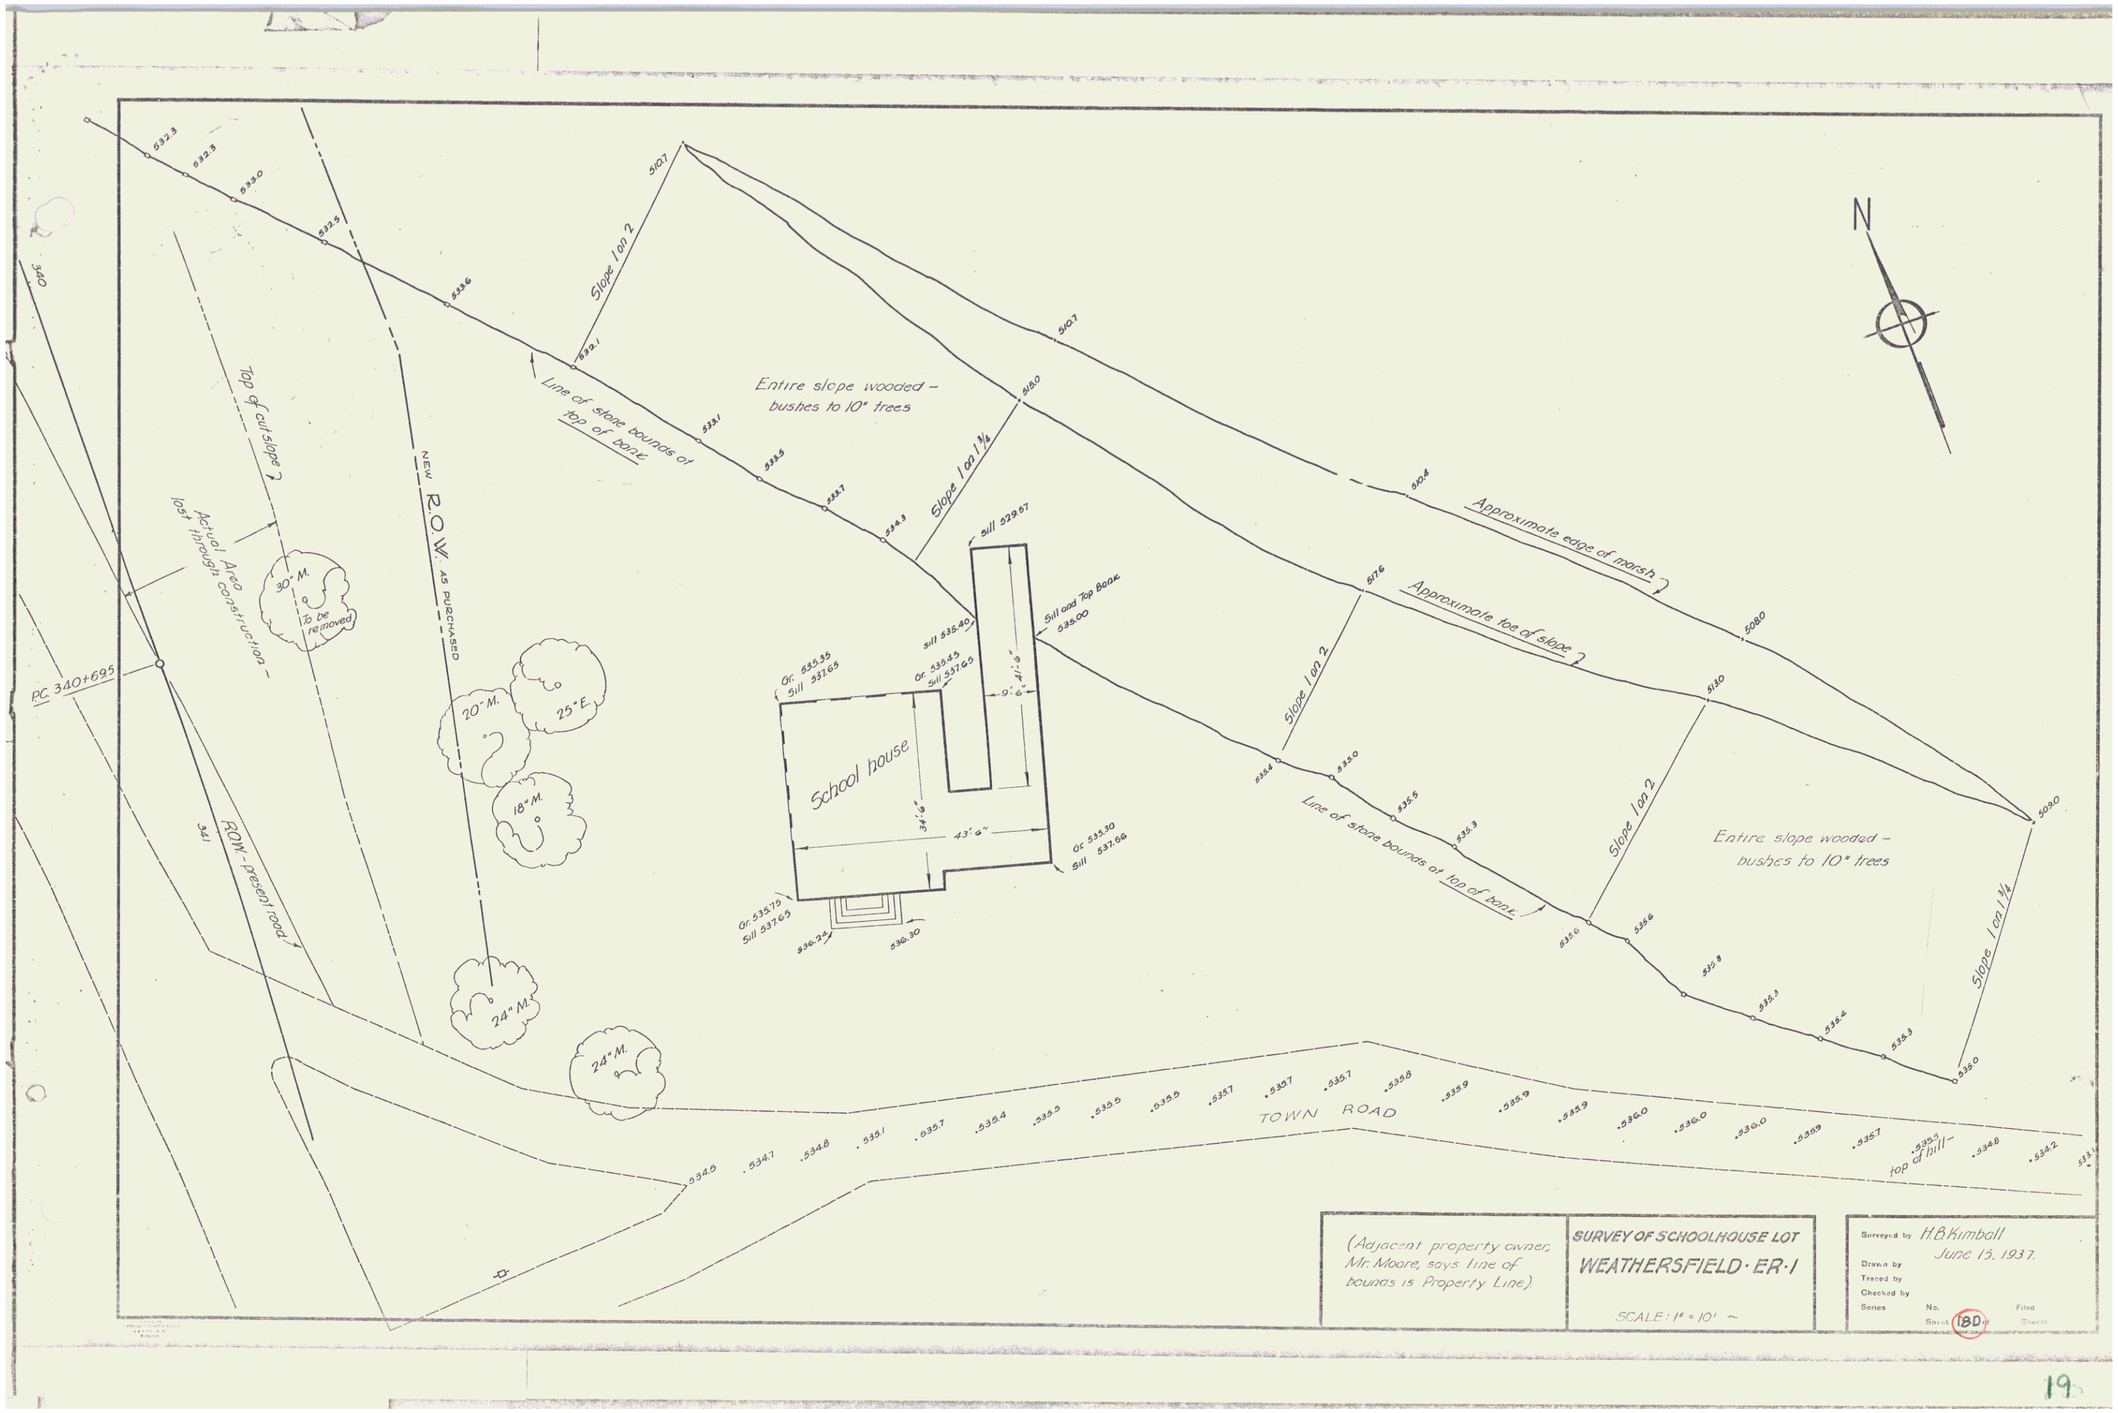

(Adjacent property owner, Mr. Moore, says line of bounds is Property Line)

SURVEY OF SCHOOLHOUSE LOT

WEATHERSFIELD · ER · I

SCALE: 1" = 10'

Surveyed by H.B. Kimball
June 15, 1937.
Drawn by
Traced by
Checked by
Series No. Filed
Sheet 18D of Sheets

19