REGIONAL DIST. NO.	STATE	FED. AID PROJ. NO.	FISCAL YEAR	SHEET NO.	TOTAL SHEETS
9	Vt.	BRF 64A(2)	1941		

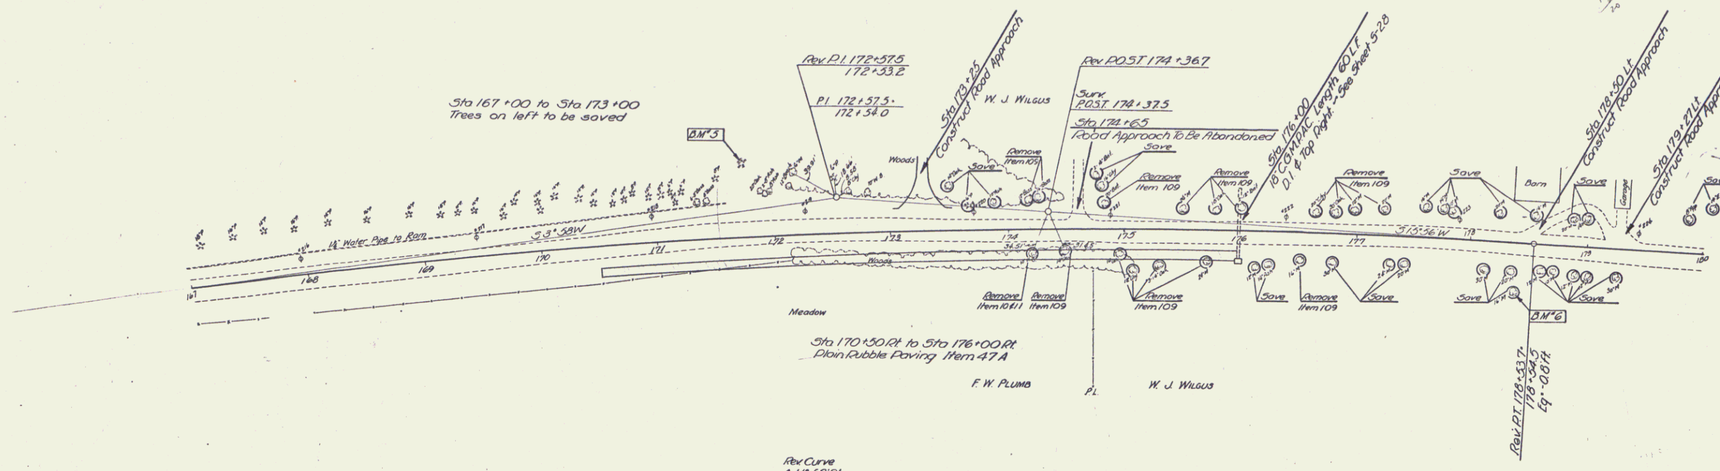

Rev. Curve
Δ 11° 38' Rt.
D 1°
R 5729.7
T 600.3
L 1196.7
E 31.2

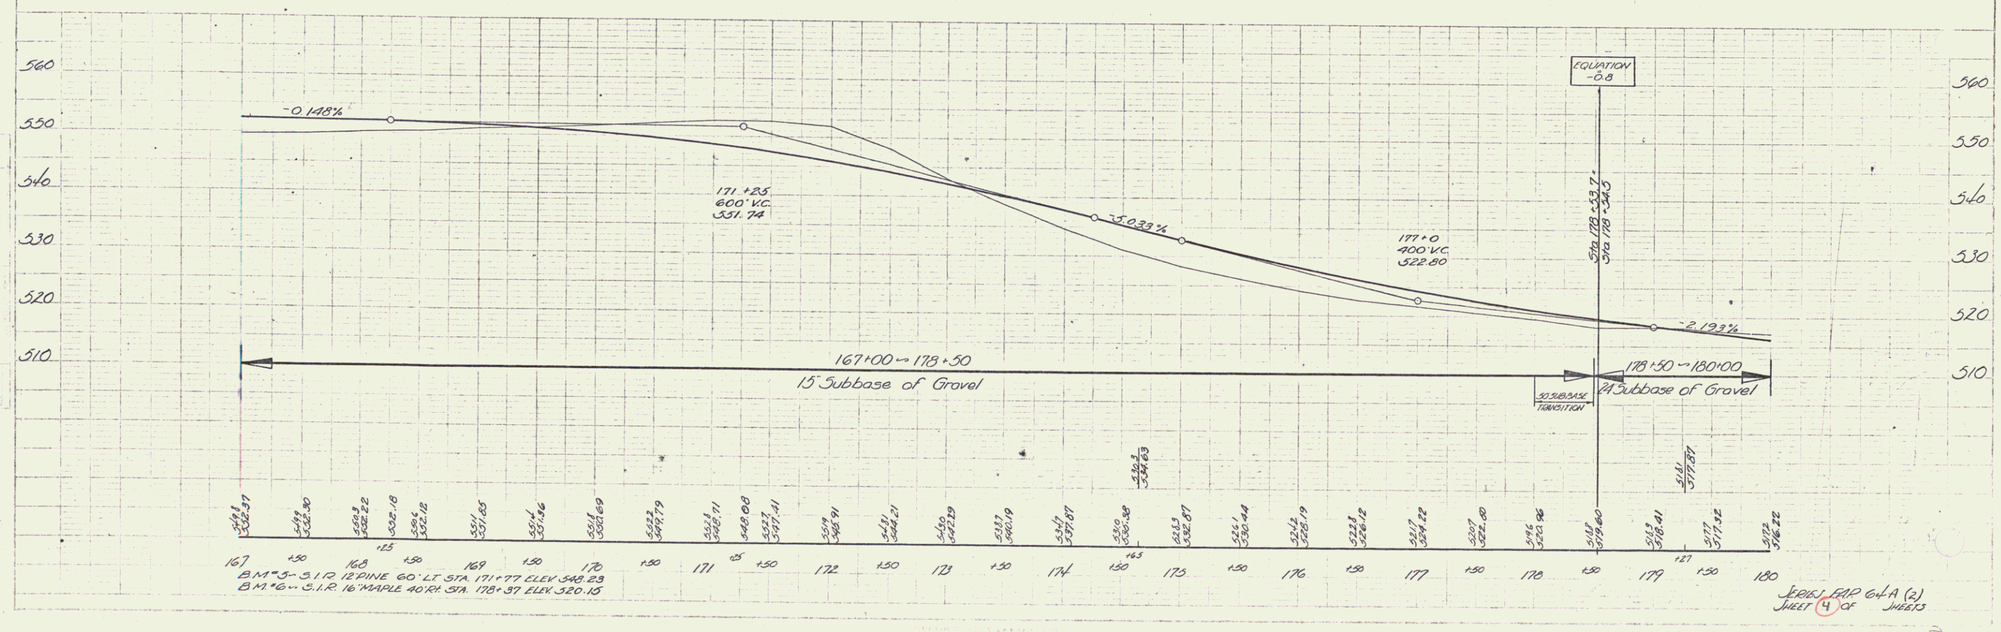

SERIES FAP 64A (2)
SHEET 4 OF SHEETS

Revised 3

7