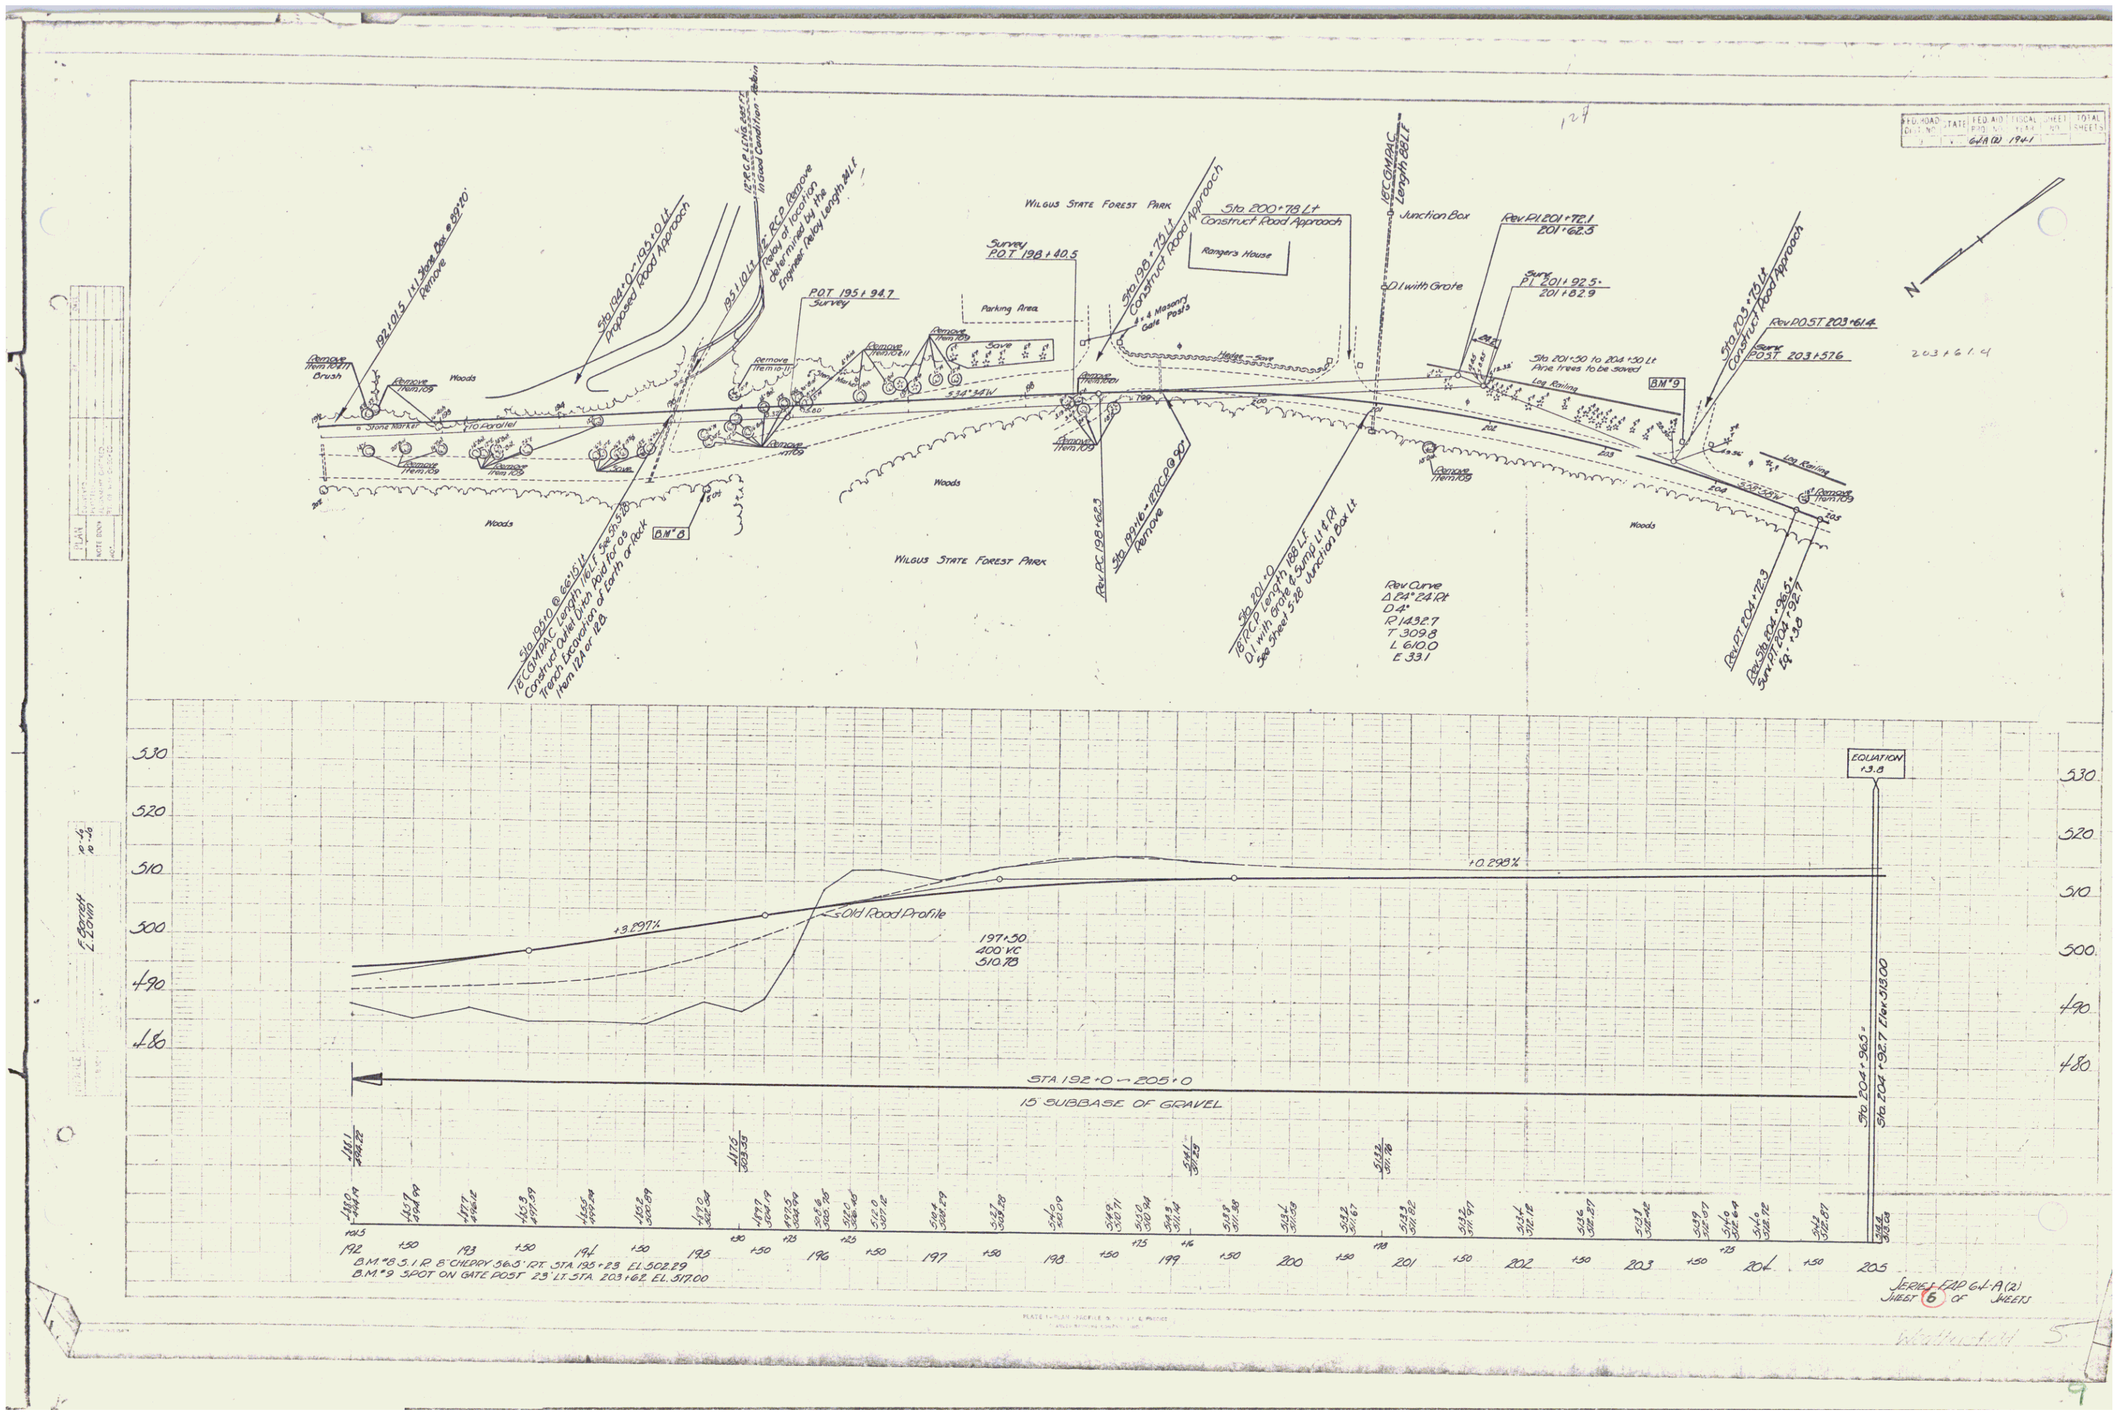
Wilgus State Forest Park
Rangers House
Parking Area
Woods
Sta. 200+78 Lt
Construct Road Approach
Junction Box
D.I. with Grate
Survey P.O.T. 198+40.5
P.O.T. 195+94.7 Survey
Rev. P.I. 201+72.1
201+62.5
Survey P.I. 201+92.5
201+82.9
Rev. P.O.T. 203+61.4
Survey P.O.T. 203+576
203+61.4
Sta. 201+50 to 204+50 Lt
Pine Trees to be saved
Log Raking
BM #9
BM #8
Rev. Curve
Δ 24°24'Rt
D 4°
R 1432.7
T 309.8
L 610.0
E 33.1
Sta. 192+0 – 205+0
15" SUBBASE OF GRAVEL
+3.897%
+0.293%
Old Road Profile
197+50
400' VC
510.78
EQUATION +3.8
Sta. 204+96.5 = Sta. 204+92.7 Elev. 313.00
B.M. #8 S.I.R. 8" CHERRY 56.5' RT. STA 195+28 EL. 502.29
B.M. #9 SPOT ON GATE POST 23' LT. STA 203+62 EL. 317.00
SERIAL FAP 64-A(2)
SHEET 6 OF SHEETS