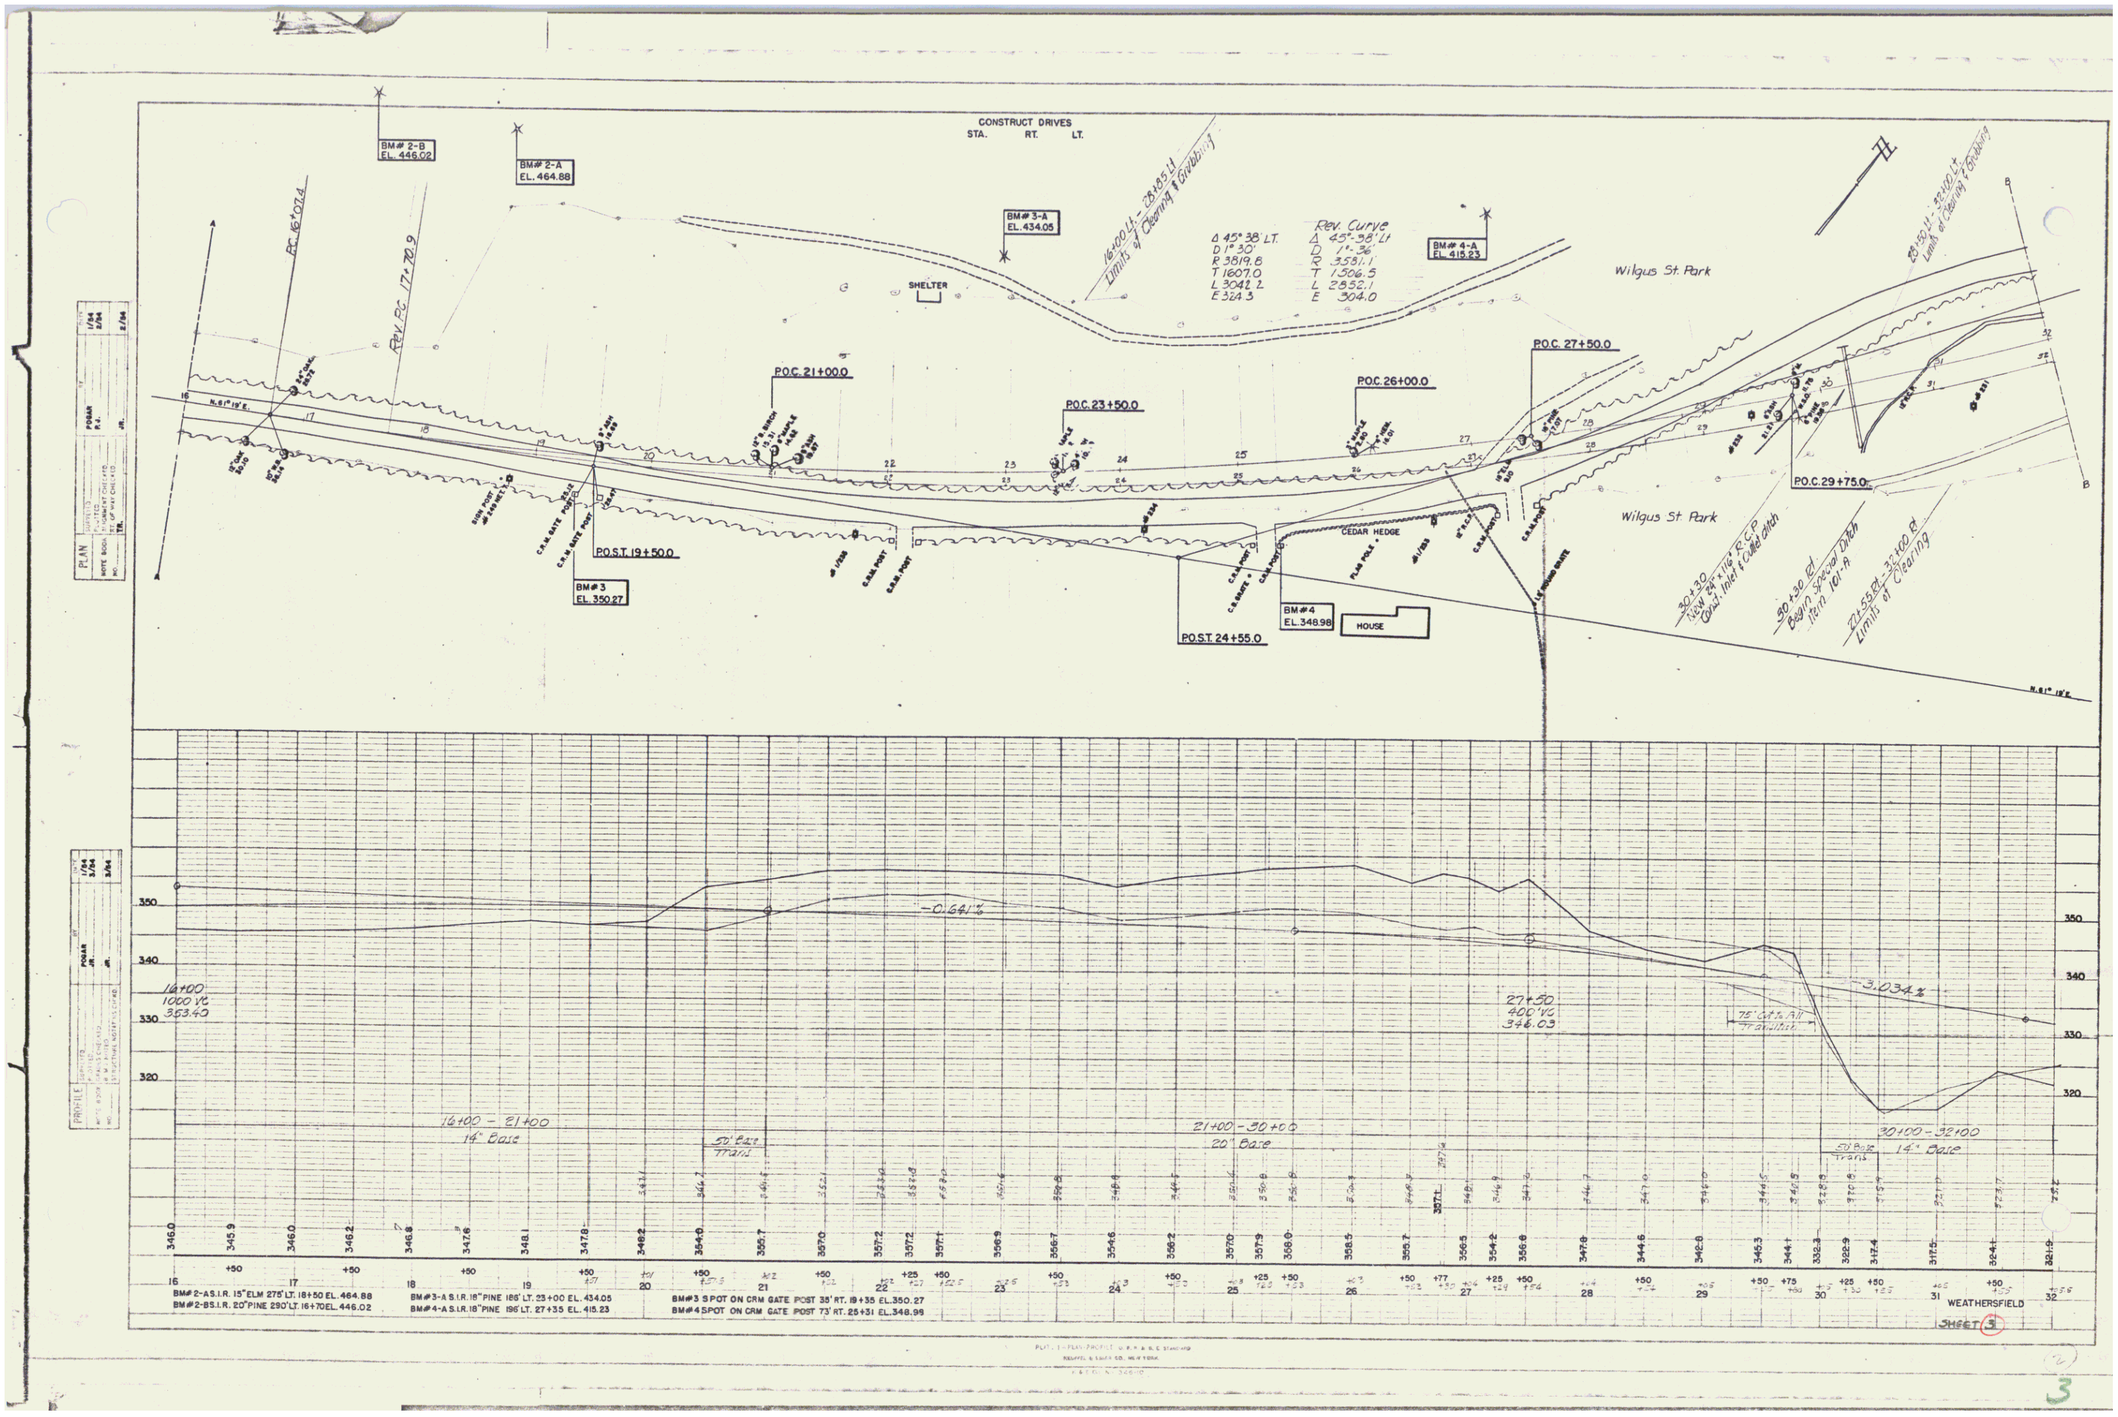
CONSTRUCT DRIVES
STA. RT. LT.
BM# 2-B
EL. 446.02
BM# 2-A
EL. 464.88
BM# 3-A
EL. 434.05
BM# 4-A
EL. 415.23
SHELTER
Wilgus St. Park
P.O.C. 21+00.0
P.O.C. 23+50.0
P.O.C. 26+00.0
P.O.C. 27+50.0
P.O.C. 29+75.0
P.O.S.T. 19+50.0
P.O.S.T. 24+55.0
BM# 3
EL. 350.27
BM# 4
EL. 348.98
HOUSE
CEDAR HEDGE
Rev. Curve
Δ 45°38' LT.
D 1°30'
R 3819.8
T 1607.0
L 3042.2
E 324.3
Rev. Curve
Δ 45°38' LT
D 1°36'
R 3581.1
T 1506.5
L 2852.1
E 304.0
-0.641%
-3.034%
16+00
1000 VC
363.40
27+50
400' VC
346.03
16+00 - 21+00
14" Base
21+00 - 30+00
20" Base
30+00 - 32+00
14" Base
BM#2-A S.I.R. 15" ELM 275' LT. 18+50 EL. 464.88
BM#2-B S.I.R. 20" PINE 290' LT. 16+70 EL. 446.02
BM#3-A S.I.R. 18" PINE 186' LT. 23+00 EL. 434.05
BM#4-A S.I.R. 18" PINE 196' LT. 27+35 EL. 415.23
BM#3 SPOT ON CRM GATE POST 35' RT. 19+35 EL. 350.27
BM#4 SPOT ON CRM GATE POST 73' RT. 25+31 EL. 348.98
WEATHERSFIELD
SHEET 3