Fed Road Dist. No.	State	Fed Aid Proj. No.	Fiscal Year	Sheet No.	Total Sheets
9	VI	648	1927	4	32

Wood Guard Rail Required

Right
53
Sta 55+38 to 55+63 length 24 ft
11

Left
53
Sta 55+38 to 55+63 length 24 ft
11

New Culverts Required

Sta 55+00 15" Reinf. Conc. Pipe length 52 ft
Conc. Class B (1:2:4) 1.1 cu. yd.
Reinf. Steel 135.88 lbs
Conc. Class II 3.7 cu.

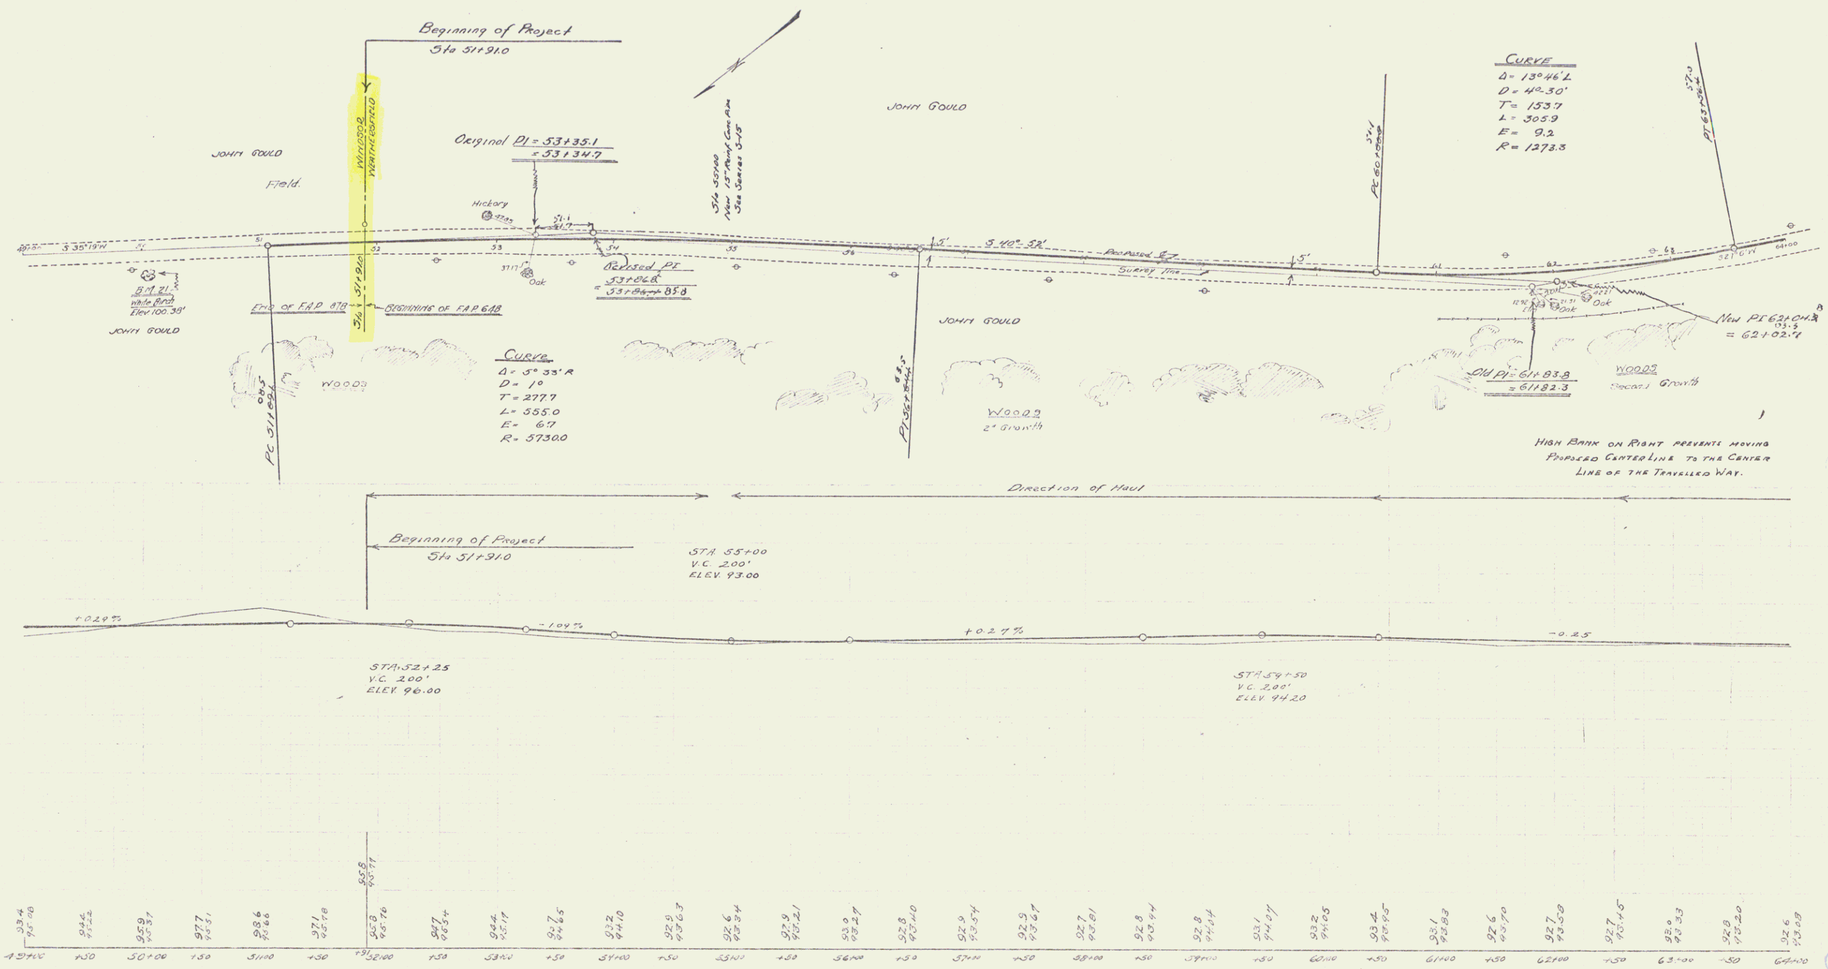

BM #21 — 18" White Birch 20' of Sta 50+00 - ELEV. 100.39 ft

Series F No. 648
Sheet 4 of 32