Joints on Curb and gutter not to exceed 8 yards. Premoulded bituminous expansion joint filler ½" thick to be placed between every third Section (every 24'). Remaining joints to be either butt joints Poured with bituminous material, or Cut Plate Joints.

DETAIL OF RETAINING WALL, CURB, & GUTTER

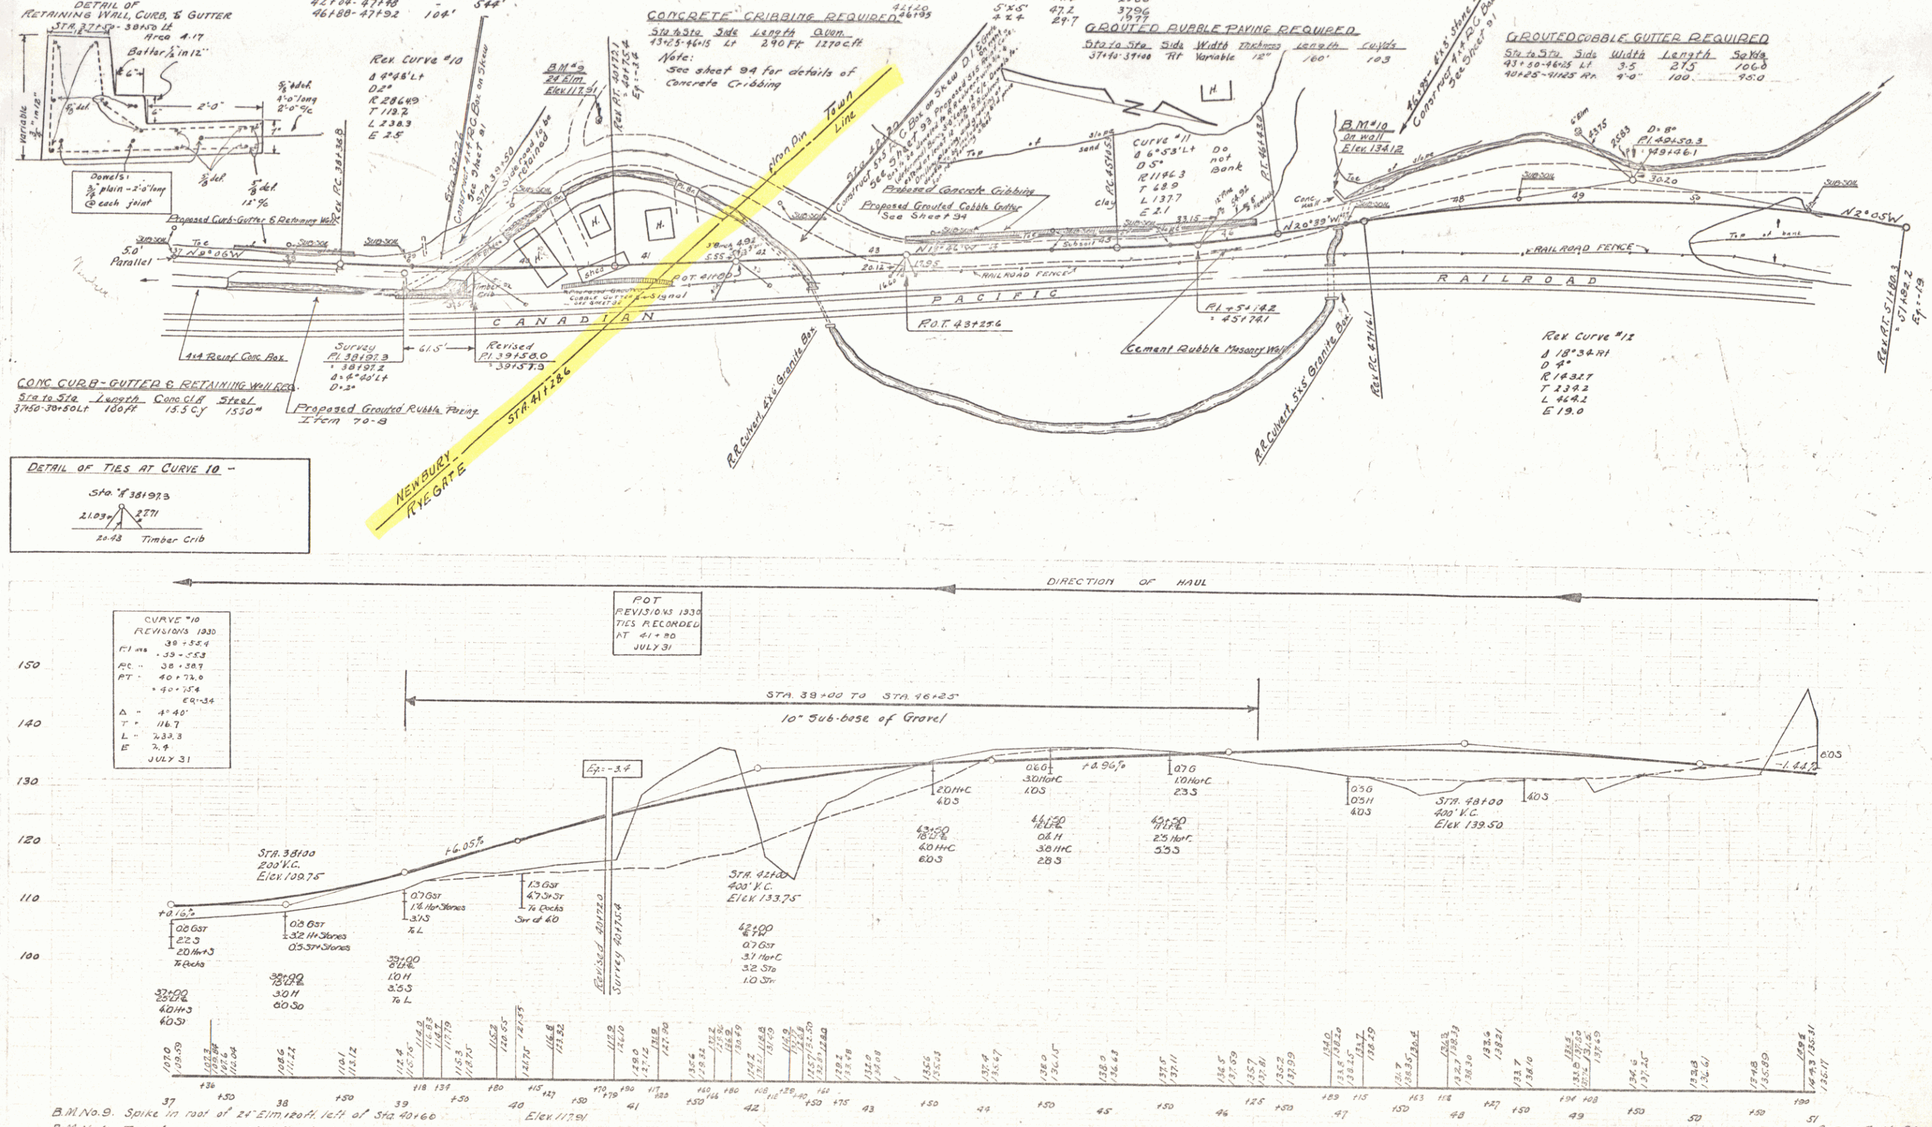


| Revisions | By | Date |
|---|---|---|
| 3 | V | 7-46 1930 6 27 |

CABLE GUARD RAIL REQUIRED

| Stations | Left | Right |
|---|---|---|
| 37+40-39+25 | - | 184' |
| 39+65-42+45 | 280' | - |
| 42+08-47+48 | - | 544' |
| 46+80-47+92 | 104' | |

CEMENT RUBBLE MASONRY WALL REQUIRED

| Sta to Sta | Length | Cu Yds | Side |
|---|---|---|---|
| 45+80-46+15 | 35 | 8 | Rt |

CONCRETE CRIBBING REQUIRED

| Sta to Sta | Side | Length | Cu Yds |
|---|---|---|---|
| 43+25-46+15 | Lt | 290 Ft | 1270 cft |

Note: See sheet 94 for details of Concrete Cribbing

NEW REINF. CONC. BOX CULVERTS REQUIRED

| Station | Size | Conc. A | Steel |
|---|---|---|---|
| 35+00-37+40 Rt. | 4'x4' | 72.1 c.y. | 5250# |
| 39+26 | 4'x4' | 44.4 | 2986 |
| 42+20 | 5'x5' | 47.2 | 3706 |
| 46+93 | 4'x4' | 29.7 | 1977 |

DROP INLETS REQUIRED

| Station | Side | Conc. A | Steel | D1 Grate |
|---|---|---|---|---|
| 42+40 | Rt. | 1.4 c.y. | 99# | 1 |

GROUTED RUBBLE PAVING REQUIRED

| Sta to Sta | Side | Width | Thickness | Length | Cu Yds |
|---|---|---|---|---|---|
| 37+40-37+80 | Rt | Variable | 12" | 160' | 103 |

GROUTED COBBLE GUTTER REQUIRED

| Sta to Sta | Side | Width | Length | Sq Yds |
|---|---|---|---|---|
| 43+50-46+15 | Lt | 3.5 | 215 | 106.0 |
| 40+25-41+25 | Rt. | 4'-0" | 100 | 45.0 |

CONC. CURB-GUTTER & RETAINING WALL REQ.

| Sta to Sta | Length | Conc. C.A | Steel |
|---|---|---|---|
| 37+50-38+50 Lt | 100 Ft | 15.5 C.y. | 1550# |

DETAIL OF TIES AT CURVE 10 –

Sta. ℄ 38+97.3

21.03 — 27.71

20.48 Timber Crib




B.M. No. 9. Spike in root of 24" Elm 120 ft. left of Sta. 40+60

B.M. No. 10. Top of conc. wall, 24 ft. left of Sta. 47+25. Elev. 134.12

SERIES F No. 74C Sec 1

SHEET 6 OF 97

3