ROAD NO.	STATE	FEDERAL AID NO.	FISCAL YEAR	SHEET NO.	TOTAL SHEETS
	VT.	74C &	1936	47	97

WOOD GUARD RAIL REQUIRED

Station	Left	Right
171+70	24	24
166+96	24	24

NEW CAST IRON PIPE CULVERTS REQUIRED

Station	Diam	Length	Conc. C	Steel
171+70	15"	40'	2.3 c.y.	33#
166+96	15"	48'	2.3 cy	33#

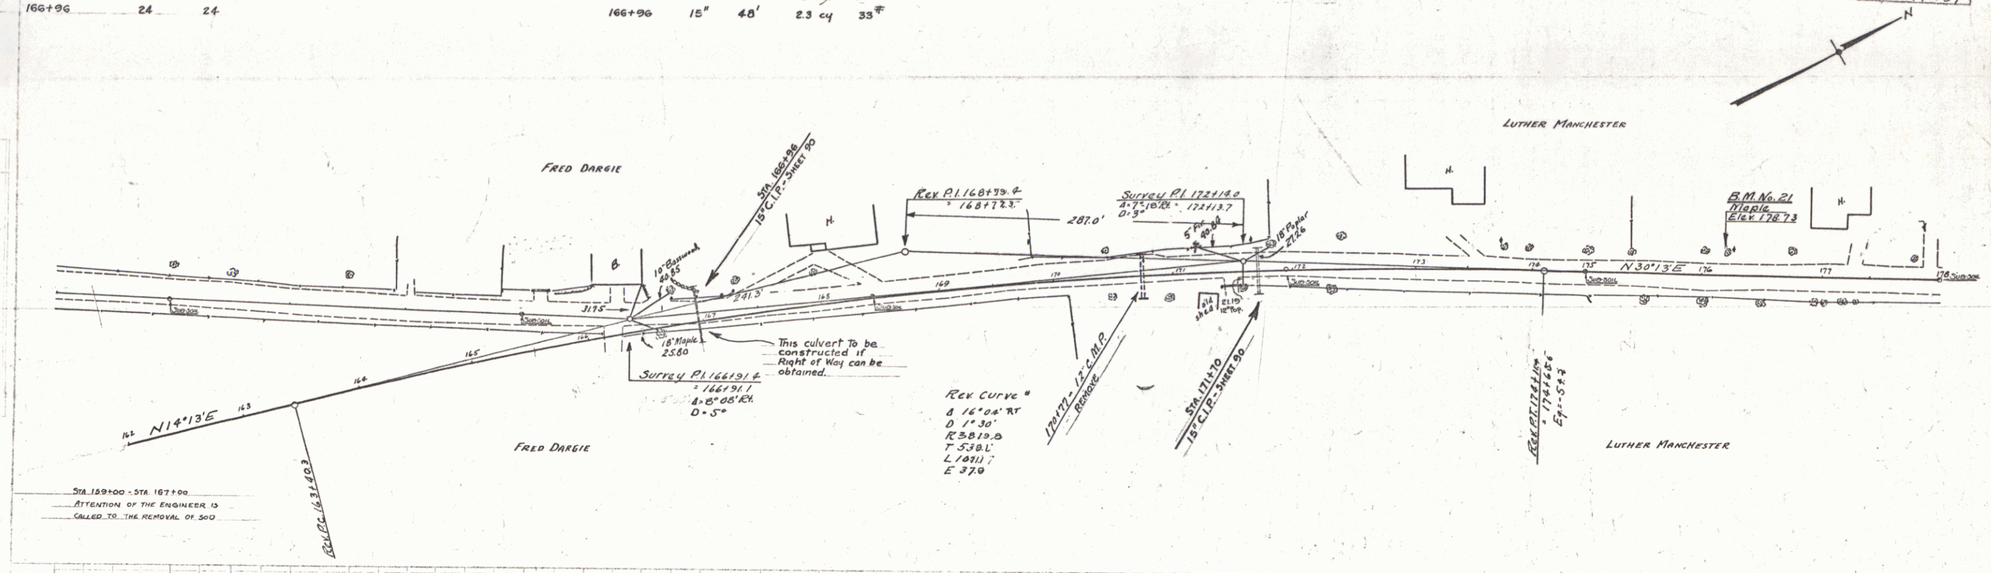

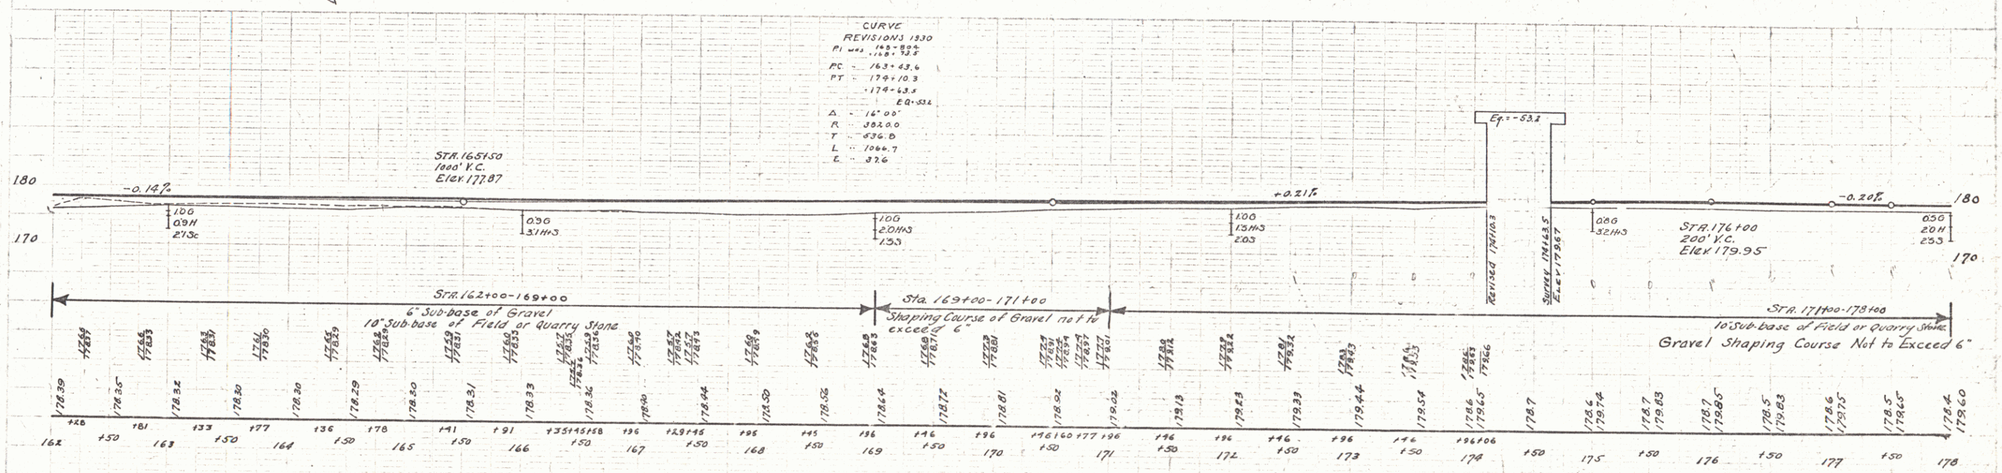

BM 21 30" Maple 18' Left Sta 176+21 Elev 178.73

SERIES F No. 74-C Sec. 2
SHEET 47 OF 97

15