


GUARD RAIL REQUIRED
LEFT
 STA 45+38 TO 45+62 LENGTH 24 FT
 51+38 - 51+62 24 -
RIGHT
 STA 44+10 TO 47+30 LENGTH 320 FT
 48+15 - 55+00 685 -
 Total This Sheet 1053 FT

NEW CULVERTS REQUIRED
 STA 45+50 15" Reinforced Conc. Pipe Culv. Leng. 35 FT.
 Conc. Class B (1-2-3) 2.7 cy
 Reinf. Steel 33 lb.
 STA 51+50 2-2' Reinforced Conc. Box Culv. Leng. 40 FT.
 Conc. Class A (1-2-4) 2.2 cy
 Reinf. Steel 757 lb.

SUB-BASE REQUIRED
 STA. 40+00-41+00 10' Base Leng. 100 FT.

PLAN	SCALE	1" = 40'
SECTION	SCALE	1" = 10'
DATE	APPROVED	
BY	DATE	
REVISIONS		
1		
2		
3		
4		
5		
6		
7		
8		
9		
10		


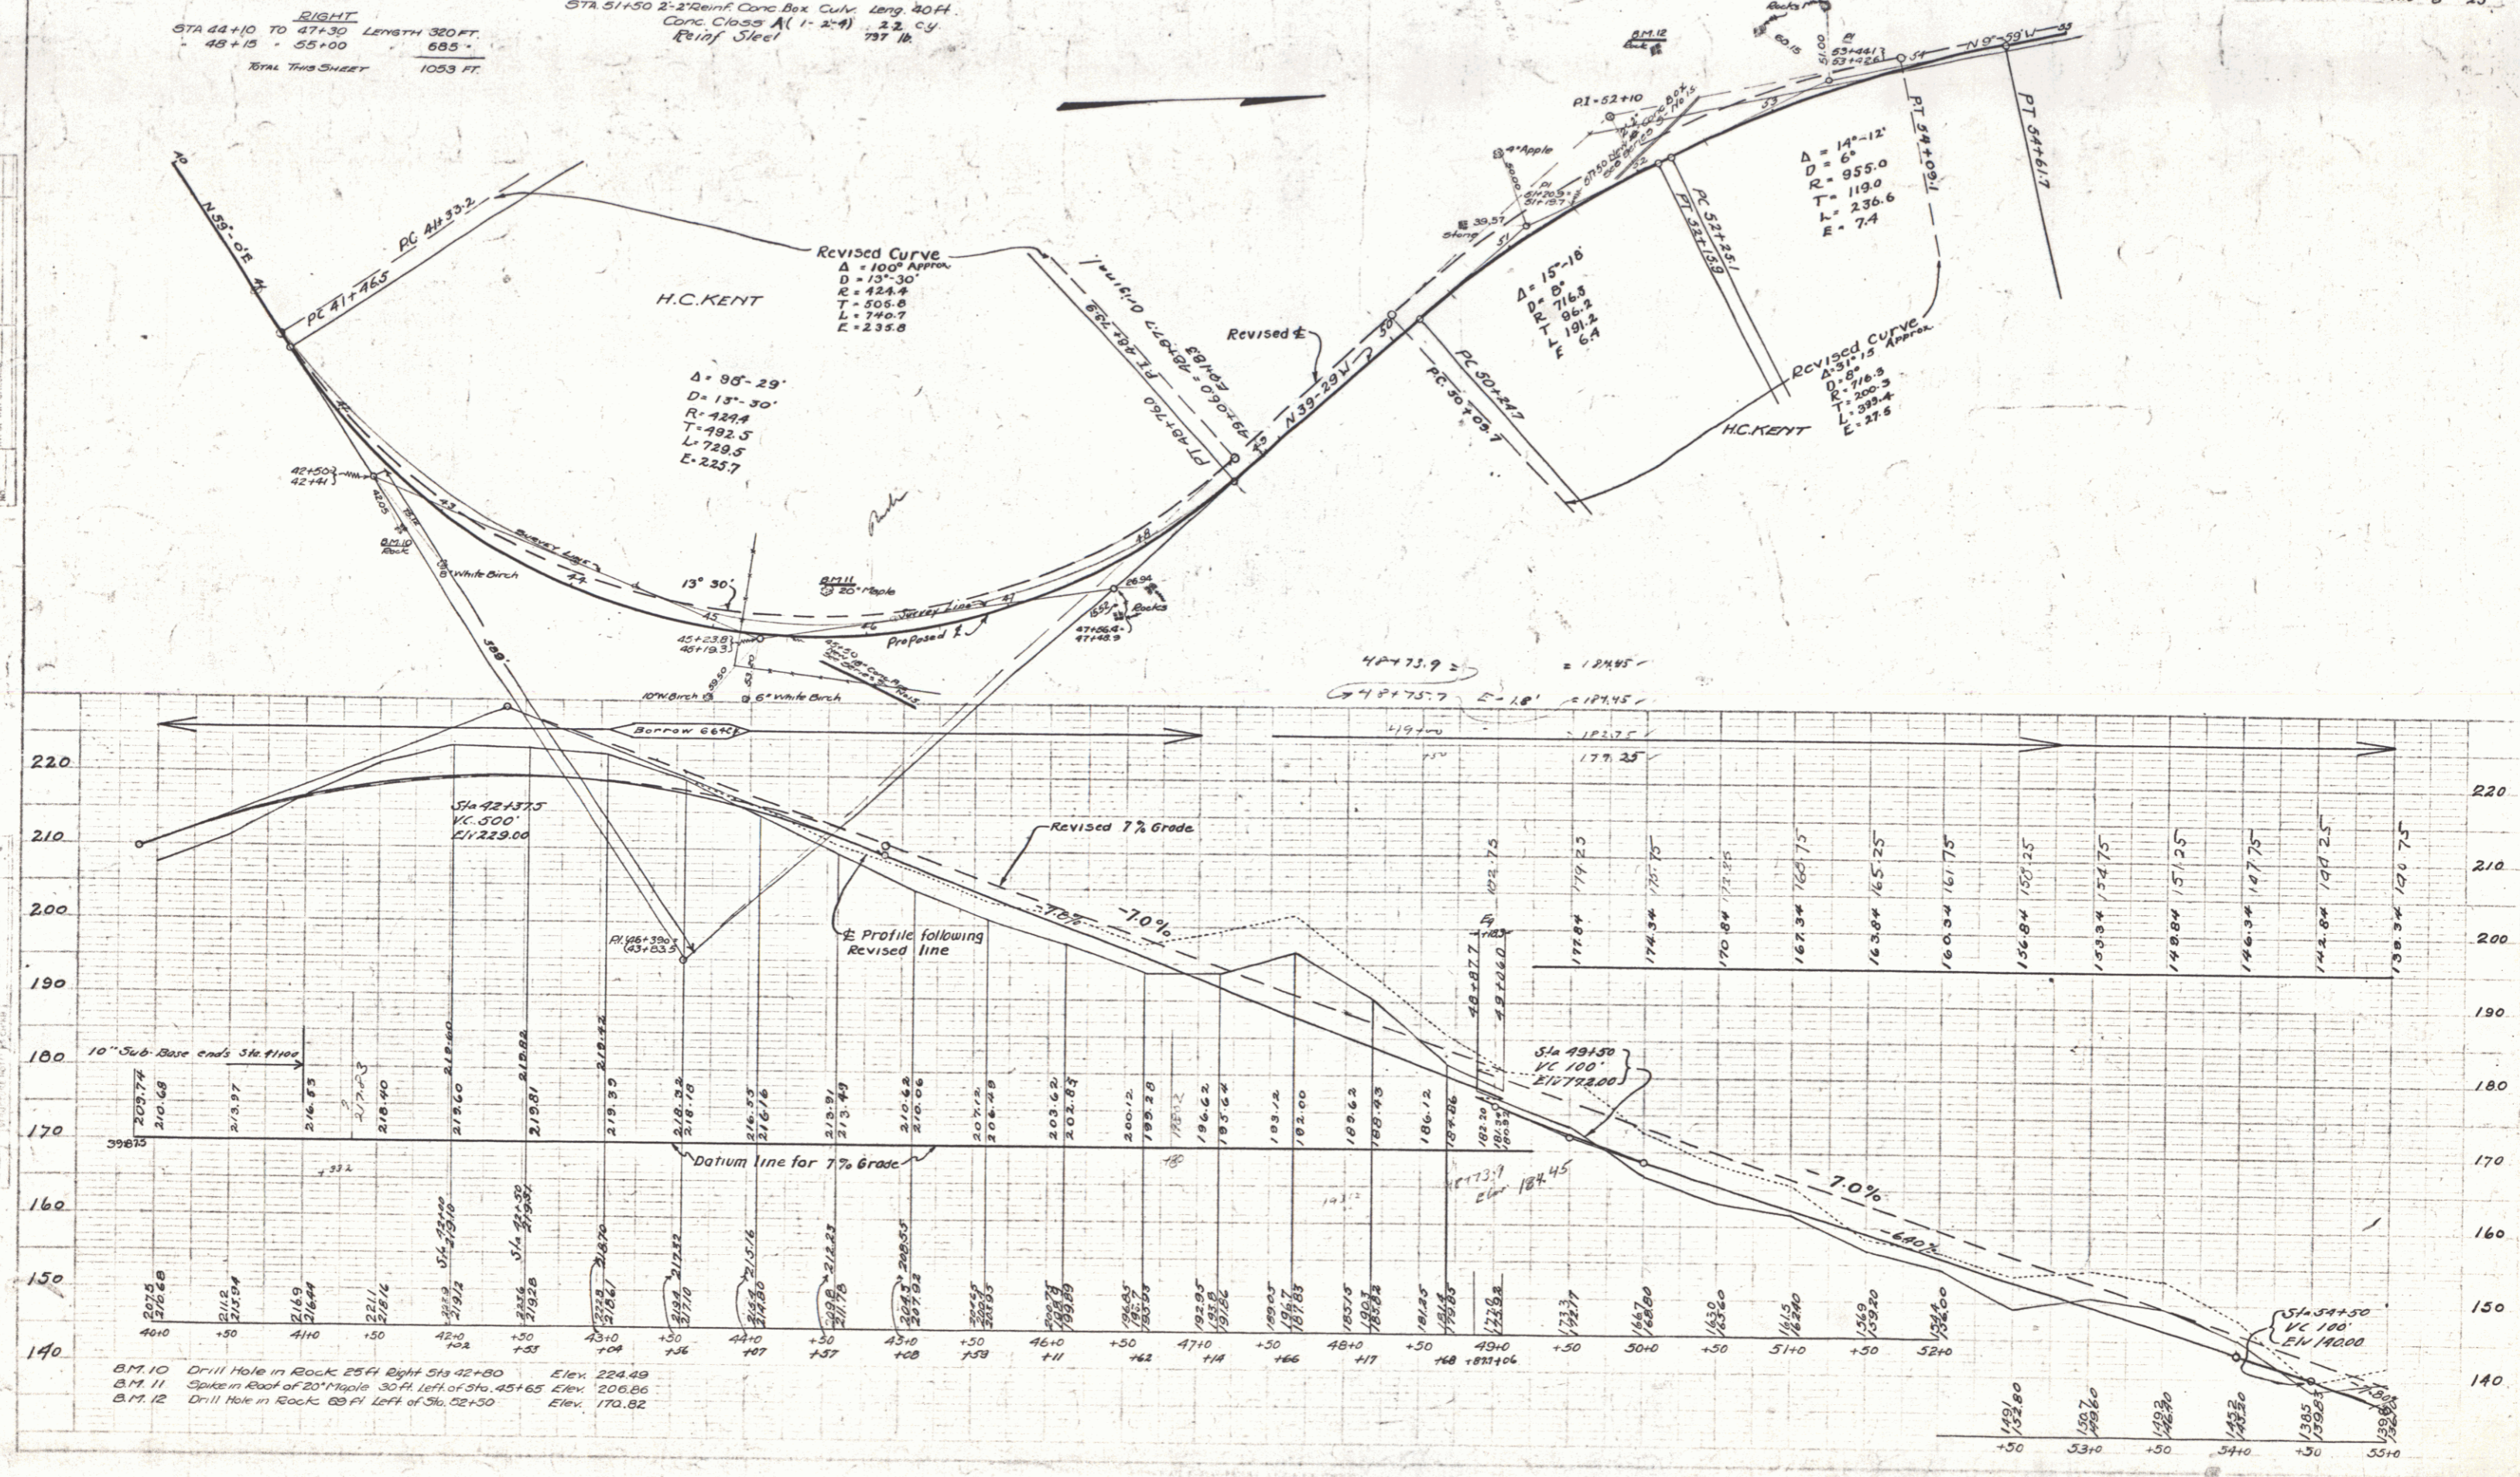

B.M. 10 Drill Hole in Rock 25' Right Sta 42+80 Elev. 224.49
