74A 1926 7 25

GUARD RAIL REQUIRED

LEFT

Sta. 55+88	to	Sta. 56+12	Length	24 ft.
" 60+88	"	" 61+12	"	24 "

RIGHT

Sta. 55+00	to	56+55	Length	155 ft.
" 58+40	"	61+20	"	280 "

TOTAL THIS SHEET 483 ft.

NEW CULVERTS REQUIRED

STA 56+00 18" Reinf. Conc. Pipe Culv. 48'
Conc. Class B (1-2½-5) 12.7 c.y.
Reinf. Steel 33 lb.

STA. 61+00 2×2 Reinf. Conc. Box Culv.
Conc. Class A (1-2-4) 108 c.y.
Reinf. Steel 708 lb.

STA. 57+30 15" Reinf. Conc. Pipe Culv. 32'
Conc. Class B (1-2½-4) 12.1 c.y.
Reinf. Steel 33 lb.

SUB-BASE REQUIRED

Sta. 58+00 - 64+00 10" Base Length 600 ft.

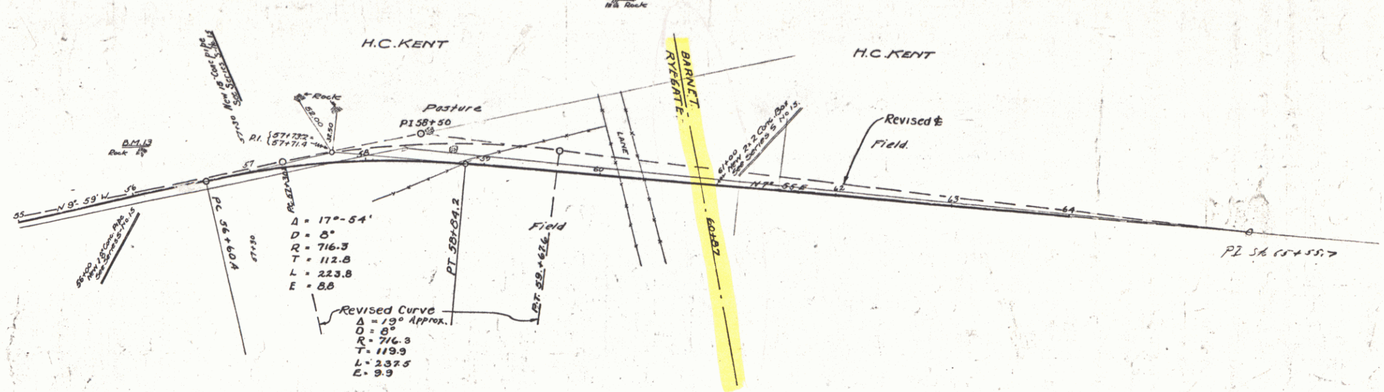

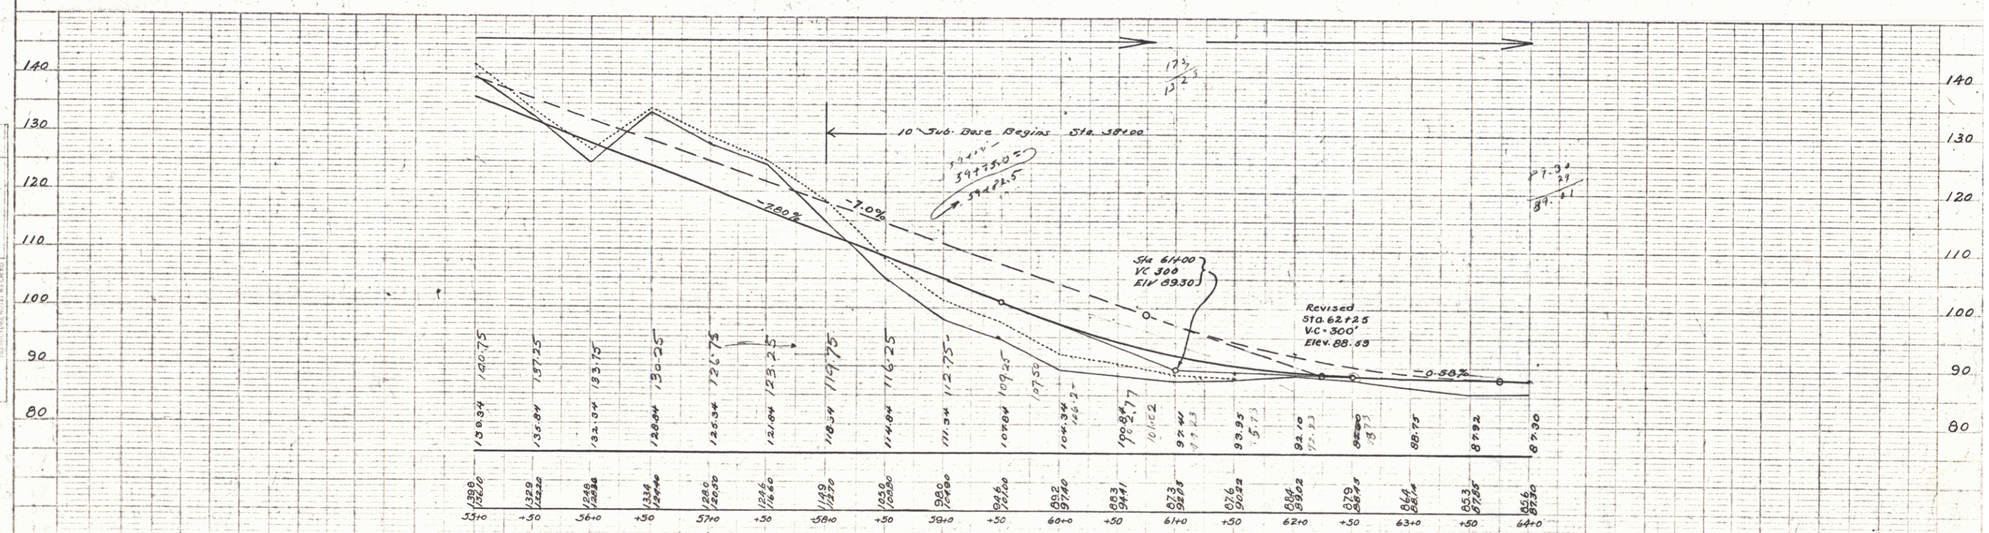

BM 13 Drill Hole in Ledge 34 ft. Left of Sta. 56+16 Elev. 126.51
BM 14 " " " 149 " " " 59+97 " 114.05

SERIES F No. 74A
SHEET 7 OF 25

14