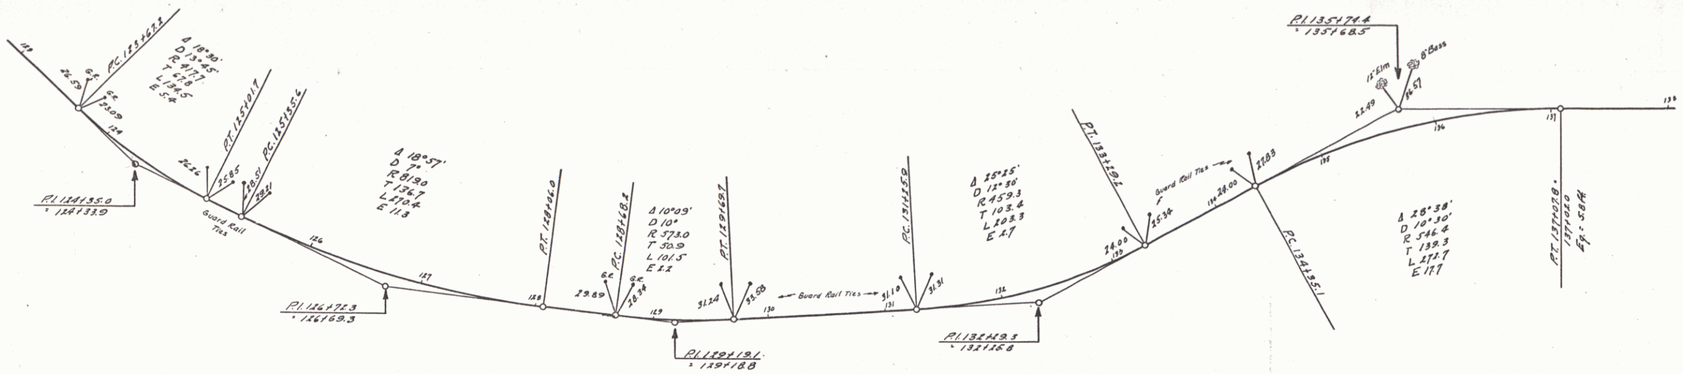

ST. JOHNSBURY - POWER HOUSE HILL

This line is the office revision of Aug. 1, 1919
Staked as shown above Aug. 5, 1919.

- All previous revisions void -

SHEET 6B

15-G

PLATE 1 PLAN-PROFILE

6