


STATE OF VERMONT TO TERESA S. HATCH
 BY QCD RECORDED 5-5-77 IN ST. JOHNSBURY,
 BOOK 157, PAGES 544 - 548

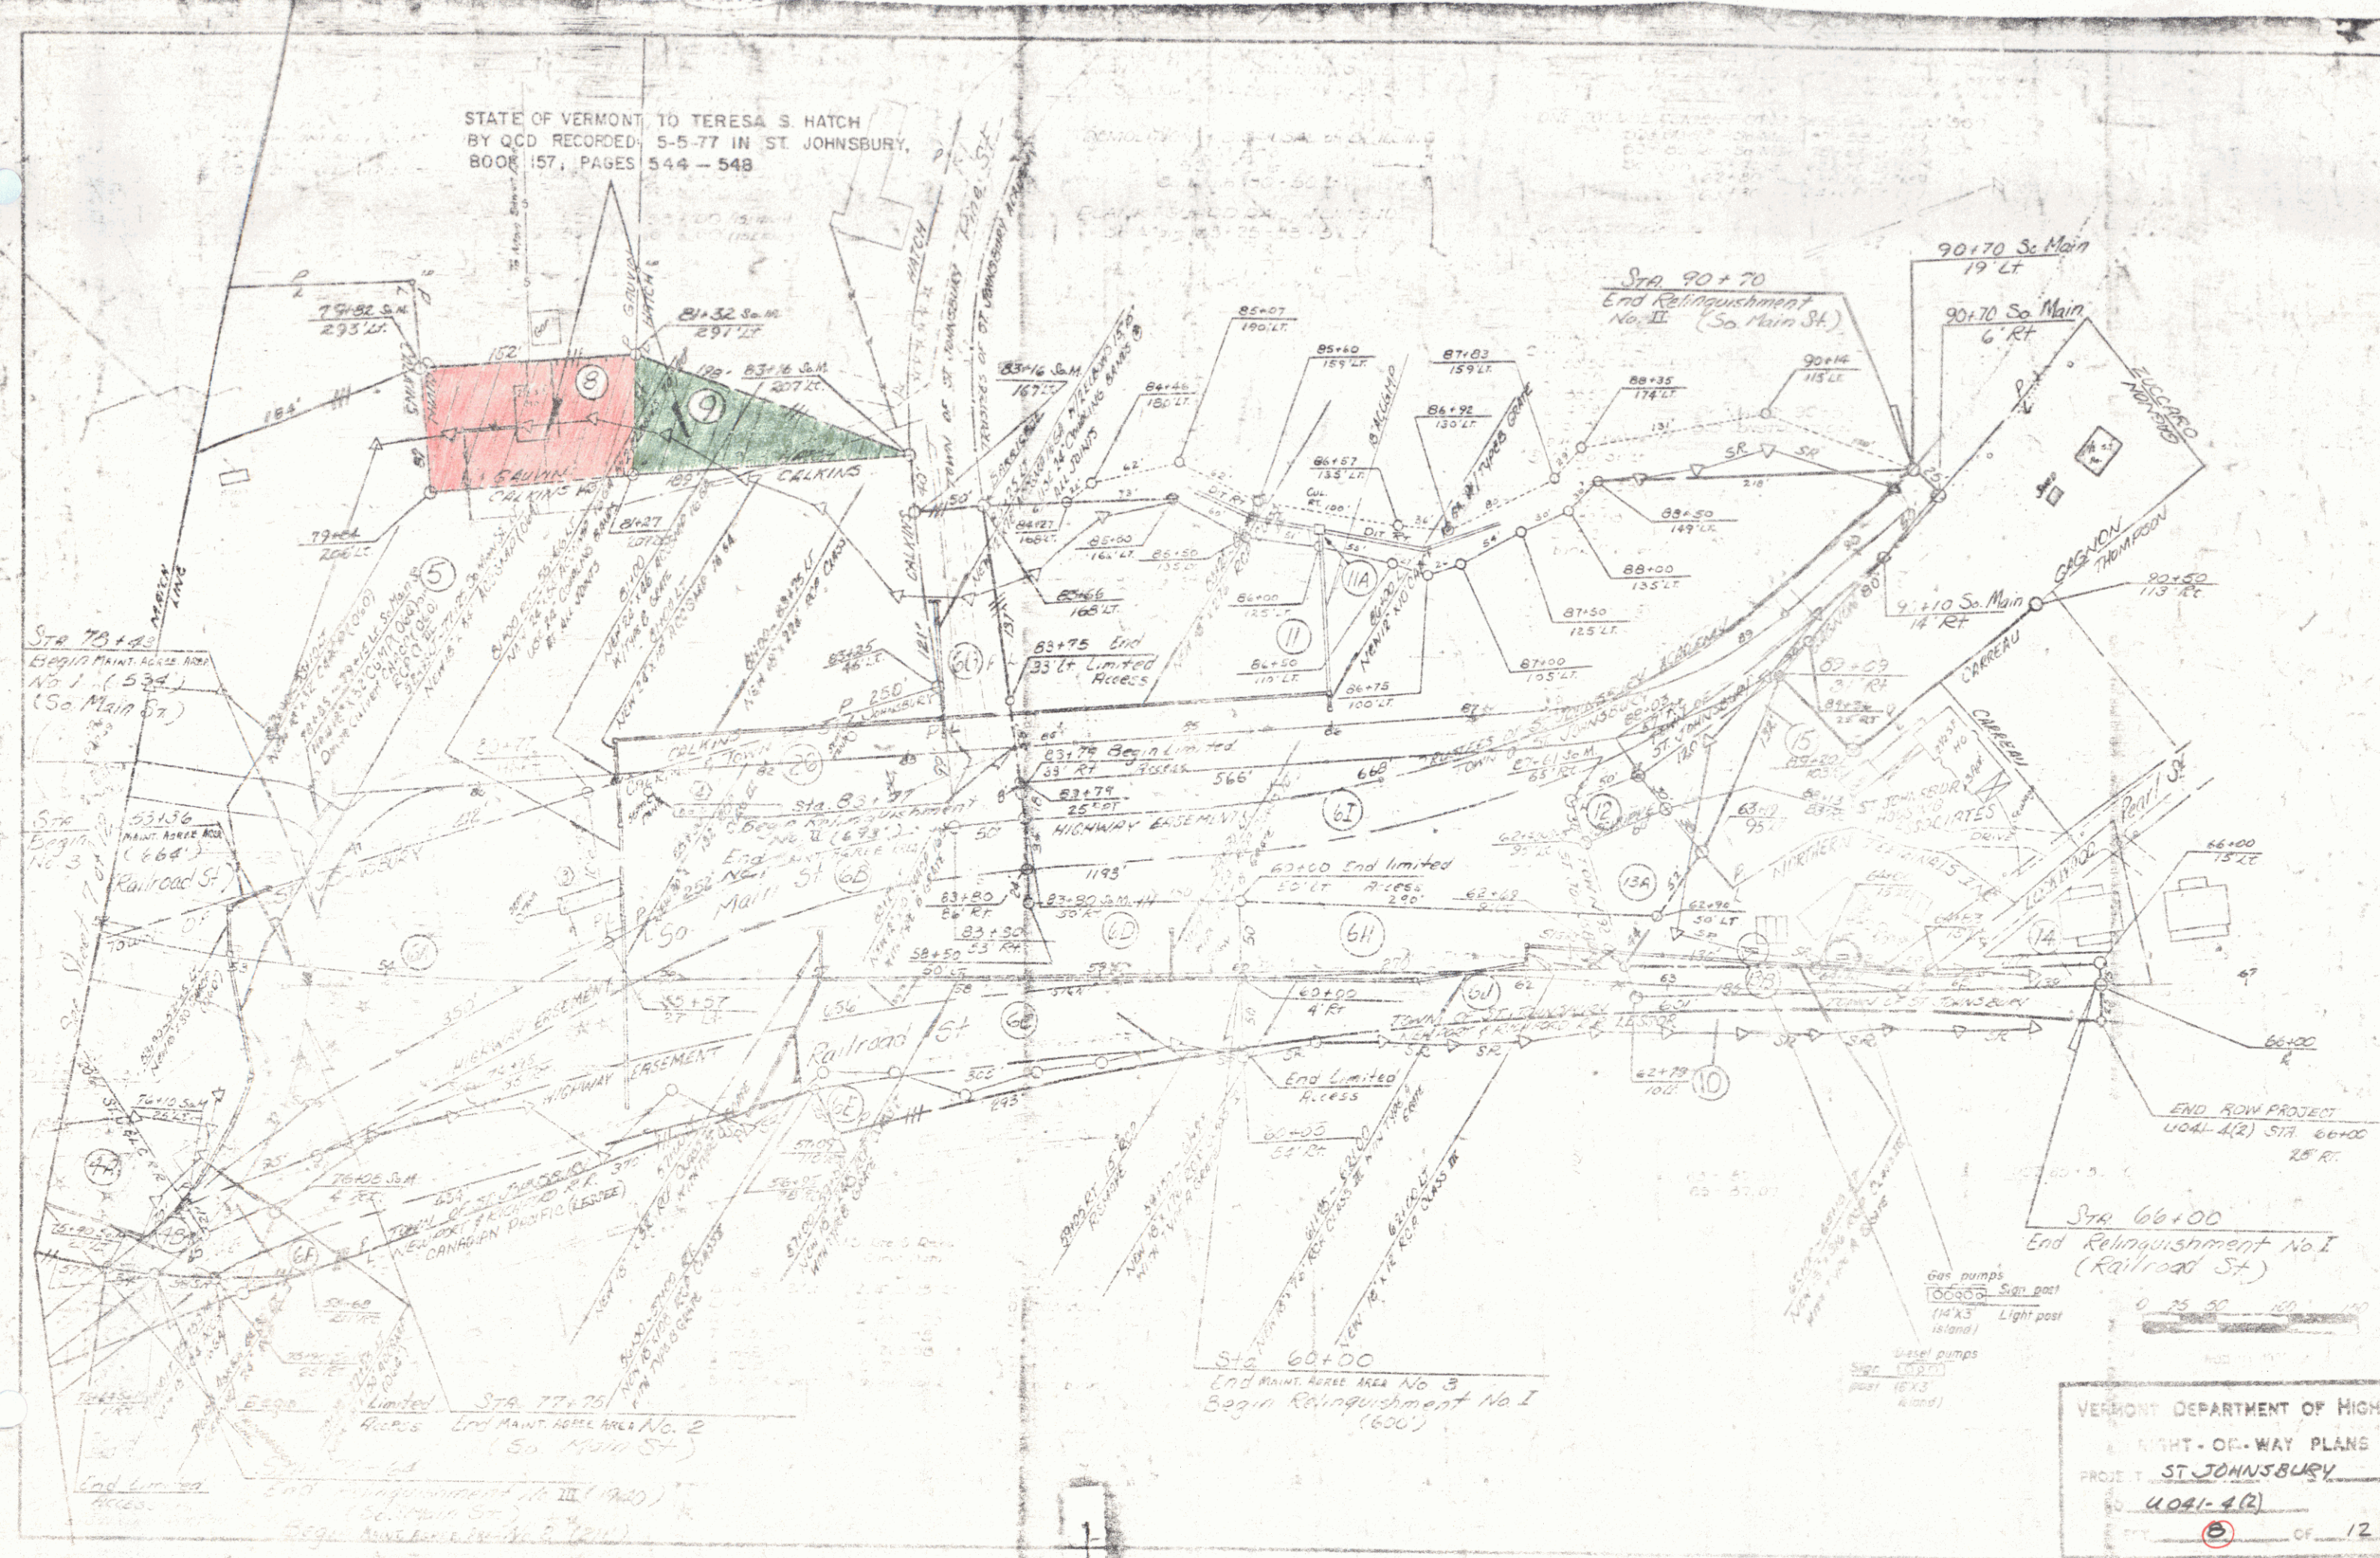

VERMONT DEPARTMENT OF HIGHWAYS
 RIGHT-OF-WAY PLANS
 PROJECT ST. JOHNSBURY
 UO-1-4(2)
 8 OF 12

6