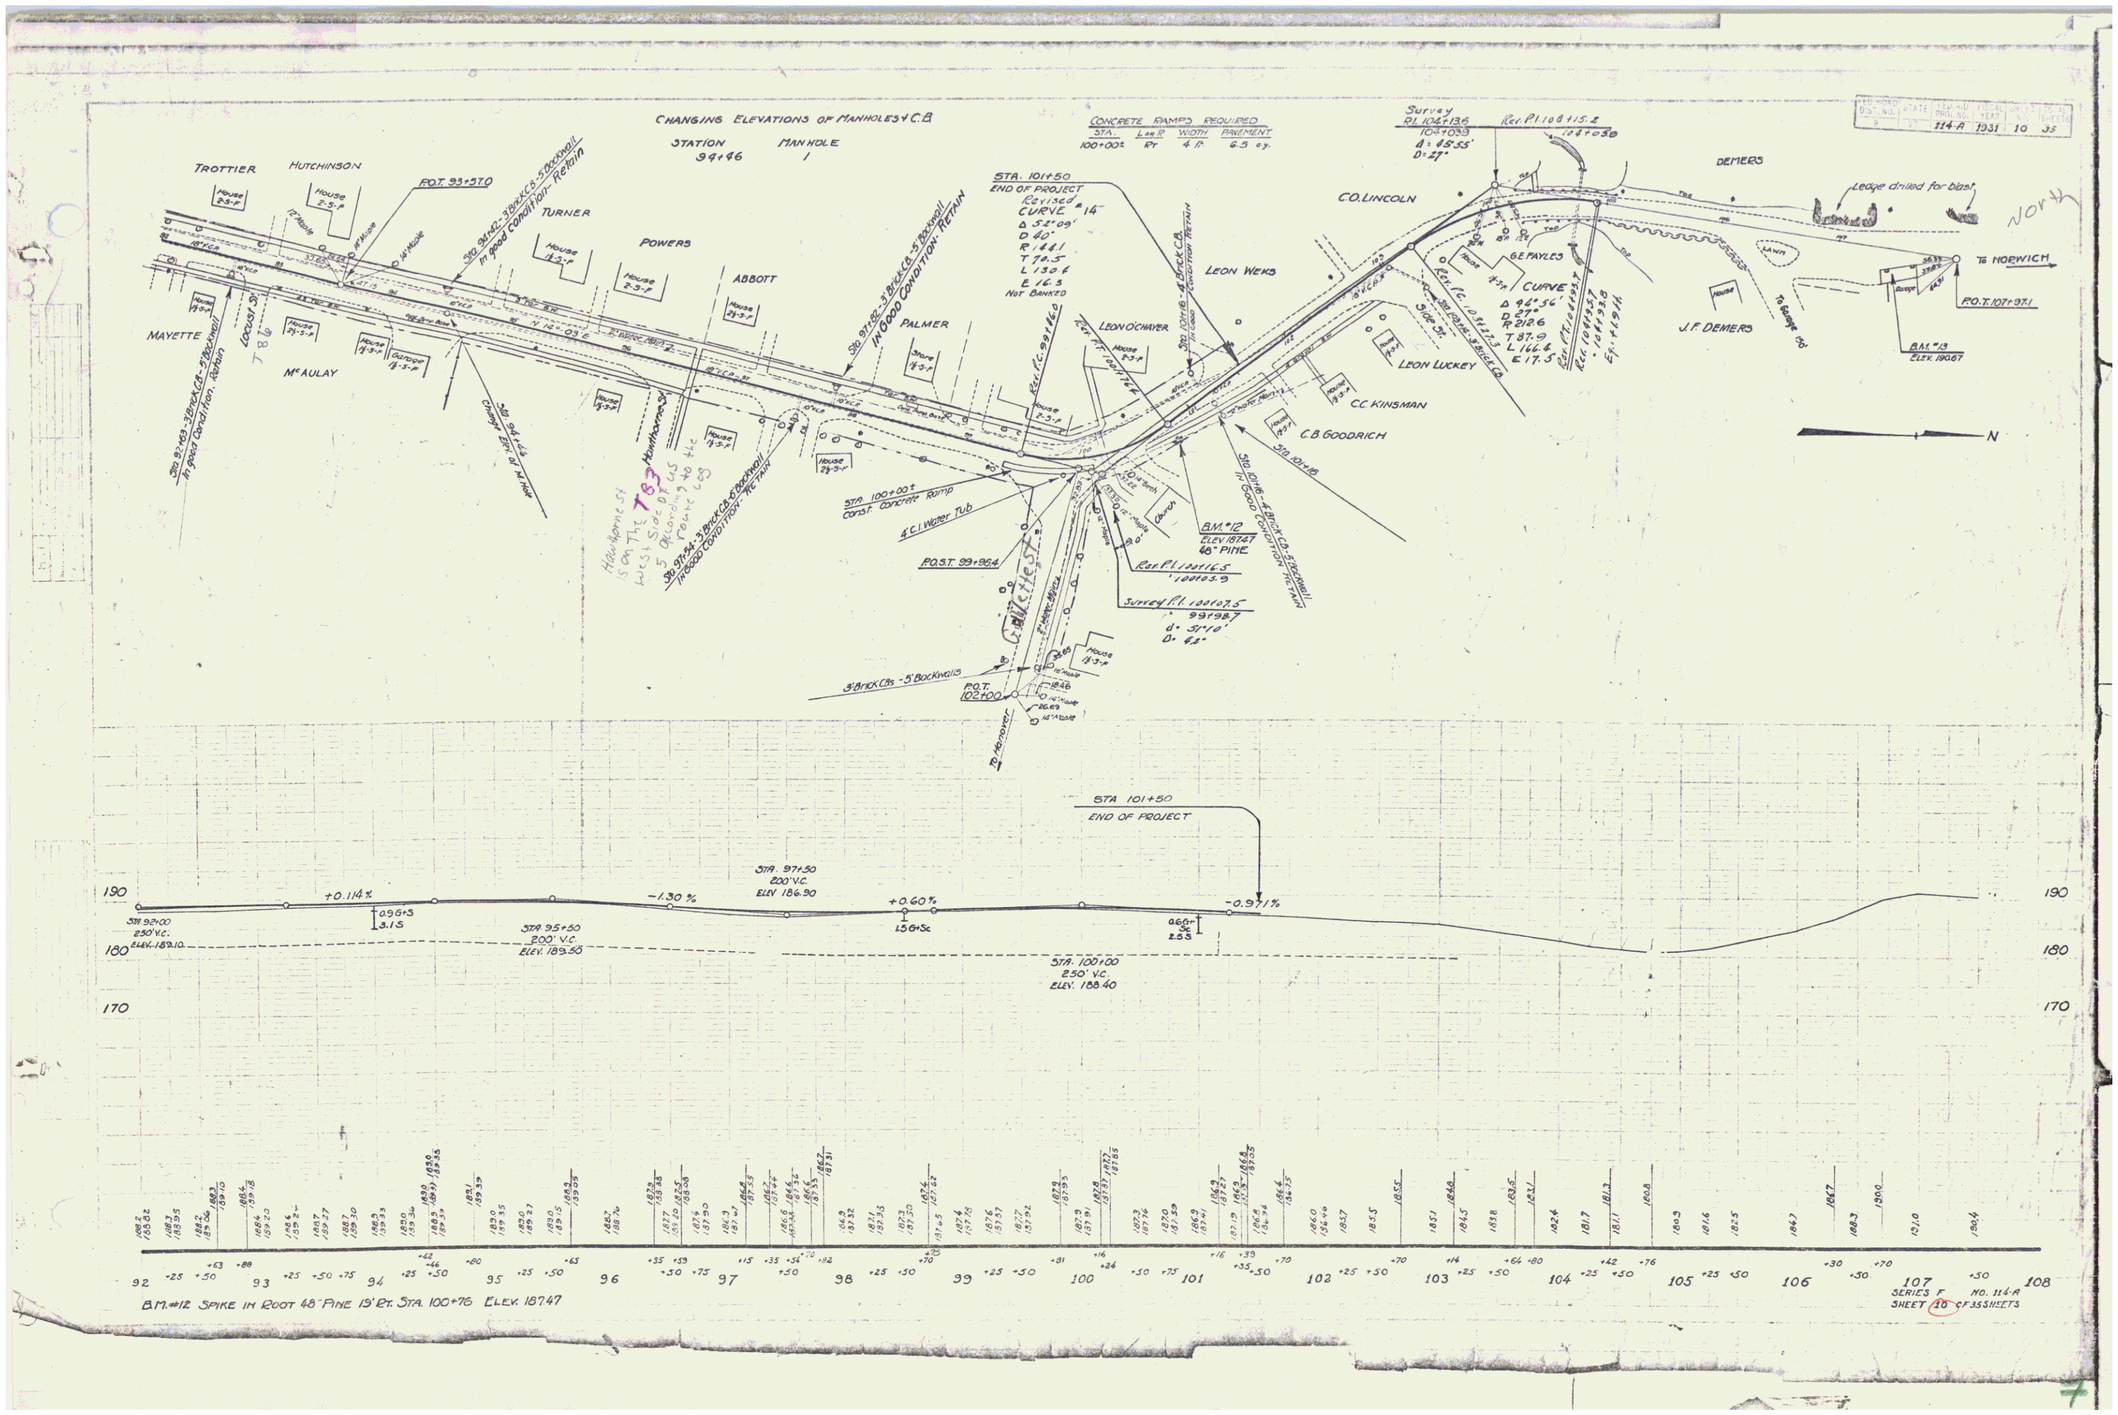
CHANGING ELEVATIONS OF MANHOLES & C.B.
STATION MANHOLE
94+46 1
CONCRETE RAMPS REQUIRED
STA. LOCATION WIDTH PAVEMENT
100+00± RT 4 ft. 6.5 cy.
TROTTIER
HUTCHINSON
TURNER
POWERS
ABBOTT
PALMER
MAYETTE
McAULAY
LEON WEKS
LEON O'CHAVER
CO. LINCOLN
DEMERS
G.E. PAYLES
J.F. DEMERS
LEON LUCKEY
C.C. KINSMAN
C.B. GOODRICH
Ledge drilled for blast
North
TO NORWICH
P.O.T. 107+97.1
B.M. #13
ELEV. 190.67
STA. 101+50
END OF PROJECT
Revised
CURVE #14
Δ 52°09'
D 40°
R 144.1
T 74.5
L 130.6
E 16.3
Not Banked
P.O.T. 93+57.0
P.O.S.T. 99+96.4
P.O.T. 102+00
STA. 100+00± Const. Concrete Ramp
4" C.I. Water Tub
B.M. #12
ELEV. 187.47
48" PINE
3" Brick Cbs - 5" Backwall
STA. 101+50
END OF PROJECT
STA. 92+00
250' V.C.
ELEV. 189.10
STA. 95+50
200' V.C.
ELEV. 189.50
STA. 97+50
200' V.C.
ELEV. 186.90
STA. 100+00
250' V.C.
ELEV. 188.40
+0.114%
-1.30%
+0.60%
-0.971%
190
180
170
B.M. #12 SPIKE IN ROOT 48" PINE 19' RT. STA. 100+76 ELEV. 187.47
SERIES F NO. 114-A
SHEET 10 OF 35 SHEETS