FED. ROAD DIST. NO.	STATE	NRM	FISCAL YEAR	SHEET NO.	TOTAL SHEETS
5	VT.	135C (933)	1935	5	22

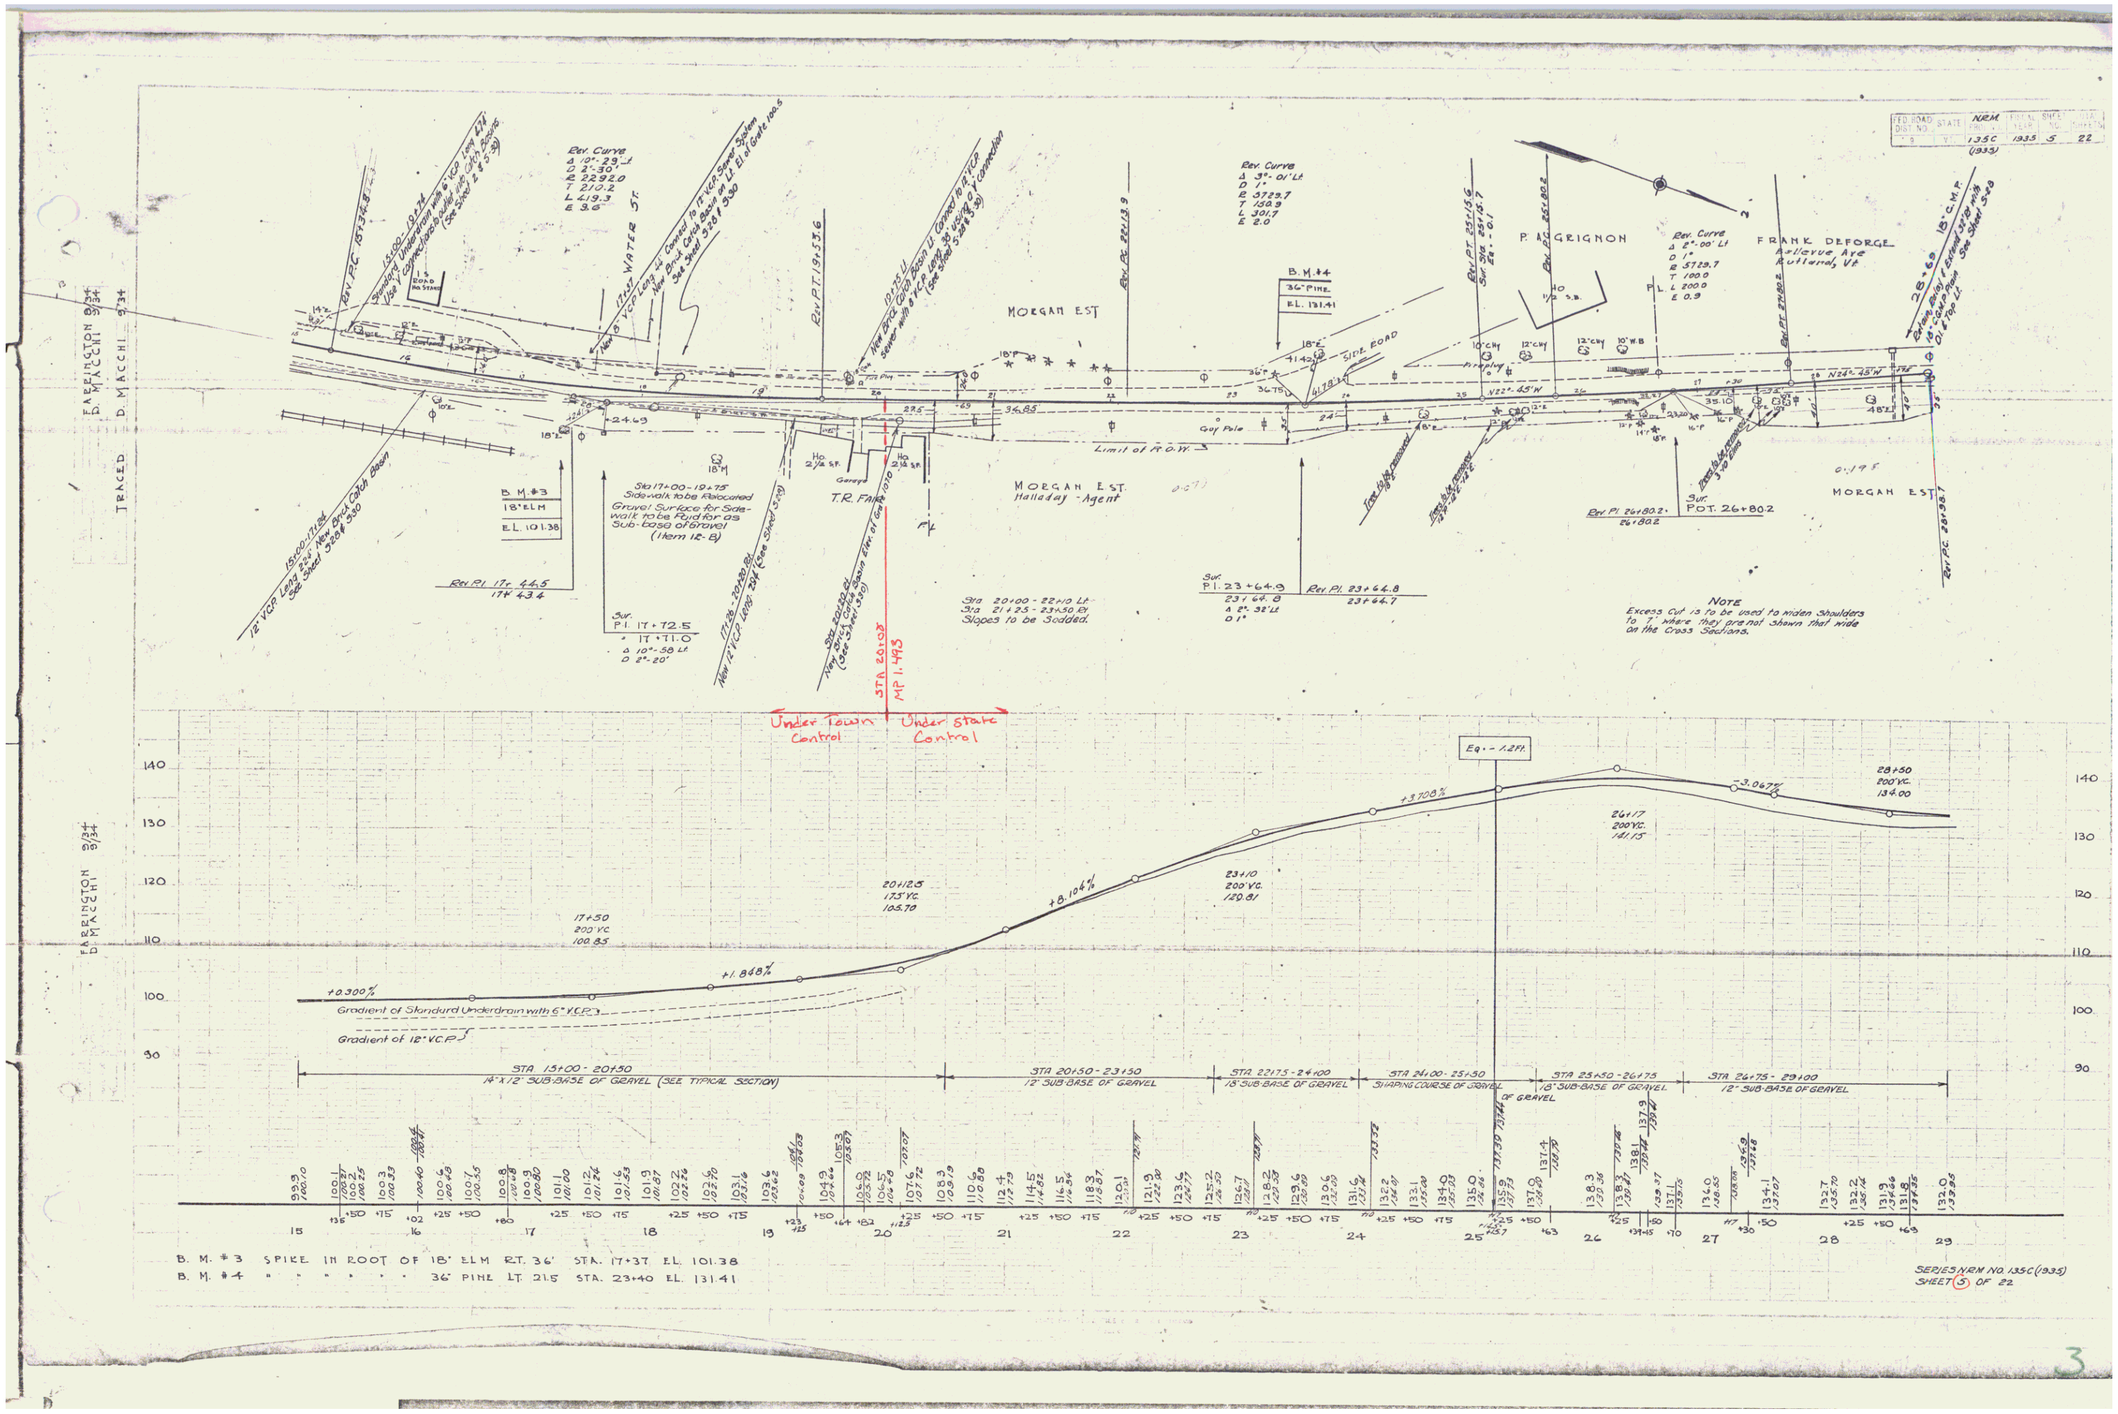

NOTE
Excess Cut is to be used to widen shoulders to 7' where they are not shown that wide on the Cross Sections.

3