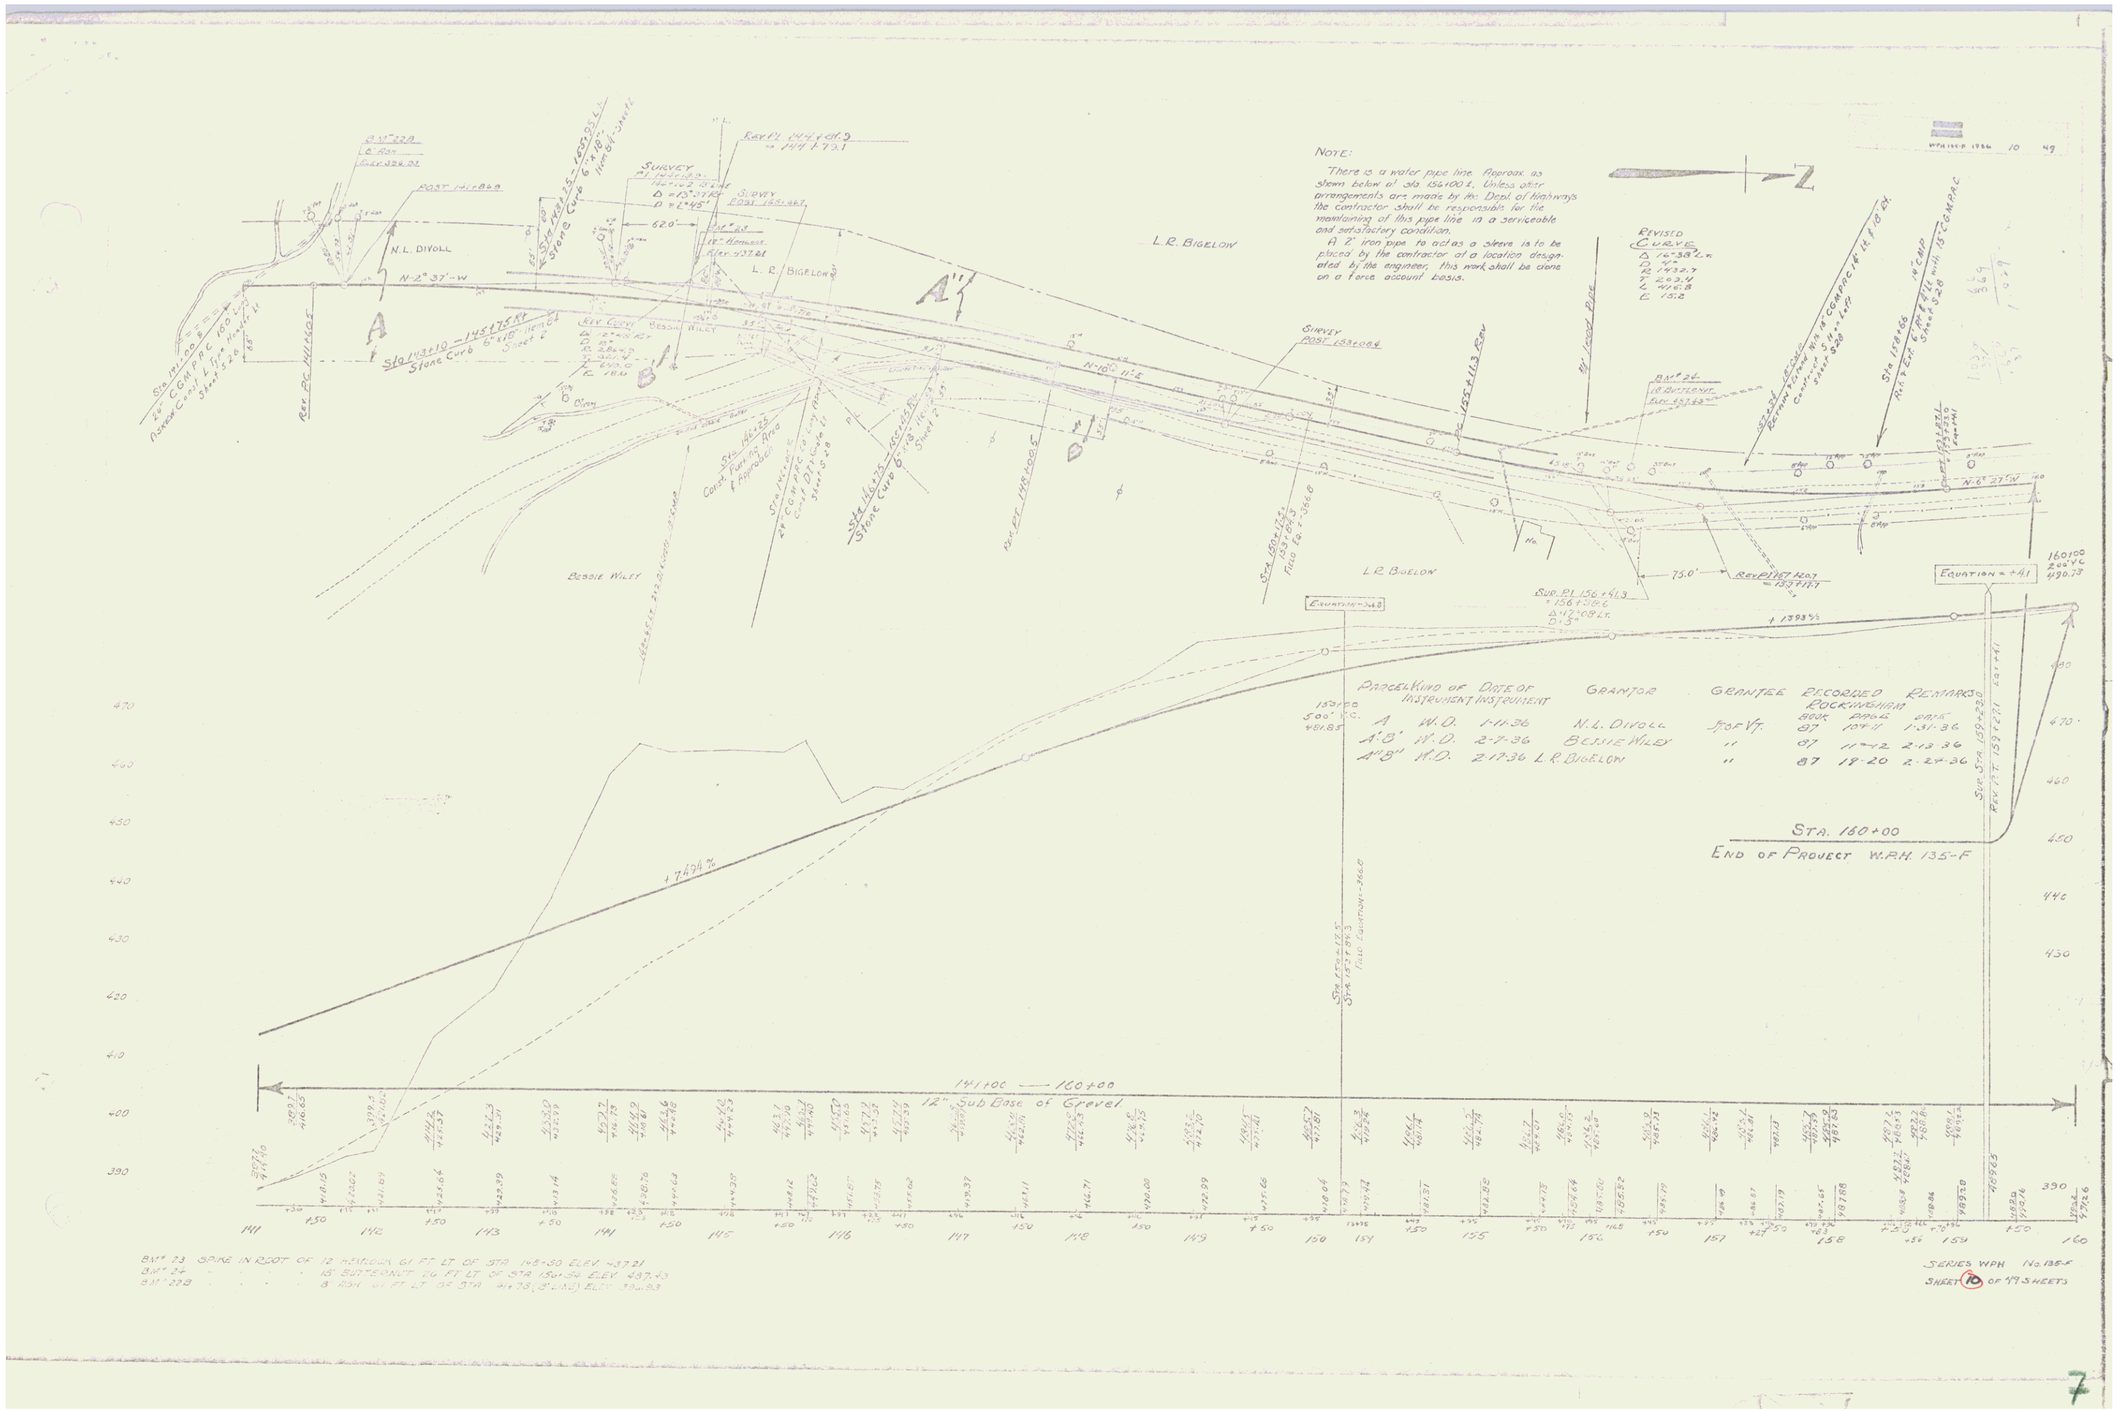
NOTE:
There is a water pipe line. Approx. as shown below at Sta 156+00 ±. Unless other arrangements are made by the Dept. of Highways the contractor shall be responsible for the maintaining of this pipe line in a serviceable and satisfactory condition.
At 2" iron pipe to atlas, a sleeve is to be placed by the contractor at a location designated by the engineer, this work shall be done on a force account basis.
N.L. DIVOLL
L.R. BIGELOW
BESSIE WILEY
N-2° 37'-W
N-6° 37'-W
N-16° 11'-E
Sta 143+10 — 145+75 Rt
Stone Curb
Sta 139+66
Rt. Edge of Pavement
Sta 160+00
End of Project W.R.M. 135-F
141+00 —— 160+00
12" Sub Base of Gravel
+7.494%
Equation = +41
Equation = +48
Revised Curve
Parcel Kind of Instrument Date of Instrument Grantor Grantee Recorded Rockingham Book Page Date
A W.D. 1-11-36 N.L. Divoll
A'B' W.D. 2-7-36 Bessie Wiley
A"B" W.D. 2-17-36 L.R. Bigelow
Series WRM No. 136-F
Sheet 10 of 49 Sheets