NOTE: The attention of the contractor is directed to the location of a water pipe crossing the roadway at approximately Sta 192+75. The contractor will be held responsible for any damage to said water pipe, either at its present location or if relaid by its property owner at its new location, occasioned by the construction of the project under this contract.

NOTE: The attention of the Contractor is called to the Spring located northerly from Sta 192+75. He shall take proper precautions during construction to avoid damage to the spring as it is necessary that the flow from the spring to the houses be maintained during construction. The contractor will be held liable for all damage done by occasion of his construction, to the spring from the beginning of construction to the satisfactory completion of the Contract.

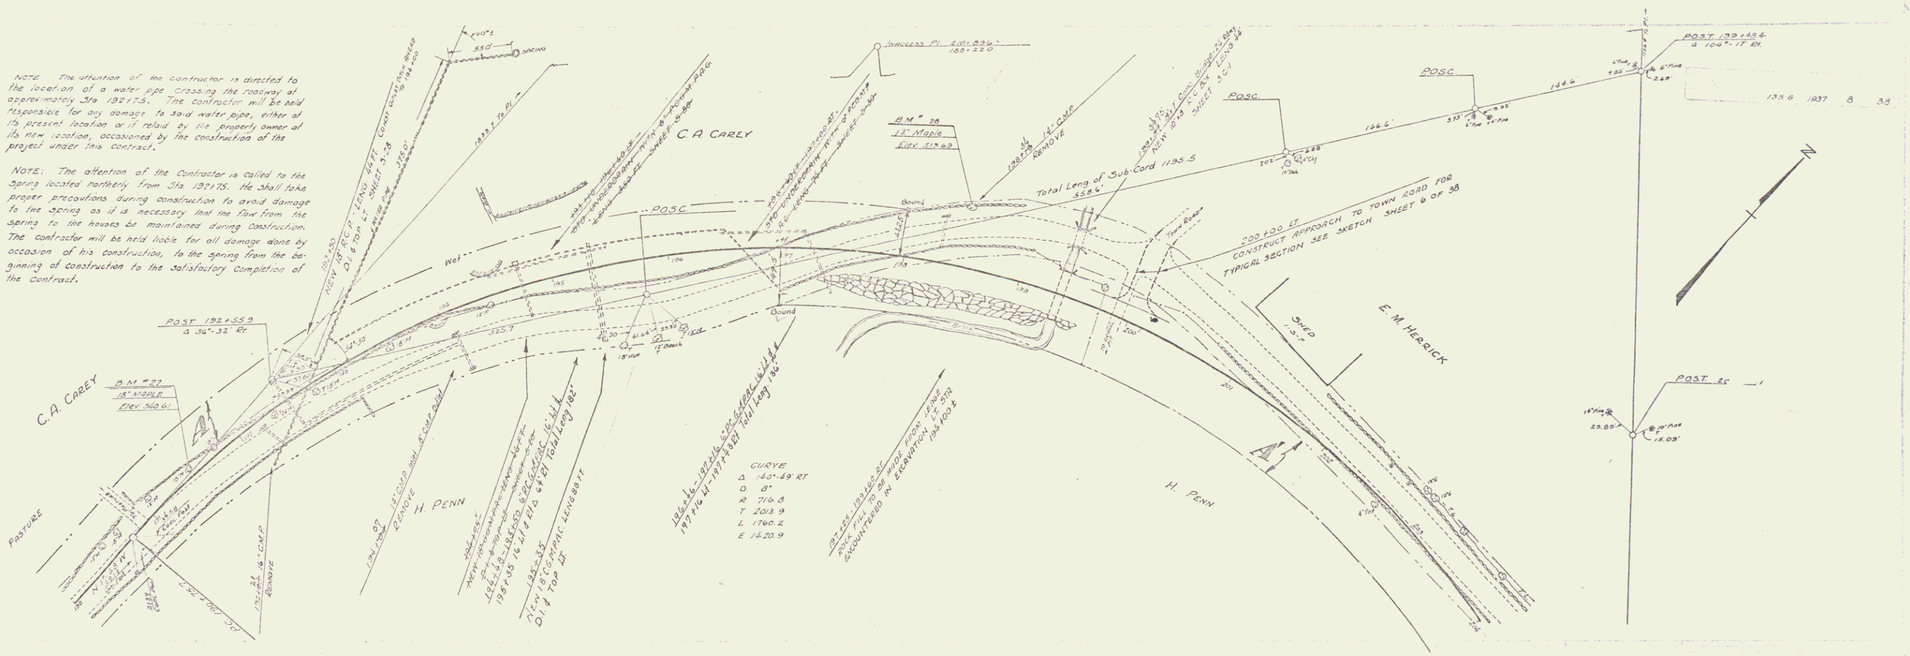

PARCEL	INSTRUMENT	DATE	GRANTOR	GRANTEE	RECORDED BOOK	RECORDED PAGE	RECORDED DATE	REMARKS
A	Q.C.D.	4-29-37	C.A. CAREY	St. of Vt.	75	340	5-1-37	
A'	W.D.	5-6-37	HIRAM A. PENN	"	87	186	5-6-37	

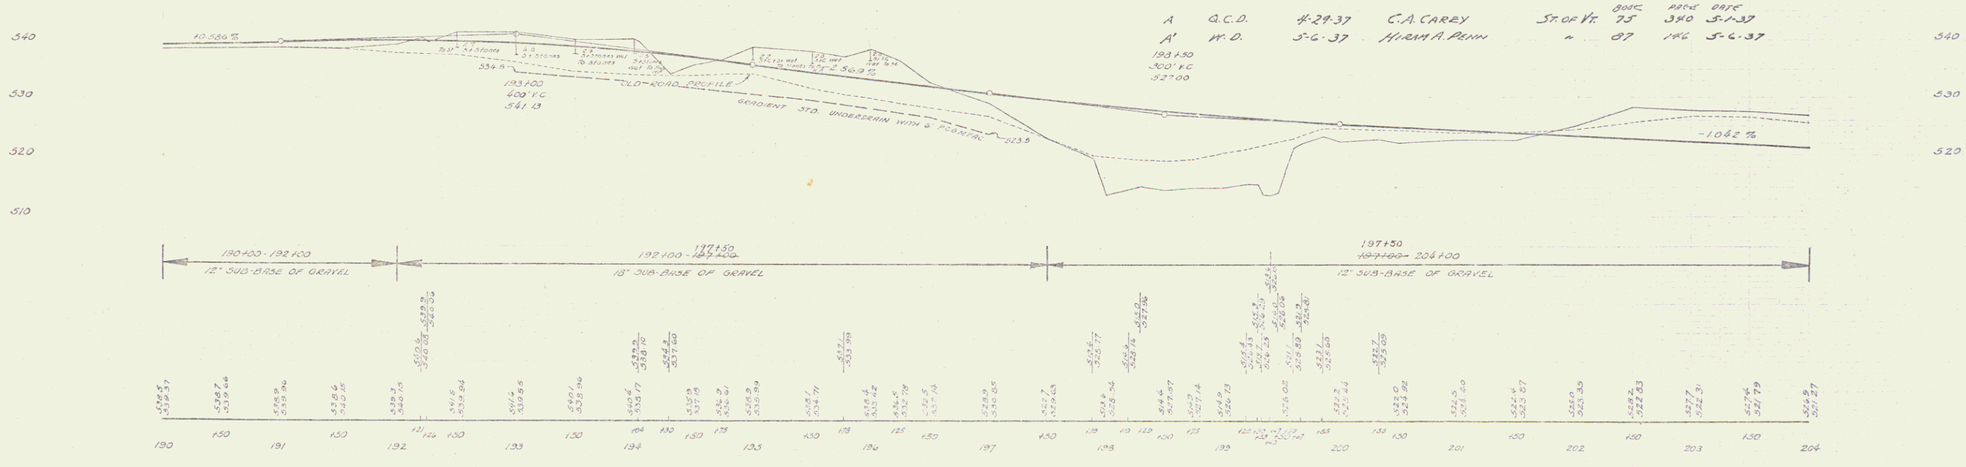

B.M. #27 SPIKE IN ROOT OF 18" MAPLE 5' LT STA 191+50 ELEV 540.61
B.M. #23 " " " " 12" " 50' " " 193+46 ELEV 519.69

SERIES F.A.P. NO 135-A
SHEET 6 OF 38

6