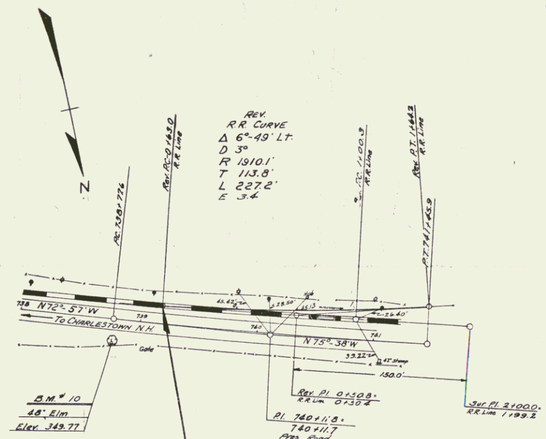

SPRINGFIELD
RAILROAD LINE
SERIES F.A.P. No. 135 H (1)
SHEET (12) OF 76

7