FED. ROAD DIST. NO.	STATE	FED. AID PROJ. NO.	FISCAL YEAR	SHEET NO.	TOTAL SHEETS
5	VT	83-B	1928	12	78

WOOD GUARD RAIL REQUIRED

ON RIGHT
Sta. 145+21 to Sta. 145+45 24 lin. ft.

ON LEFT
Sta. 145+21 to Sta. 145+45 24 lin. ft.

CABLE GUARD RAIL REQUIRED

ON RIGHT
Sta. 134+00 to Sta. 135+06 106 lin. ft.
" 141+13 " " 144+01 288 " "

ON LEFT
Sta. 134+00 to Sta. 134+02 2 lin. ft.
" 141+13 " " 143+29 216 " "

NEW CULVERTS REQUIRED

Sta. 141+25, 16" Cast Iron Pipe Culv. 48 lin. ft.
Conc. Class B (1-2½-5) 2.7 cu. yds.
Reinforcing Steel 33 lbs.

Sta. 142+85 24" Cast Iron Pipe Culv. 48 lin. ft.
Conc. Class A (1-2-4) 2.6 cu. yds.
Reinforcing Steel 54 lbs.

Sta. 145+33± 18" Cast Iron Pipe Culv. (with Drop Inlet) 38 lin. ft.
Conc. Class A (1-2-4) 1.5 cu. yds.
" " B (1-2½-5) 1.5 " "
Reinforcing Steel 112 lbs.

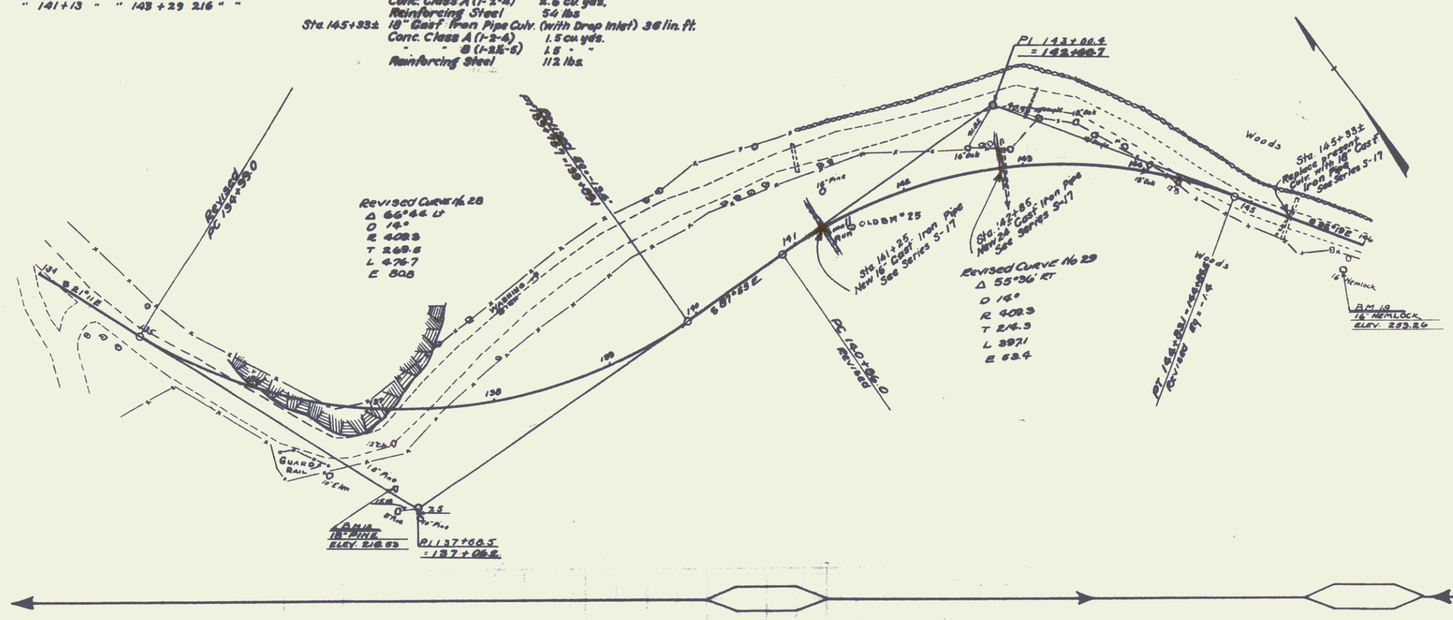

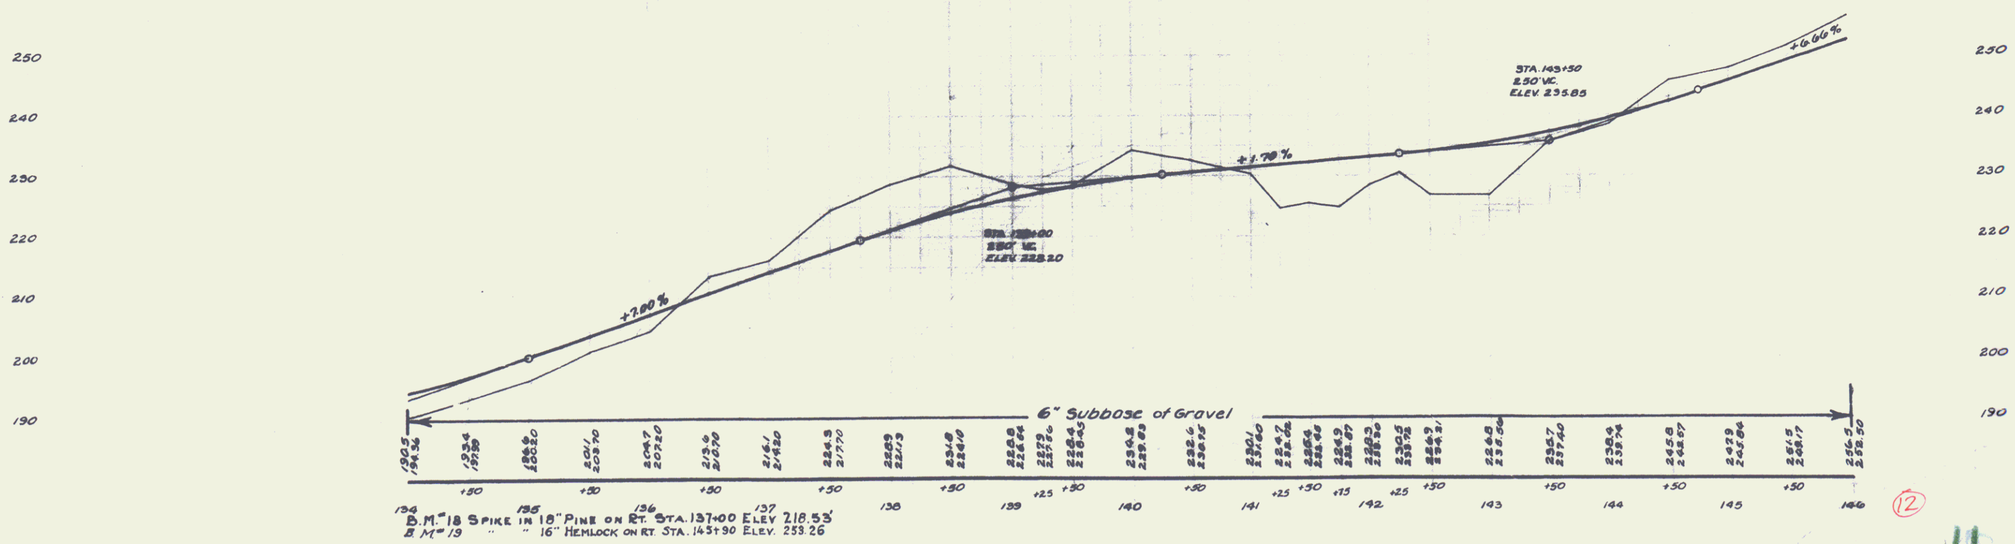

B.M. 18 Spike in 18" Pine on Rt. Sta. 137+00 Elev. 218.53'
B.M. 19 " " 16" Hemlock on Rt. Sta. 143+90 Elev. 253.26

12

11