FED. AID PROJ. NO.	FISCAL YEAR	SHEET NO.	TOTAL SHEETS
83-B	1968	14	76

WOOD GUARD RAIL REQUIRED

ON LEFT

Sta. 166+03 to Sta. 166+27 24 lin. ft.
" 170+13 " " 170+37 24 " "
" 173+88 " " 174+12 24 " "

ON RIGHT

Sta. 170+13 to Sta. 170+37 24 lin. ft.
" 173+88 " " 174+12 24 " "

CABLE GUARD RAIL REQUIRED

ON RIGHT

Sta. 161+00 to Sta. 161+90 90 lin. ft.
" 162+75 " " 166+75 400 " "

NEW CULVERTS REQUIRED

Sta. 166+12 16" Cast Iron Pipe Culv. 40 lin. ft.
Concrete Class B (1-2½-5) 2.7 cu. yds.
Reinforcing Steel 33 lbs
Sta. 170+25 18" Cast Iron. Pipe Culv. 32 lin. ft.
Concrete Class B (1-2½-5) 3.1 cu. yds.
Reinforcing Steel 33 lbs
Sta. 174+00± 24" Cast Iron. Pipe Culv. 40 lin. ft.
Concrete Class A (1-2-4) 2.6 cu. yds.
Reinforcing Steel 54 lbs

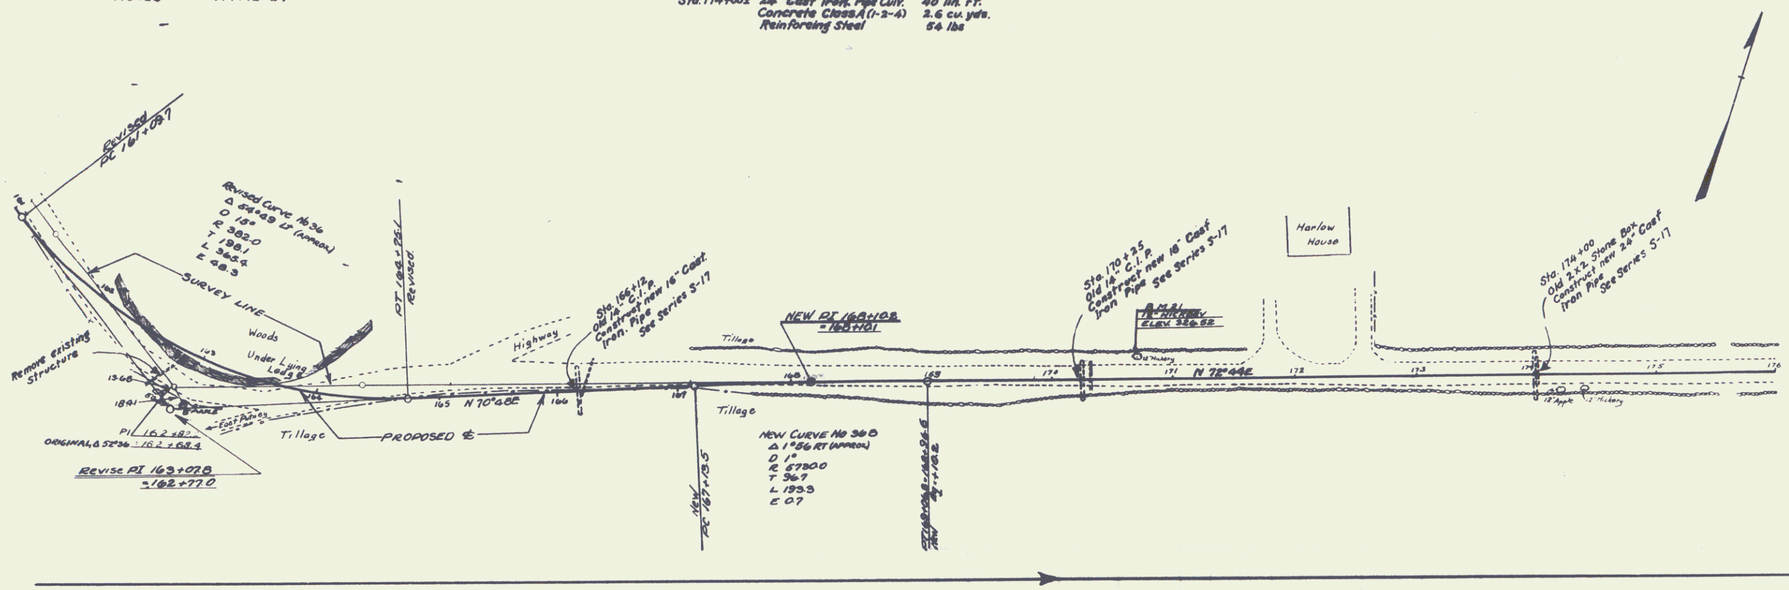

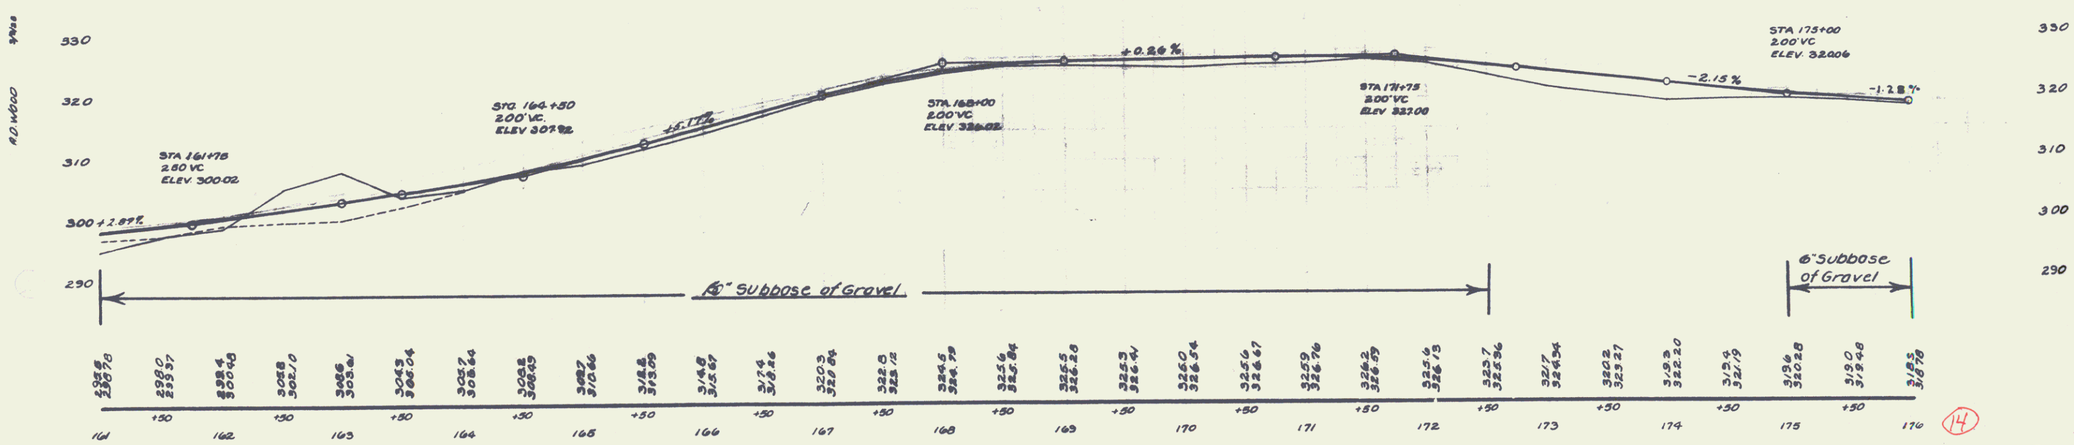

B.M. #21 Spike in 12" Hickory on Lt. Sta. 170+65, Elev 326.52'

14

13