STATE	F.S.D. AND PROJ. NO.	FISCAL YEAR	SHEET NO.	TOTAL SHEETS
VT.	185-8	1966	20	76

WOOD GUARD RAIL REQUIRED

ON RIGHT

Sta. 259+88 to Sta. 260+12 24 lin. ft.
" 261+53 " " 261+77 24 " "

ON LEFT

Sta. 259+88 to Sta. 260+12 24 lin. ft.
" 261+53 " " 261+77 24 " "

NEW CULVERTS REQUIRED

Sta. 259+88± 18" Cast Iron Pipe Culv. 48 lin. ft.
Conc. Class B (1-2½-5) 3.1 cu. yds
Reinforcing Steel 33 lbs

Sta. 261+65± 18" Cast Iron Pipe Culv. 40 lin. ft.
Conc. Class B (1-2½-5) 3.1 cu. yds
Reinforcing Steel 33 lbs

DRIVEWAY CULVERTS REQUIRED

ON LEFT

Sta. 257+50 16" Corr. Iron Pipe 16 lin. ft.
Conc. Class B (1-2½-5) 1 cu. yd.

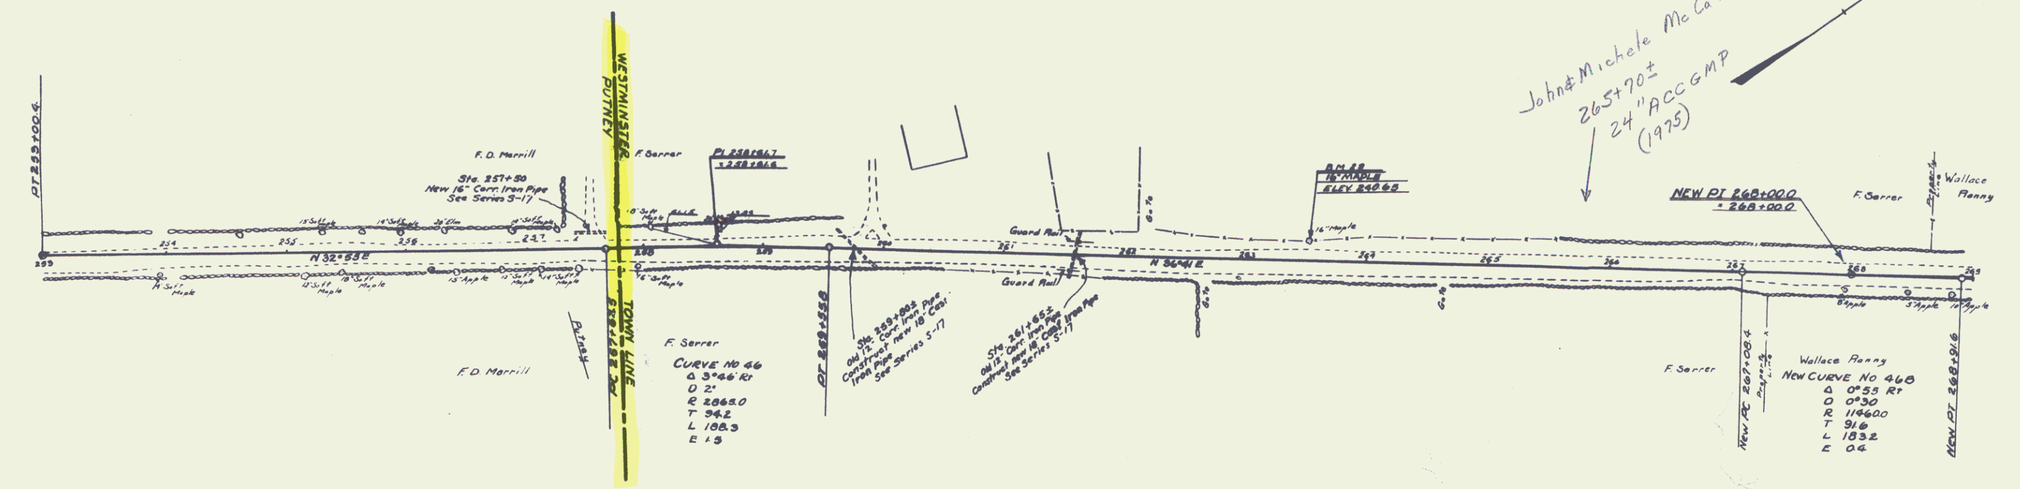

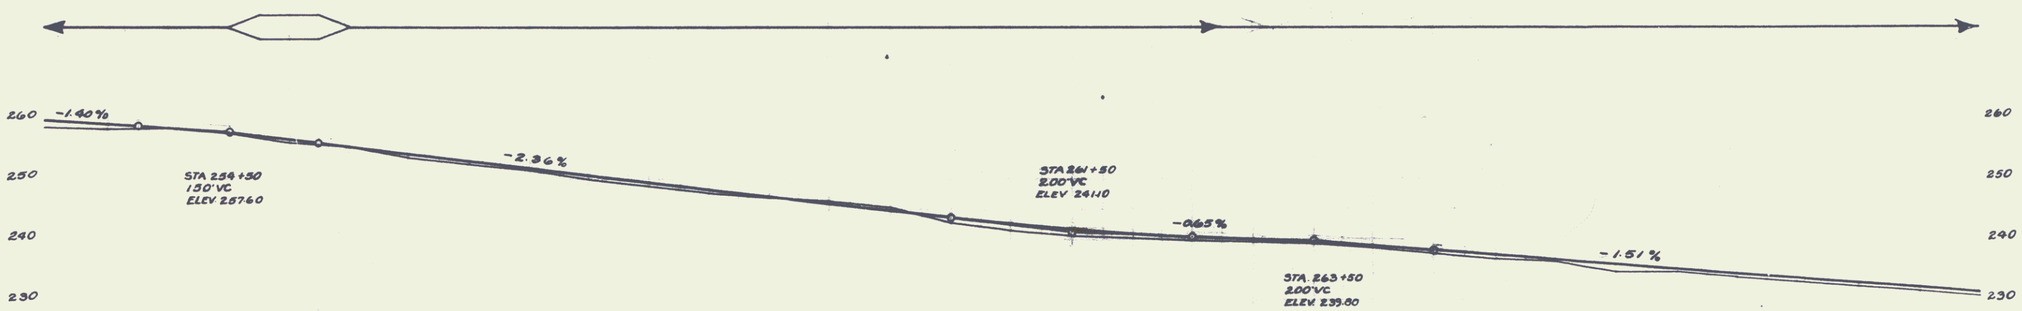


B.M. #29 Spike in 16" Maple on Lt. Sta. 263+50 Elev. 240.65'

20

19