					83-C	1928	13 of 88

NEW LEACHING BASINS REQUIRED

Station	Left	Right
435+50	1	1

6 rod ROW added per ROW Div. June 1973

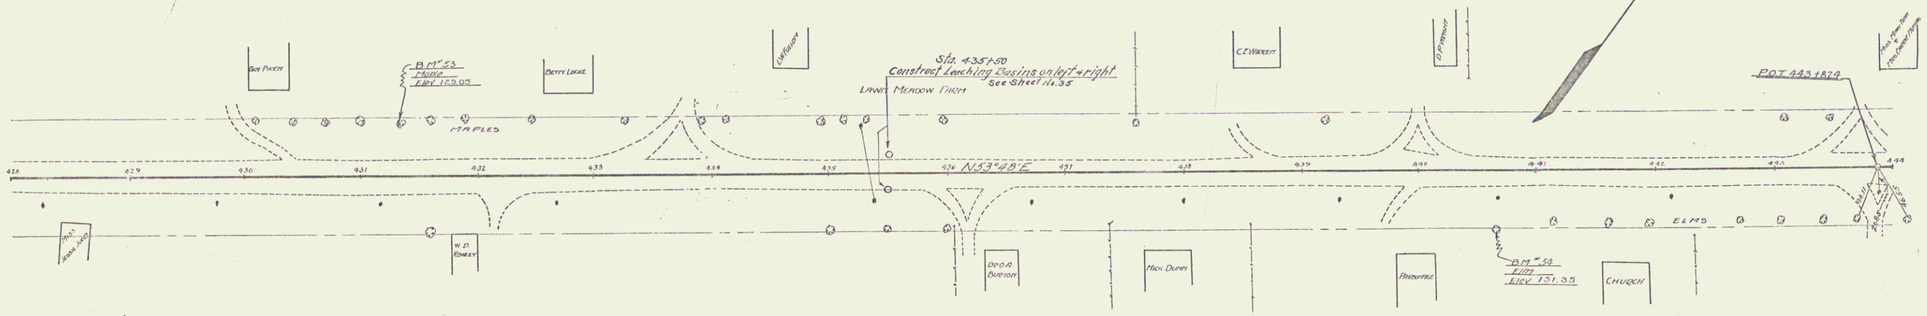

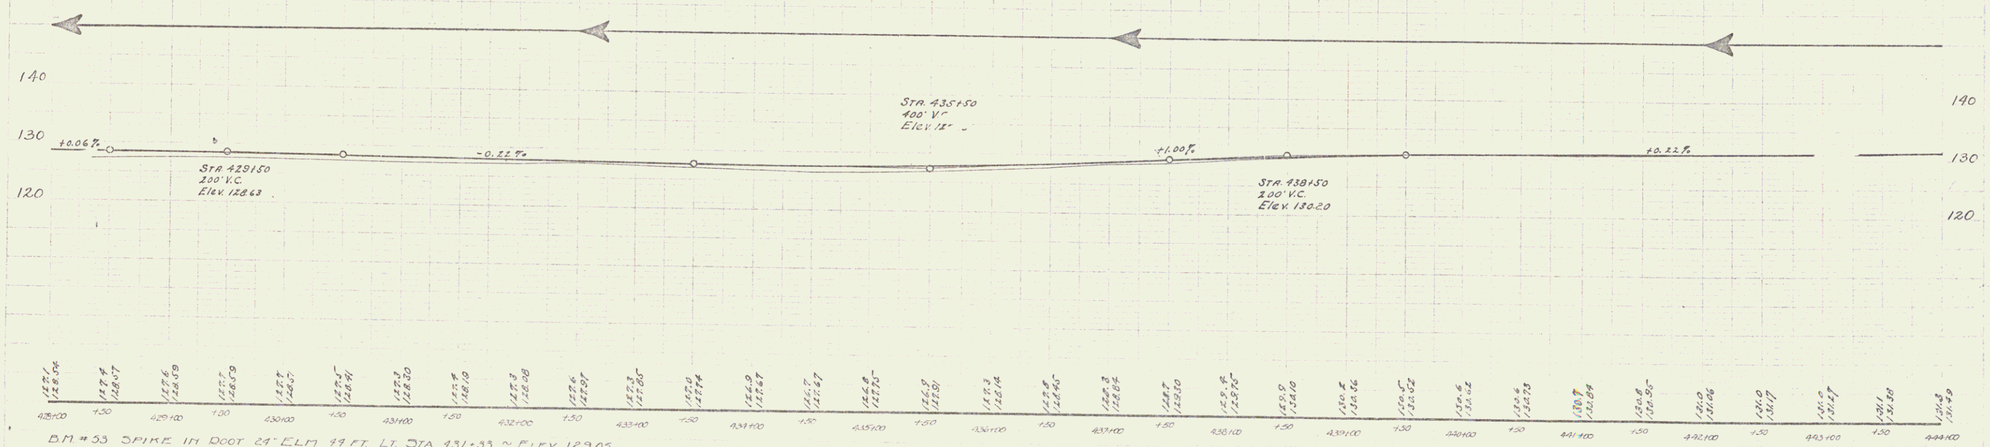

B.M. #53 SPIKE IN ROOT 24" ELM 44 FT. LT. STA. 431+33 ~ ELEV. 129.05
B.M. #54 SPIKE IN ROOT 30" MAPLE 48 FT. RT. STA. 440+66 ~ ELEV. 131.35

Series F No. 83-C
Sheet 13 of 88

11