FED. ROAD DIST. NO.	STATE	FED. AID PROJ. NO.	FISCAL YEAR	SHEET NO.	TOTAL SHEETS
9	VT.	83C	1929	18	88

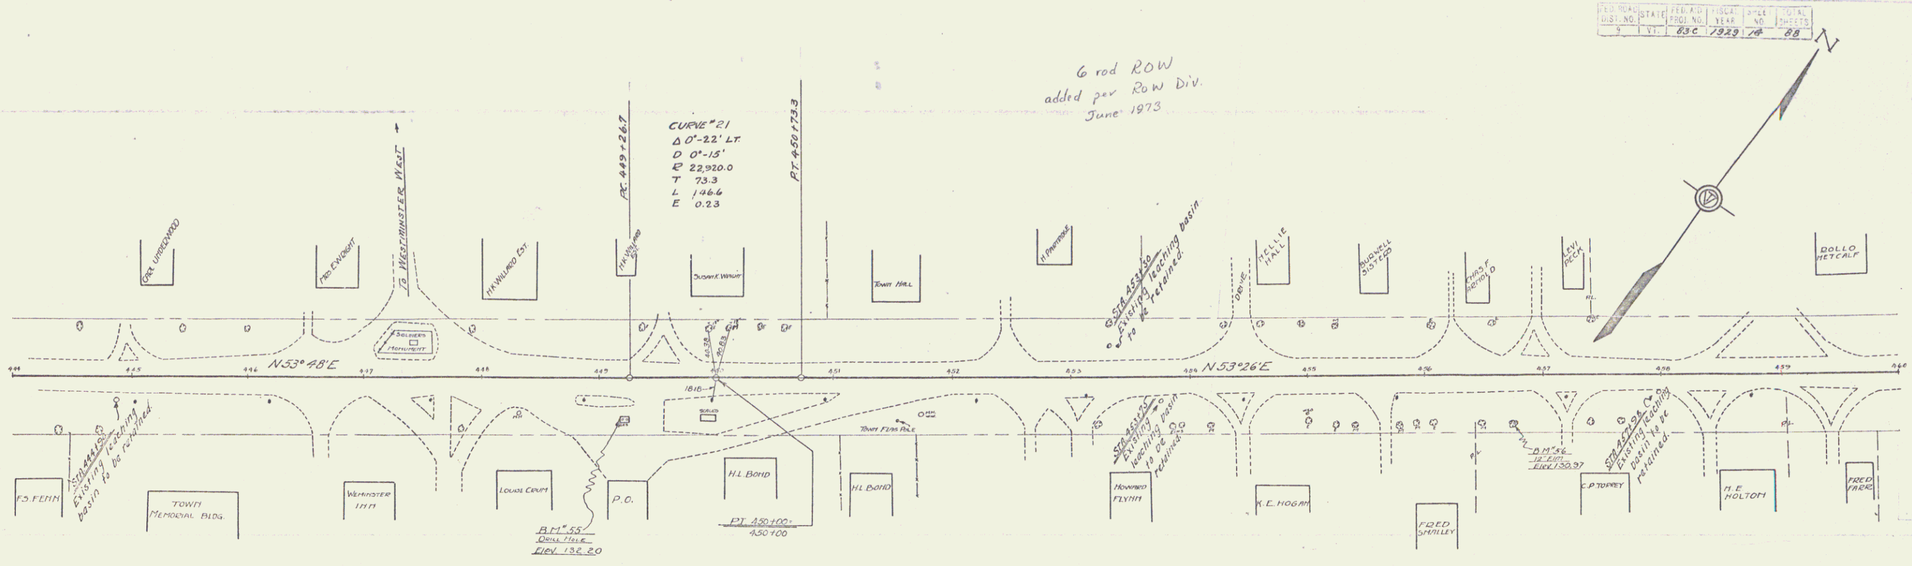

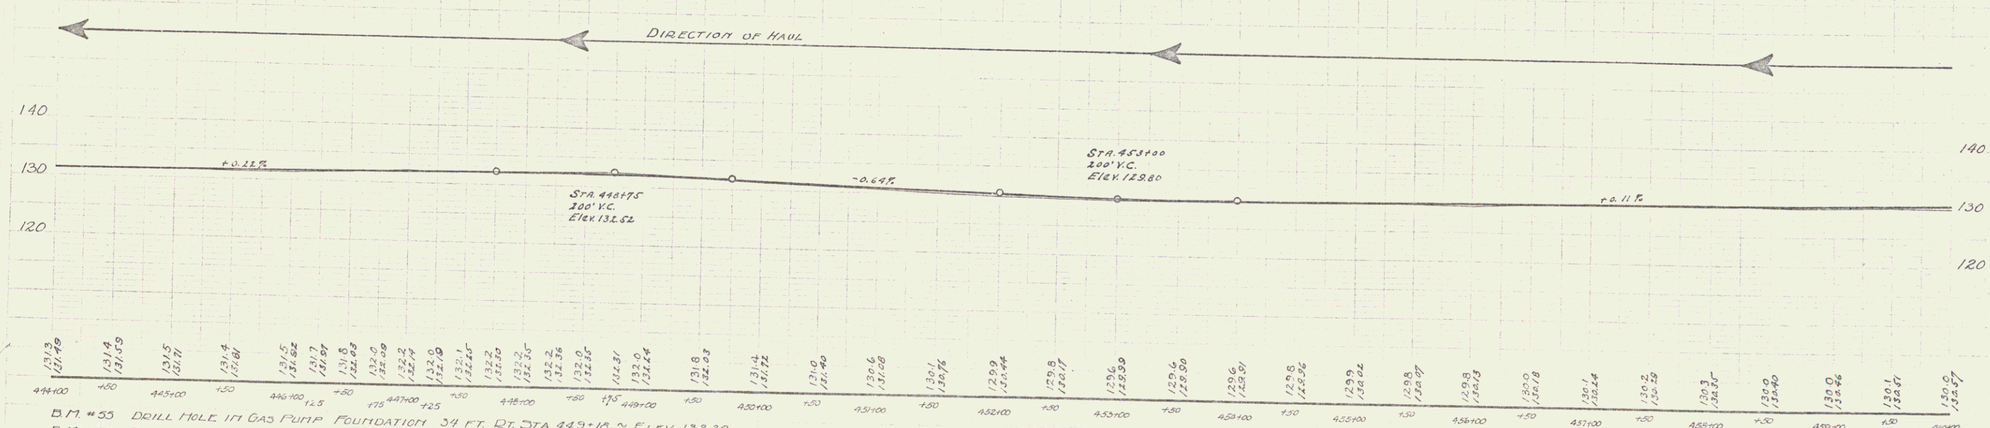

B.M. #55 DRILL HOLE IN GAS PUMP FOUNDATION 34 FT. RT. STA. 449+18 ~ ELEV. 132.20
B.M. #56 SPIKE IN ROOT 15" ELM 40 FT. RT. STA. 456+65 ~ ELEV. 130.97

Series F No. 83-C
Sheet 18 of 88

12