FED. AID PROJ. NO.	STATE	FED. AID PROJ. YEAR	SHEET NO.	TOTAL SHEETS
S-P-D	83-C	1929	19	88

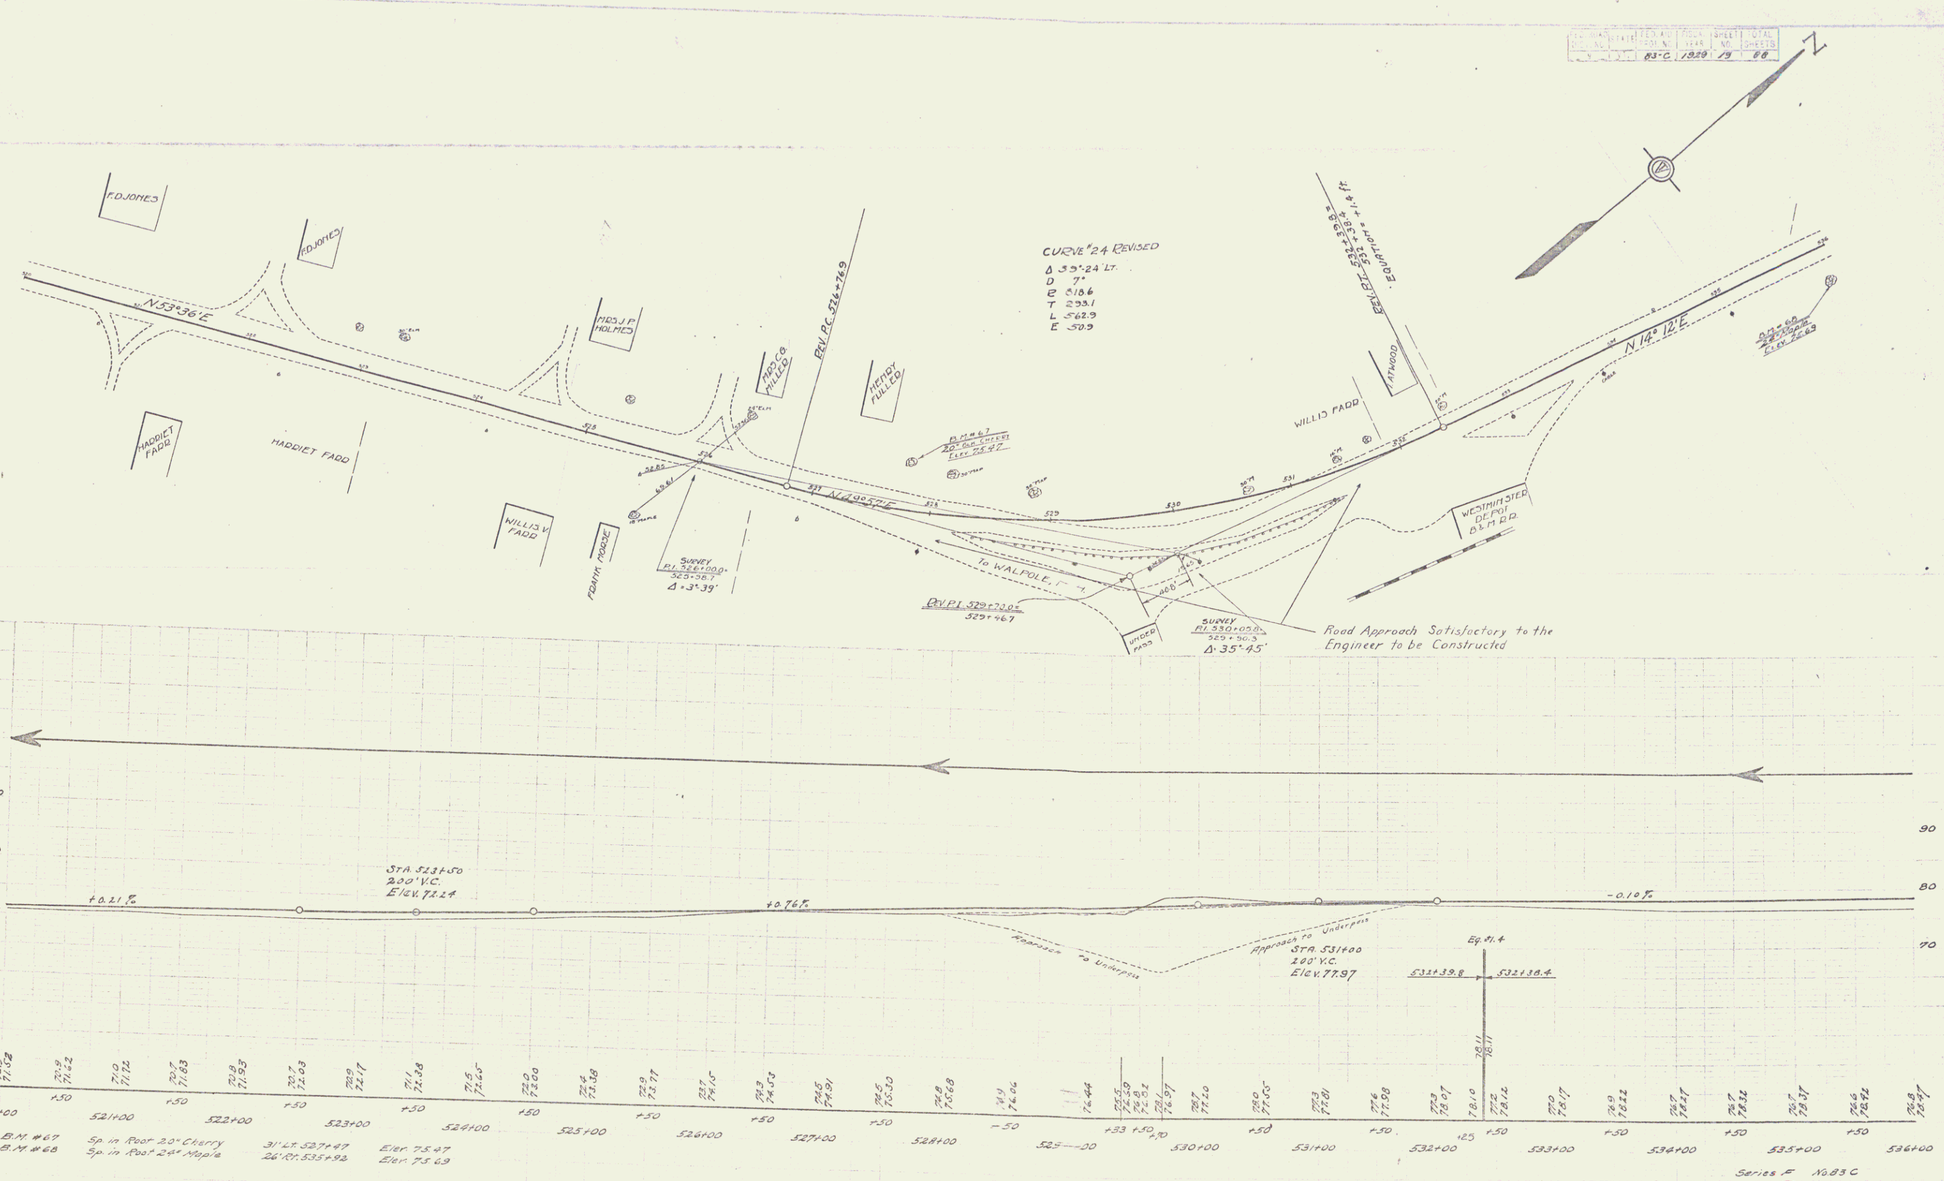

17