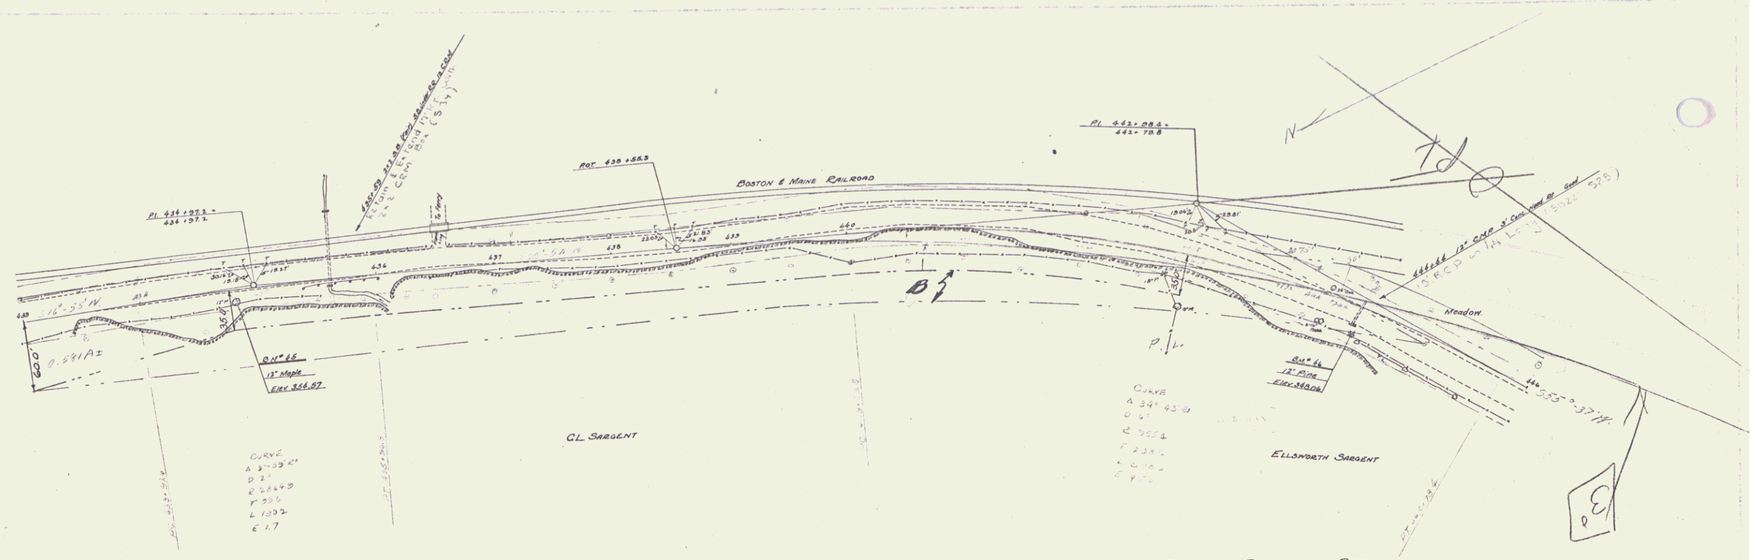

PARCEL	KIND OF INSTRUMENT	DATE OF INSTRUMENT	GRANTOR	GRANTEE	RECORDED HARTFORD BOOK	PAGE	DATE	REMARKS
1 B	Q.C.D.	9-4-35	C.L. SARGENT	Ir. of H.	32	281-293	9-21-35	

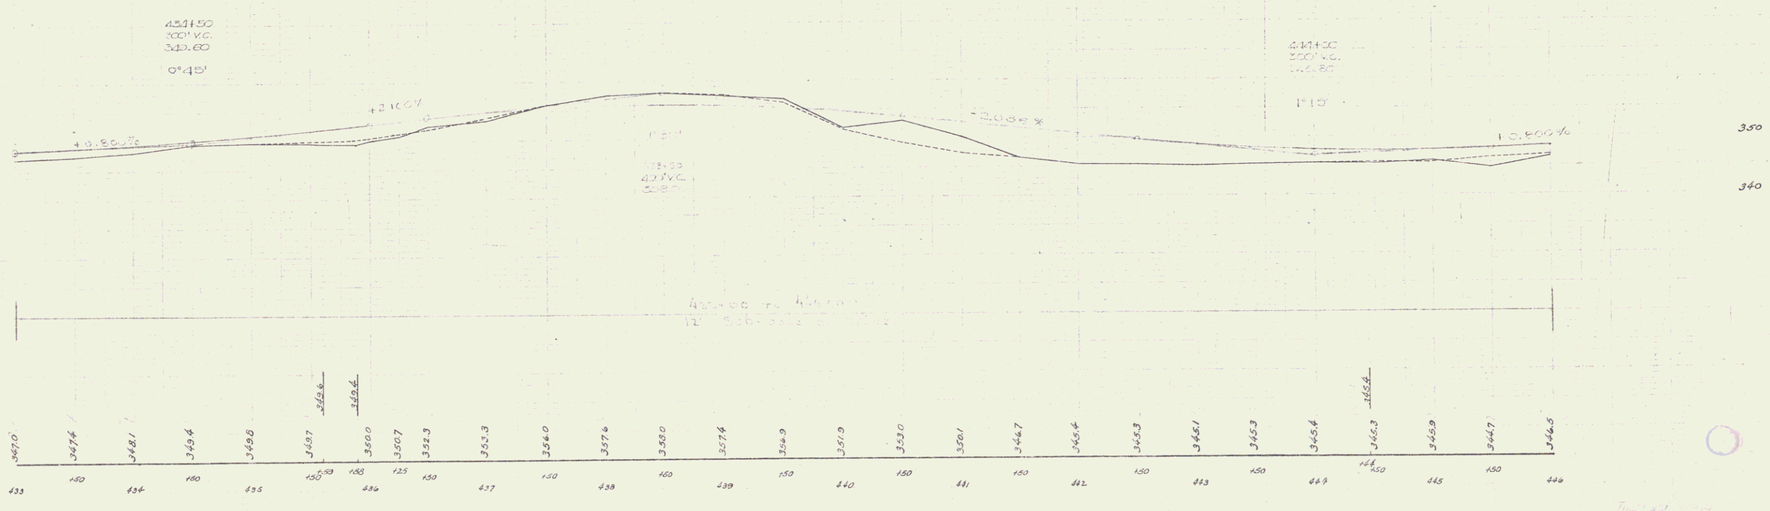

B.M. #45 SPIKE IN ROOT OF 12" MAPLE 15' RT OF STA 434+50 ELEV 354.87
B.M. #46 " " " 12" PINE 24' RT OF STA 444+53 ELEV 348.06

SHEET 10

9