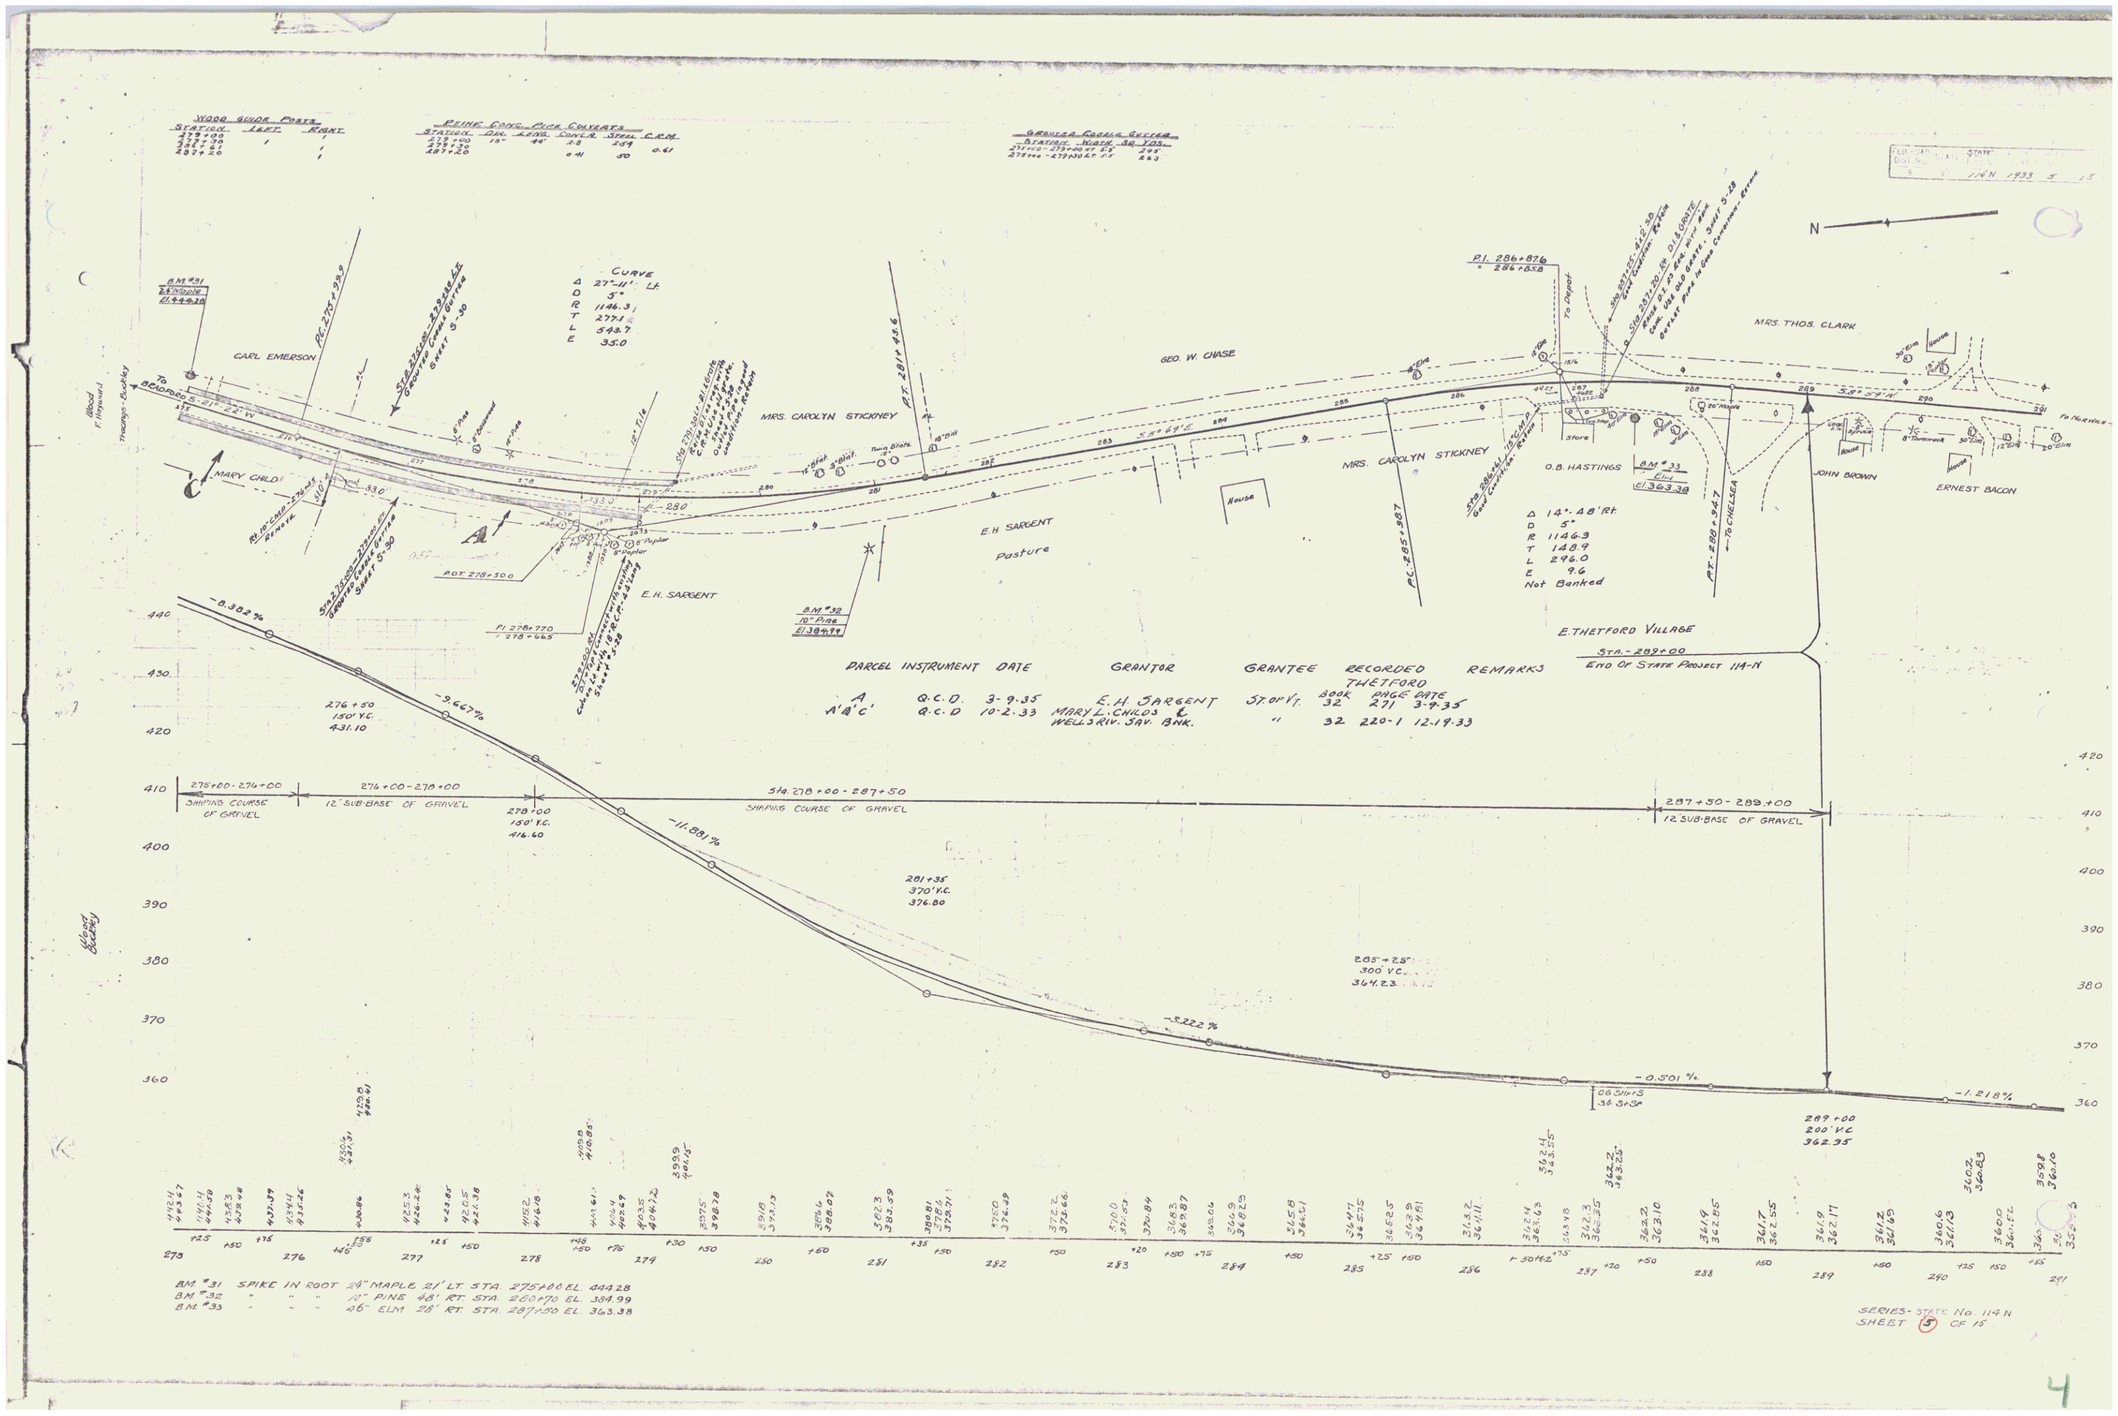
WOOD GUIDE POSTS
STATION LEFT RIGHT
279+00 1 1
281+30 1 1
287+20 1 1
REINF. CONC. PIPE CONVERTS
STATION DIA. LENG. COVER SPEC. C.R.M.
279+00 18" 44' 2.8 309 0.41
287+20 0.41 50
GROUTED COBBLE GUTTER
STATION WIDTH SQ. YDS.
275+00-279+00 AT ESE 295
287+00-289+00 AT ESE 83
CURVE
Δ 27°-11' Lt.
D 5°
R 1146.3
T 277.1
L 543.7
E 35.0
CARL EMERSON
MRS. CAROLYN STICKNEY
GEO. W. CHASE
MRS. THOS. CLARK
MAEY CHILD
E.H. SARGENT
E.H. SARGENT Pasture
House
Store
O.B. HASTINGS
JOHN BROWN
ERNEST BACON
E. THETFORD VILLAGE
STA. 289+00
END OF STATE PROJECT 114-N
Δ 14°-48' Rt.
D 5°
R 1146.3
T 148.9
L 296.0
E 9.6
Not Banked
PARCEL INSTRUMENT DATE GRANTOR GRANTEE RECORDED REMARKS
THETFORD
A Q.C.D. 3-9-35 E.H. SARGENT ST. OF VT. BOOK 32 PAGE 271 DATE 3-9-35
A'B'C' Q.C.D. 10-2-33 MARY L. CHILDS & WELLS RIV. SAV. BNK. " 32 220-1 12-19-33
STA. 275+00 - 279+00
SHAPING COURSE OF GRAVEL
STA. 279+00 - 287+50
SHAPING COURSE OF GRAVEL
287+50 - 289+00
12' SUB-BASE OF GRAVEL
276+00 - 279+00
12' SUB-BASE OF GRAVEL
275+00 - 276+00
SHAPING COURSE OF GRAVEL
276+50
150' V.C.
431.10
279+00
150' V.C.
416.60
281+35
370' V.C.
376.80
285+25
300' V.C.
364.23
289+00
200' V.C.
362.35
-8.382%
-9.667%
-11.891%
-5.222%
-0.501%
-1.218%
BM #31 SPIKE IN ROOT 24" MAPLE 21' LT. STA. 275+00 EL. 444.28
BM #32 " " " 10" PINE 48' RT. STA. 280+70 EL. 384.99
BM #33 " " " 46" ELM 28' RT. STA. 287+50 EL. 363.38
SERIES-STATE No. 114 N
SHEET 5 OF 15