SCALE	DATE	DRAWN
1527	2	5

PLAN		
NOTE BOOK	PLOTTED	7/1/67
	CHECKED	8/1/67
	AS CONSTRUCTED	
NO.	AS IN FIELD CHECKED	

J.H. COOPER 7/1/67
S.W. COLEMAN 8/1/67

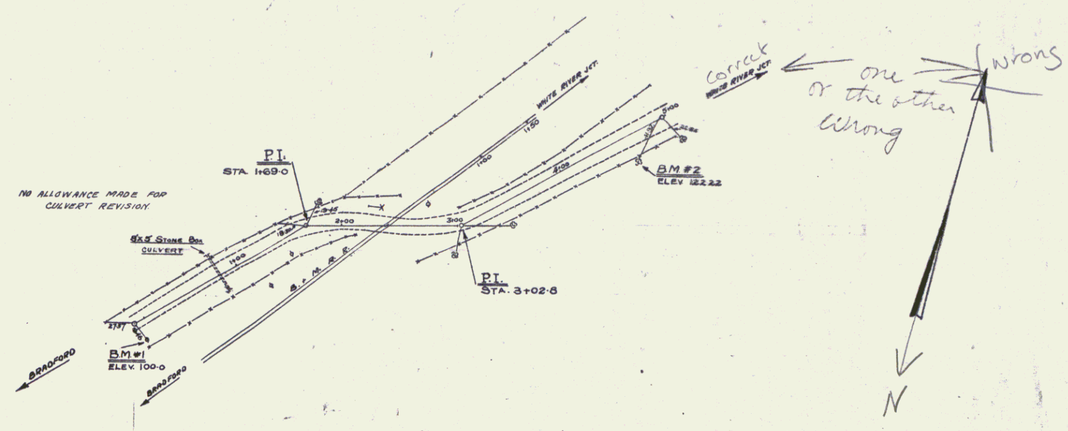

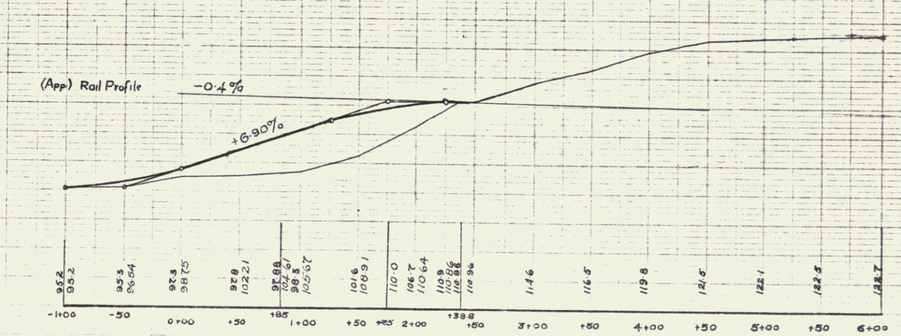

SERIES NO.
SHEET 2 of 3

2