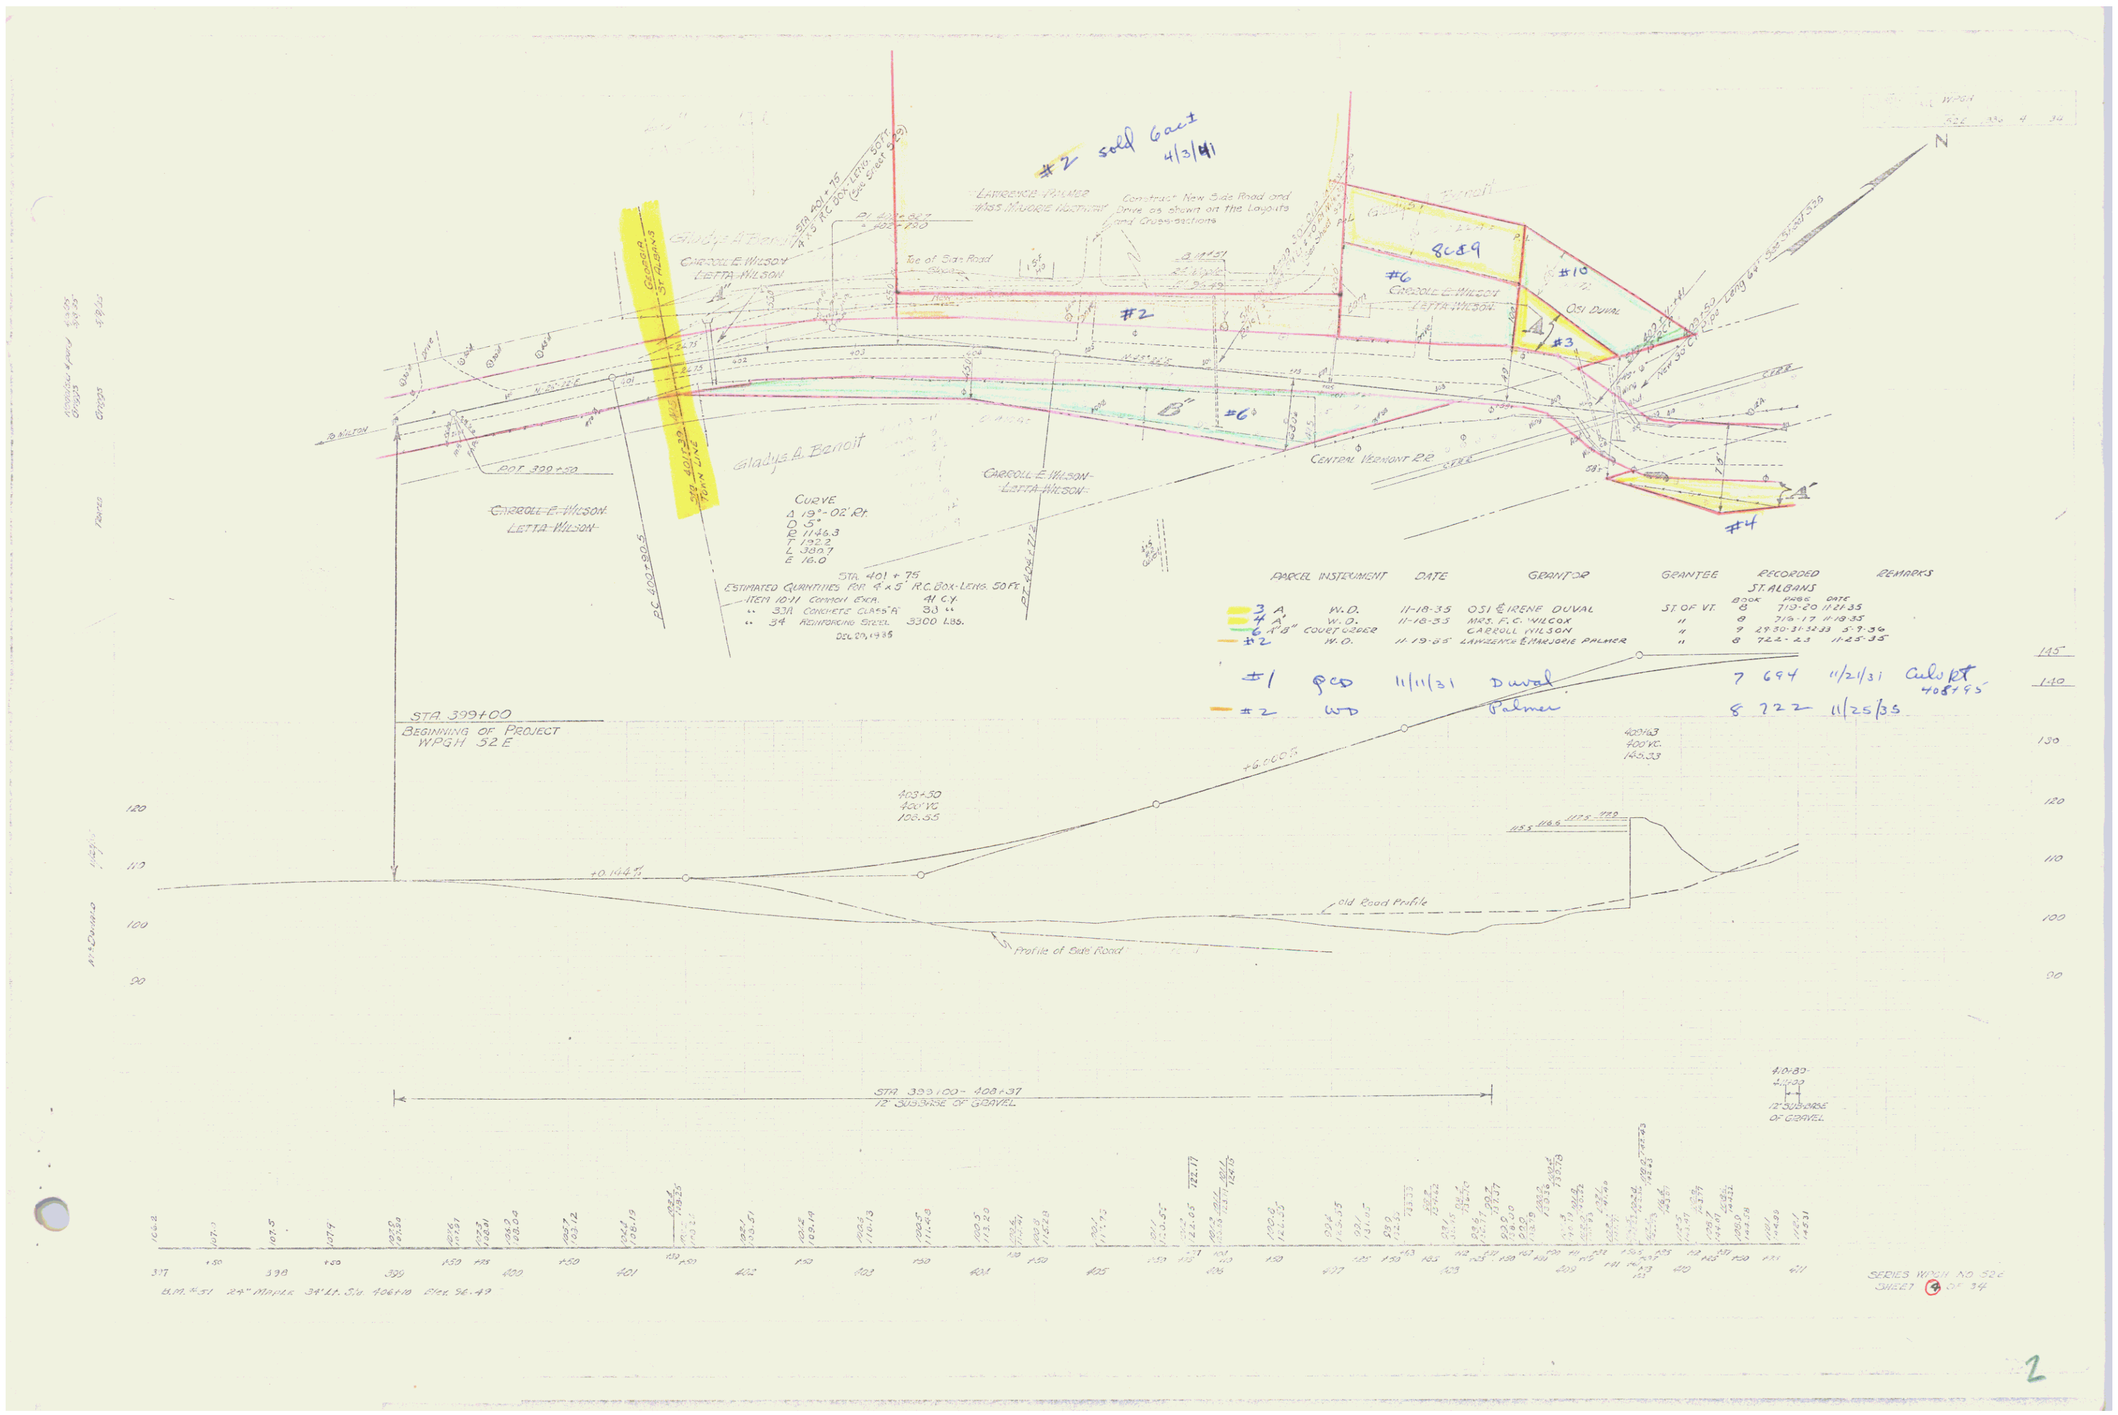
#2 sold Gait 4/3/41
Gladys A. Benoit
Carroll E. Wilson
Letta Wilson
Lawrence Palmer
Mrs. Marjorie Palmer
Construct New Side Road and Drive as shown on this Layouts and Cross-sections
Sta 401+75
4'x5' R.C. Box Leng. 50'
(See Sheet 0-29)
Grantor St. Albans
Point of Beg. Sta 401+32
Sta 399+20
Sta 401+75
Curve
Δ 19°-02' Rt.
D 5°
R 1146.3
T 192.2
L 309.7
E 16.0
Estimated Quantities for 4'x5' R.C. Box-Leng. 50 Ft.
Item 10-11 Common Excv. 41 C.Y.
" 301 Concrete Class A 33 "
" 54 Reinforcing Steel 3300 Lbs.
Dec. 20, 1935
Osi Duval
Central Vermont R.R.
#1
#2
#3
#4
#6
#10
8689
Parcel Instrument Date Grantor Grantee Recorded St. Albans Book Page Date Remarks
3 A W.D. 11-18-35 Osi Eirene Duval St. of Vt. 8 713-20 11-21-35
4 A' W.D. 11-18-35 Mrs. F.C. Wilcox " 8 716-17 11-19-35
6 A" Court Order Carroll Wilson " 9 29-30-31-32-33 5-9-36
#2 W.D. 11-19-35 Lawrence & Marjorie Palmer " 8 722-23 11-25-35
#1 QCD 11/11/31 Duval 7 694 11/21/31 Culvert 408+93
#2 WD Palmer 8 722 11/25/35
Sta 399+00
Beginning of Project
WPGH 32 E
+6.60 C.
403+50
420 V.C.
106.55
+0.14 C.
Old Road Profile
Profile of Gate Road
Sta 399+00 - 408+37
12' Subbase of Gravel
4:0-80'
12' Subbase of Gravel
B.M. #31 24" Maple 34' Lt. Sta 406+18 Elev. 96.49
Series with No. 32 E
Sheet 3 of 34
WPGH
32E 330 4 34
N
Grade
Rate of Grade
Elevation
Horizontal
Vertical