WOOD GUARD RAIL REQUIRED

LEFT

Sta. 16+88 to Sta. 17+12 Length 24 Ft.

RIGHT

Sta. 16+88 to Sta. 17+12 Length 24 Ft.

TOTAL FOR SHEET 48 Ft.

NEW CULVERTS REQUIRED

Sta. 17+00 24" Round Concrete Pipe Length 32 Ft.

Concrete Class B (1-2½-5) 4.3 cu. yds.

Round Steel 33 lbs.

FOR CONCRETE PAVEMENT

11" SUB-BASE OF STONE Sta. 12+00 TO Sta. 27+00 = 1500.0 Lin Ft.

2" " " SAND 12+00 " " 27+00 = 1500.0 " "

FOR BITUMINOUS MACADAM.

18" Sub-base Of Stone Sta 12+00 To Sta 27+00 = 1500 Lin Ft.

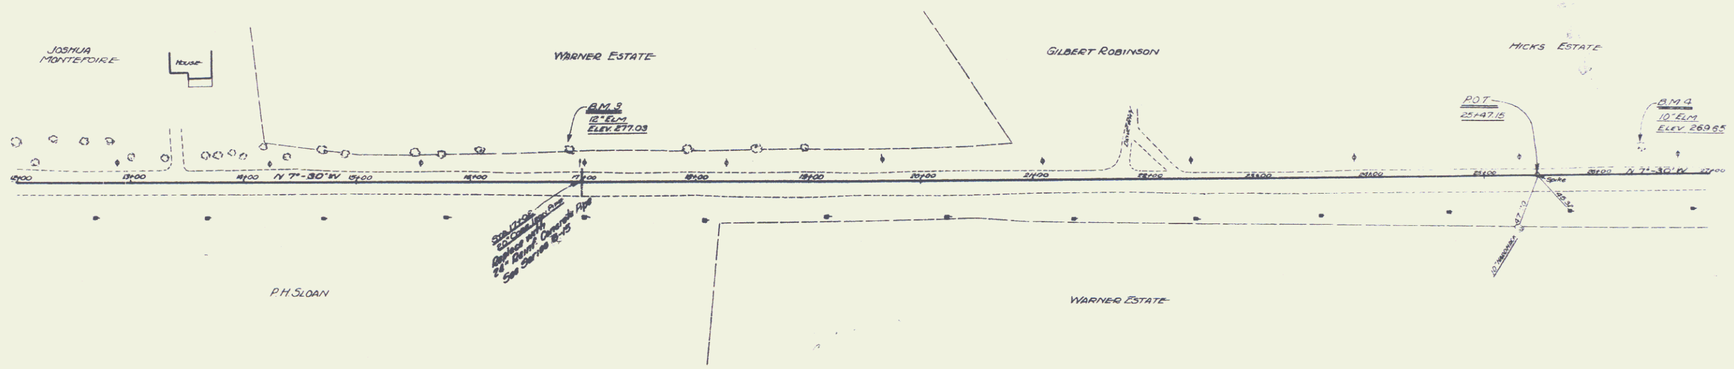

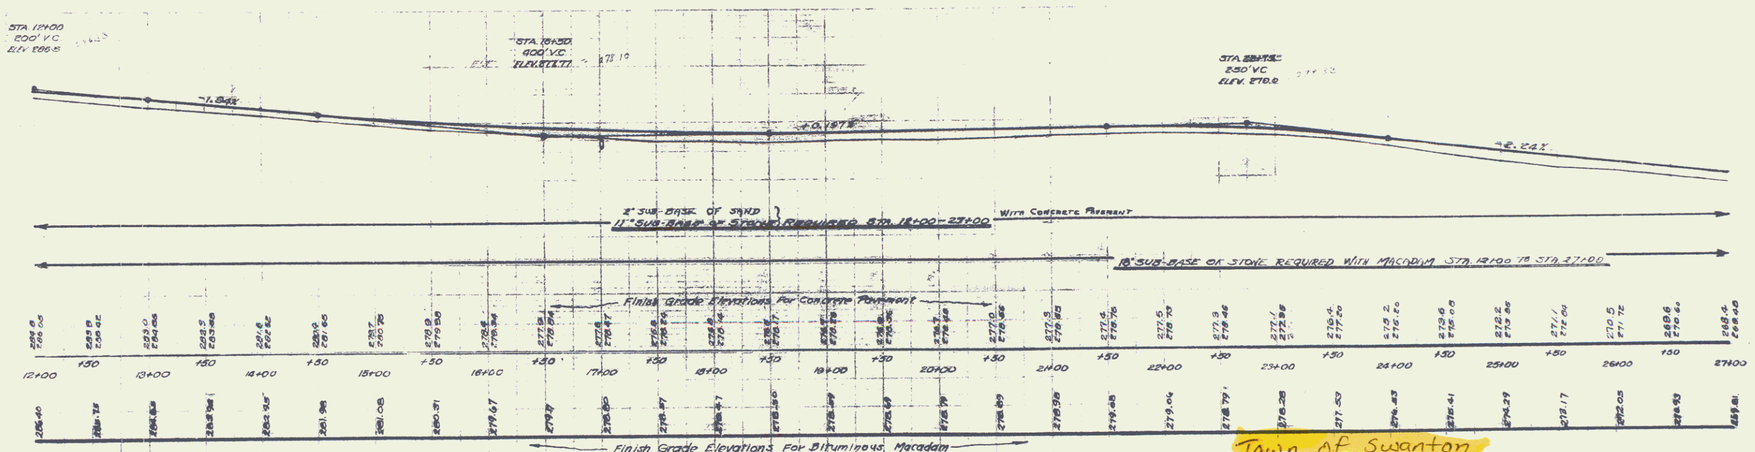

Town of Swanton

Rte. US7

Project No. F.A.P. 82C

3