WOOD GUARD RAIL REQUIRED

LEFT

Sta. 133+76 to Sta. 134+00 Length 24 ft.
" 134+14 " " 134+38 " 24 "
" 141+42 " " 141+66 " 24 "
→ 72 ft.

RIGHT

Sta. 133+76 to Sta. 134+00 Length 24 ft.
" 134+14 " " 134+38 " 24 "
" 141+42 " " 141+66 " 24 "
→ 72 ft.

TOTAL FOR SHEET 144 ft.

NEW CULVERTS REQUIRED.

Sta. 141+56 - 18" Plain Conc. Pipe Culvert - Length 20 ft.
Concrete Class B (1-2-4-5) - 2.7 cu. yds.
Reinforcing Steel - 33 lbs.

RELAYING PIPE CULVERTS

ON RIGHT

Sta. 128+30 - 18" Conc. Class B (1-2-4-5) 1.5 cu. yds.
Sta. 132+40 - 18" " " " 1.5 cu. yds.

FOR CONCRETE PAVEMENT

4" Sub-base of Stone - Sta. 128+00 To Sta. 141+00 = 1300 Lin. Ft.
11" " " Stone - " 141+00 " " 142+00 = 100.0 Lin. Ft.
2" " " Sand - " 141+00 " " 142+00 = 100.0 " "

FOR BITUMINOUS MACADAM

12" Sub-base of Stone Sta. 128+00 To Sta. 141+00 = 1300 Lin. Ft.
18" " " " " 141+00 " " 142+00 = 100 " "
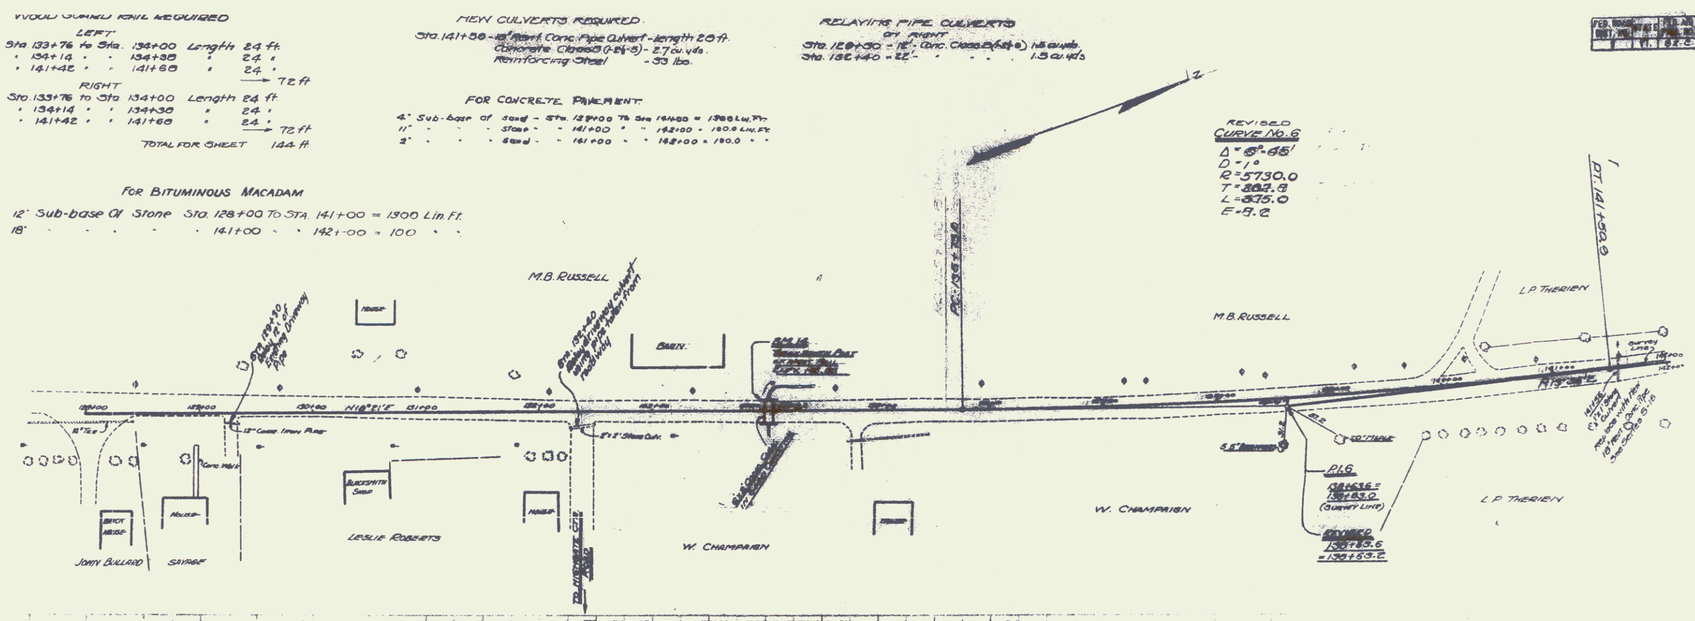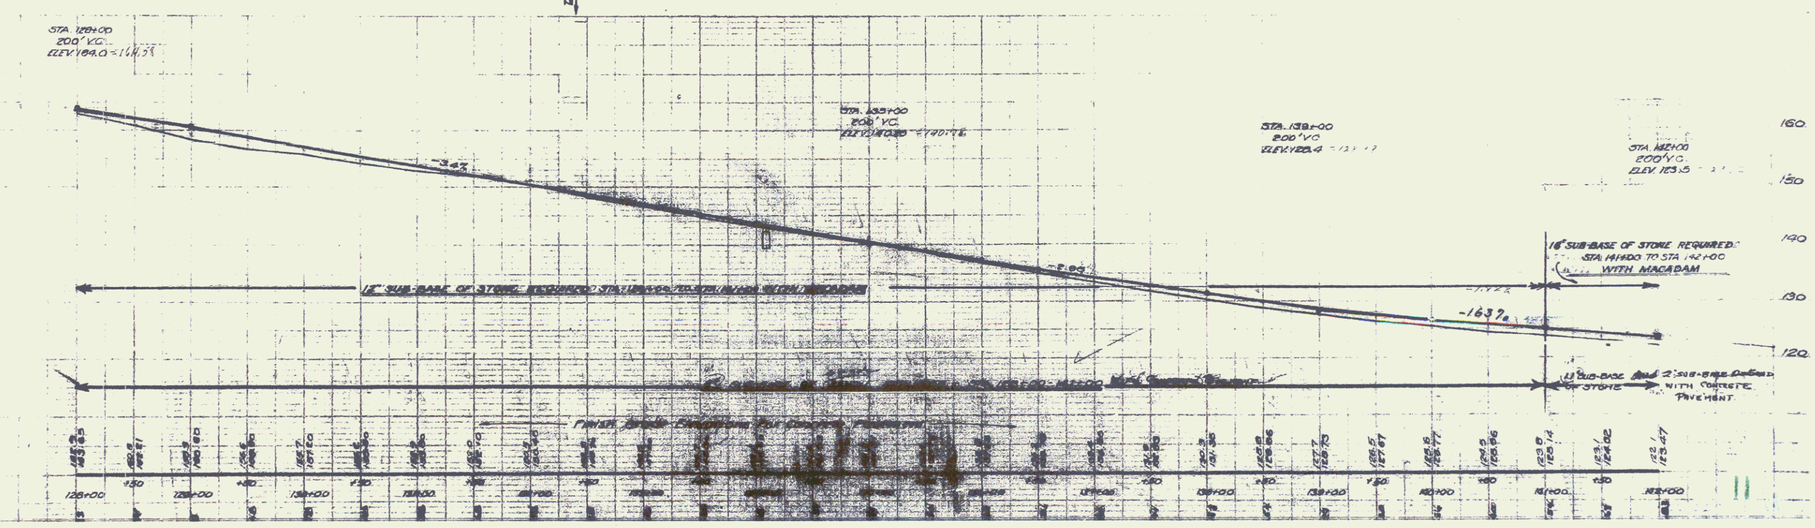
REVISED
CURVE No. 6
Δ = 8°-45'
D = 1°
R = 5730.0
T = 882.8
L = 875.0
E = 9.2