WOOD GUARD RAIL REQUIRED
LEFT
Sta 152+10 to Sta 153+00 - Length 80 ft

FOR CONCRETE PAVEMENT
11" Sub-Base of Sand - Sta. 142+00 To Sta. 149+00 = 700 Lin. Ft.
8" " " Sand " " 142+00 " " 149+00 = 700 Lin. Ft.
4" " " " " " 149+00 " " 153+00 = 400 Lin. Ft.

FOR BITUMINOUS MACADAM
18" Subbase of Stone Sta 142+00 To Sta. 149+00 = 700 Lin. Ft.
12" Subbase of Stone Sta. 149+00 To Sta. 153+00 = 400 Lin. Ft.
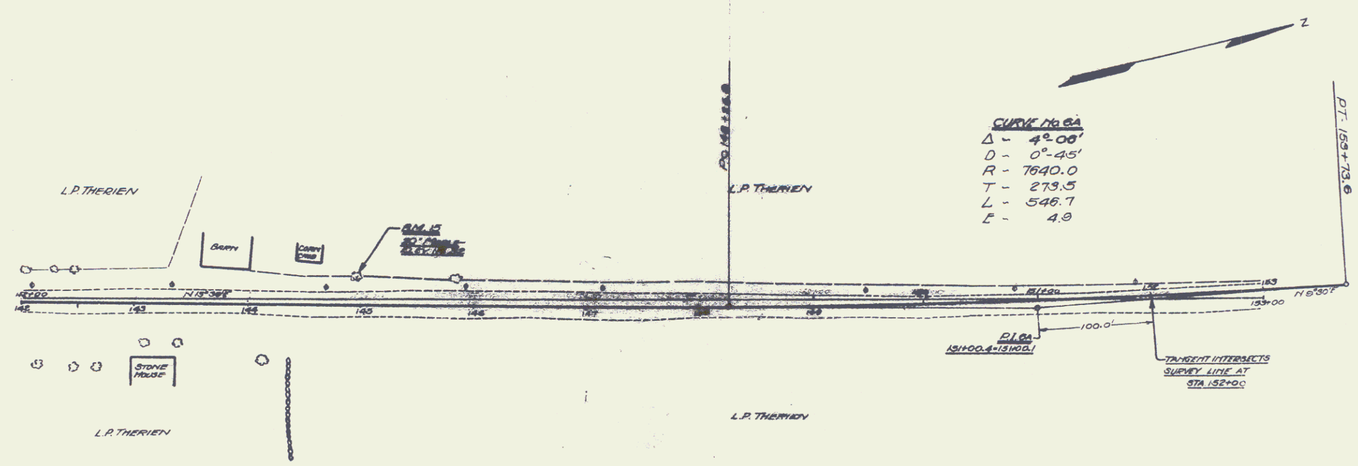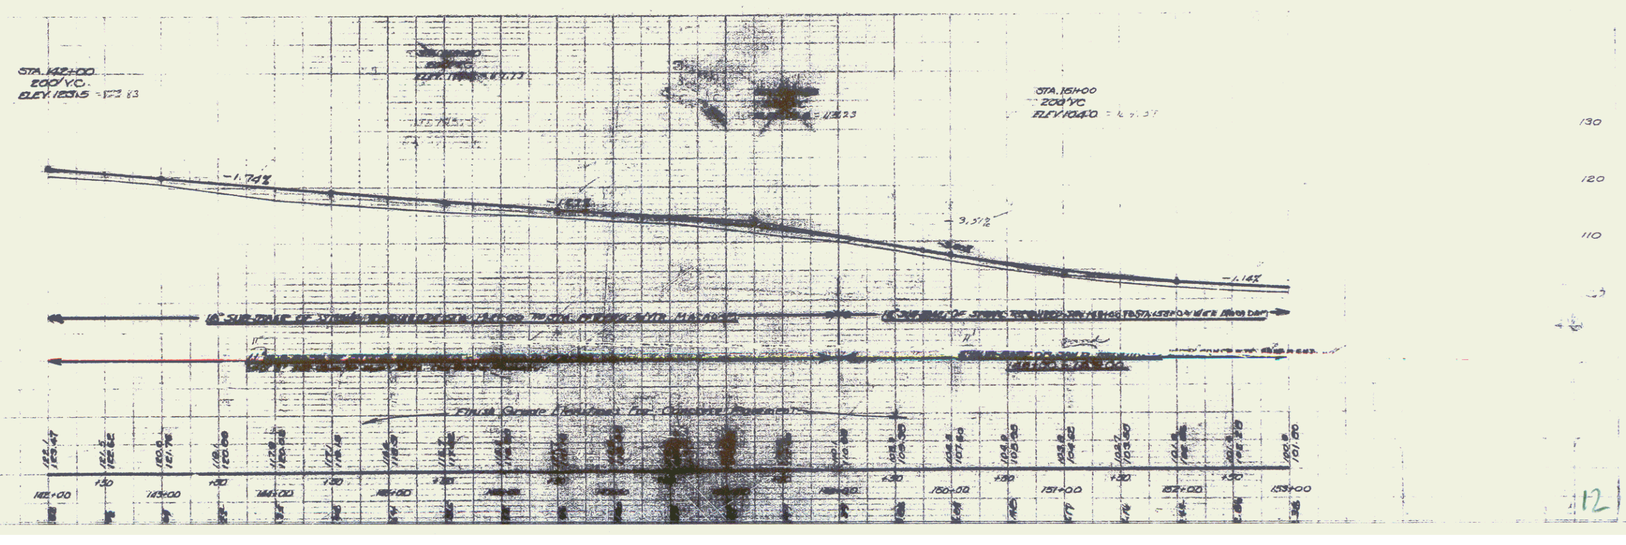
FEDERAL AID PROJECT NO.	STATE	FEDERAL AID PROJECT NO.	SHEET NO.	TOTAL SHEETS
1	Vt.	BRC-0	17	[illegible]