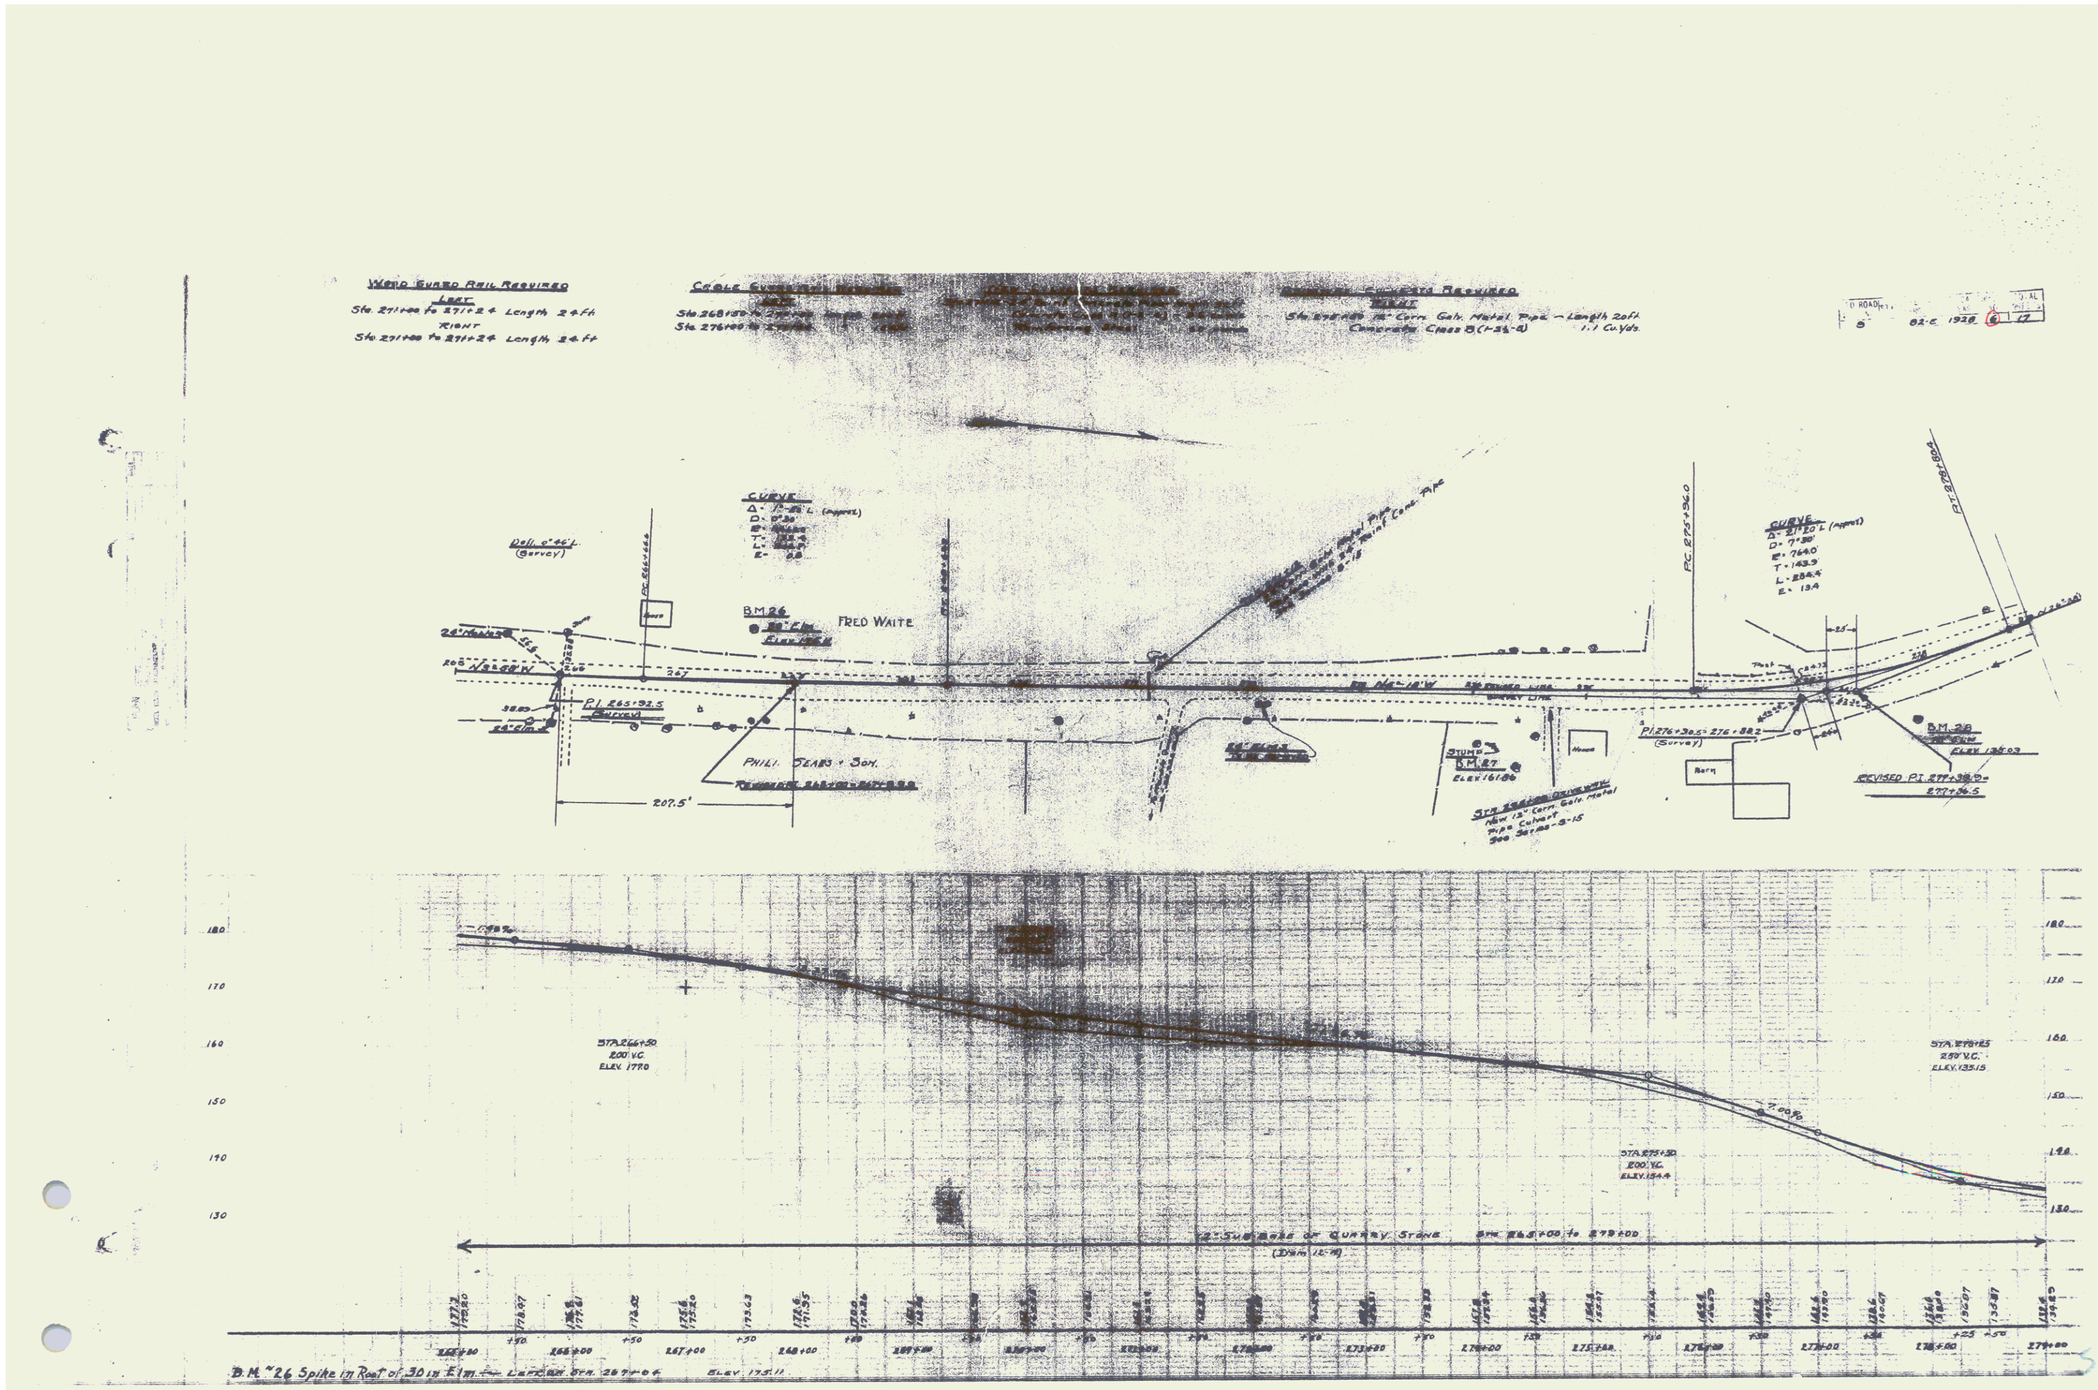
Wood Guard Rail Required
Left
Sta. 271+00 to 271+24 Length 24 ft
Right
Sta. 271+00 to 271+24 Length 24 ft
Sta. 268+00 Concrete Cross B (1-24-8)
Sta. 268+00 18" Corr. Galv. Metal Pipe - Length 20 ft.
1.1 Cu. Yds.
Curve
Delt. 6°46' (Survey)
B.M. 26
Fred Waite
P.I. 265+92.5 (Survey)
Phil. Sears & Son.
207.5'
Stump
B.M. 27
Elev. 161.86
Sta. 273+00 Driveway
New 12" Corr. Galv. Metal Pipe Culvert
Barn
House
P.C. 275+96.0
P.I. 276+39.5 - 276+88.2 (Survey)
B.M. 28
Elev. 136.03
Revised P.I. 277+38.0 - 277+86.5
P.T. 278+80.4
Sta. 266+50
200' V.C.
Elev. 177.0
Sta. 275+50
200' V.C.
Elev. 154.4
Sta. 278+65
250' V.C.
Elev. 135.15
-1.98%
12" Sub Base of Quarry Stone Sta. 265+00 to 279+00
B.M. #26 Spike in Root of 30 in. Elm. - Left Sta. 267+06 Elev. 173.11