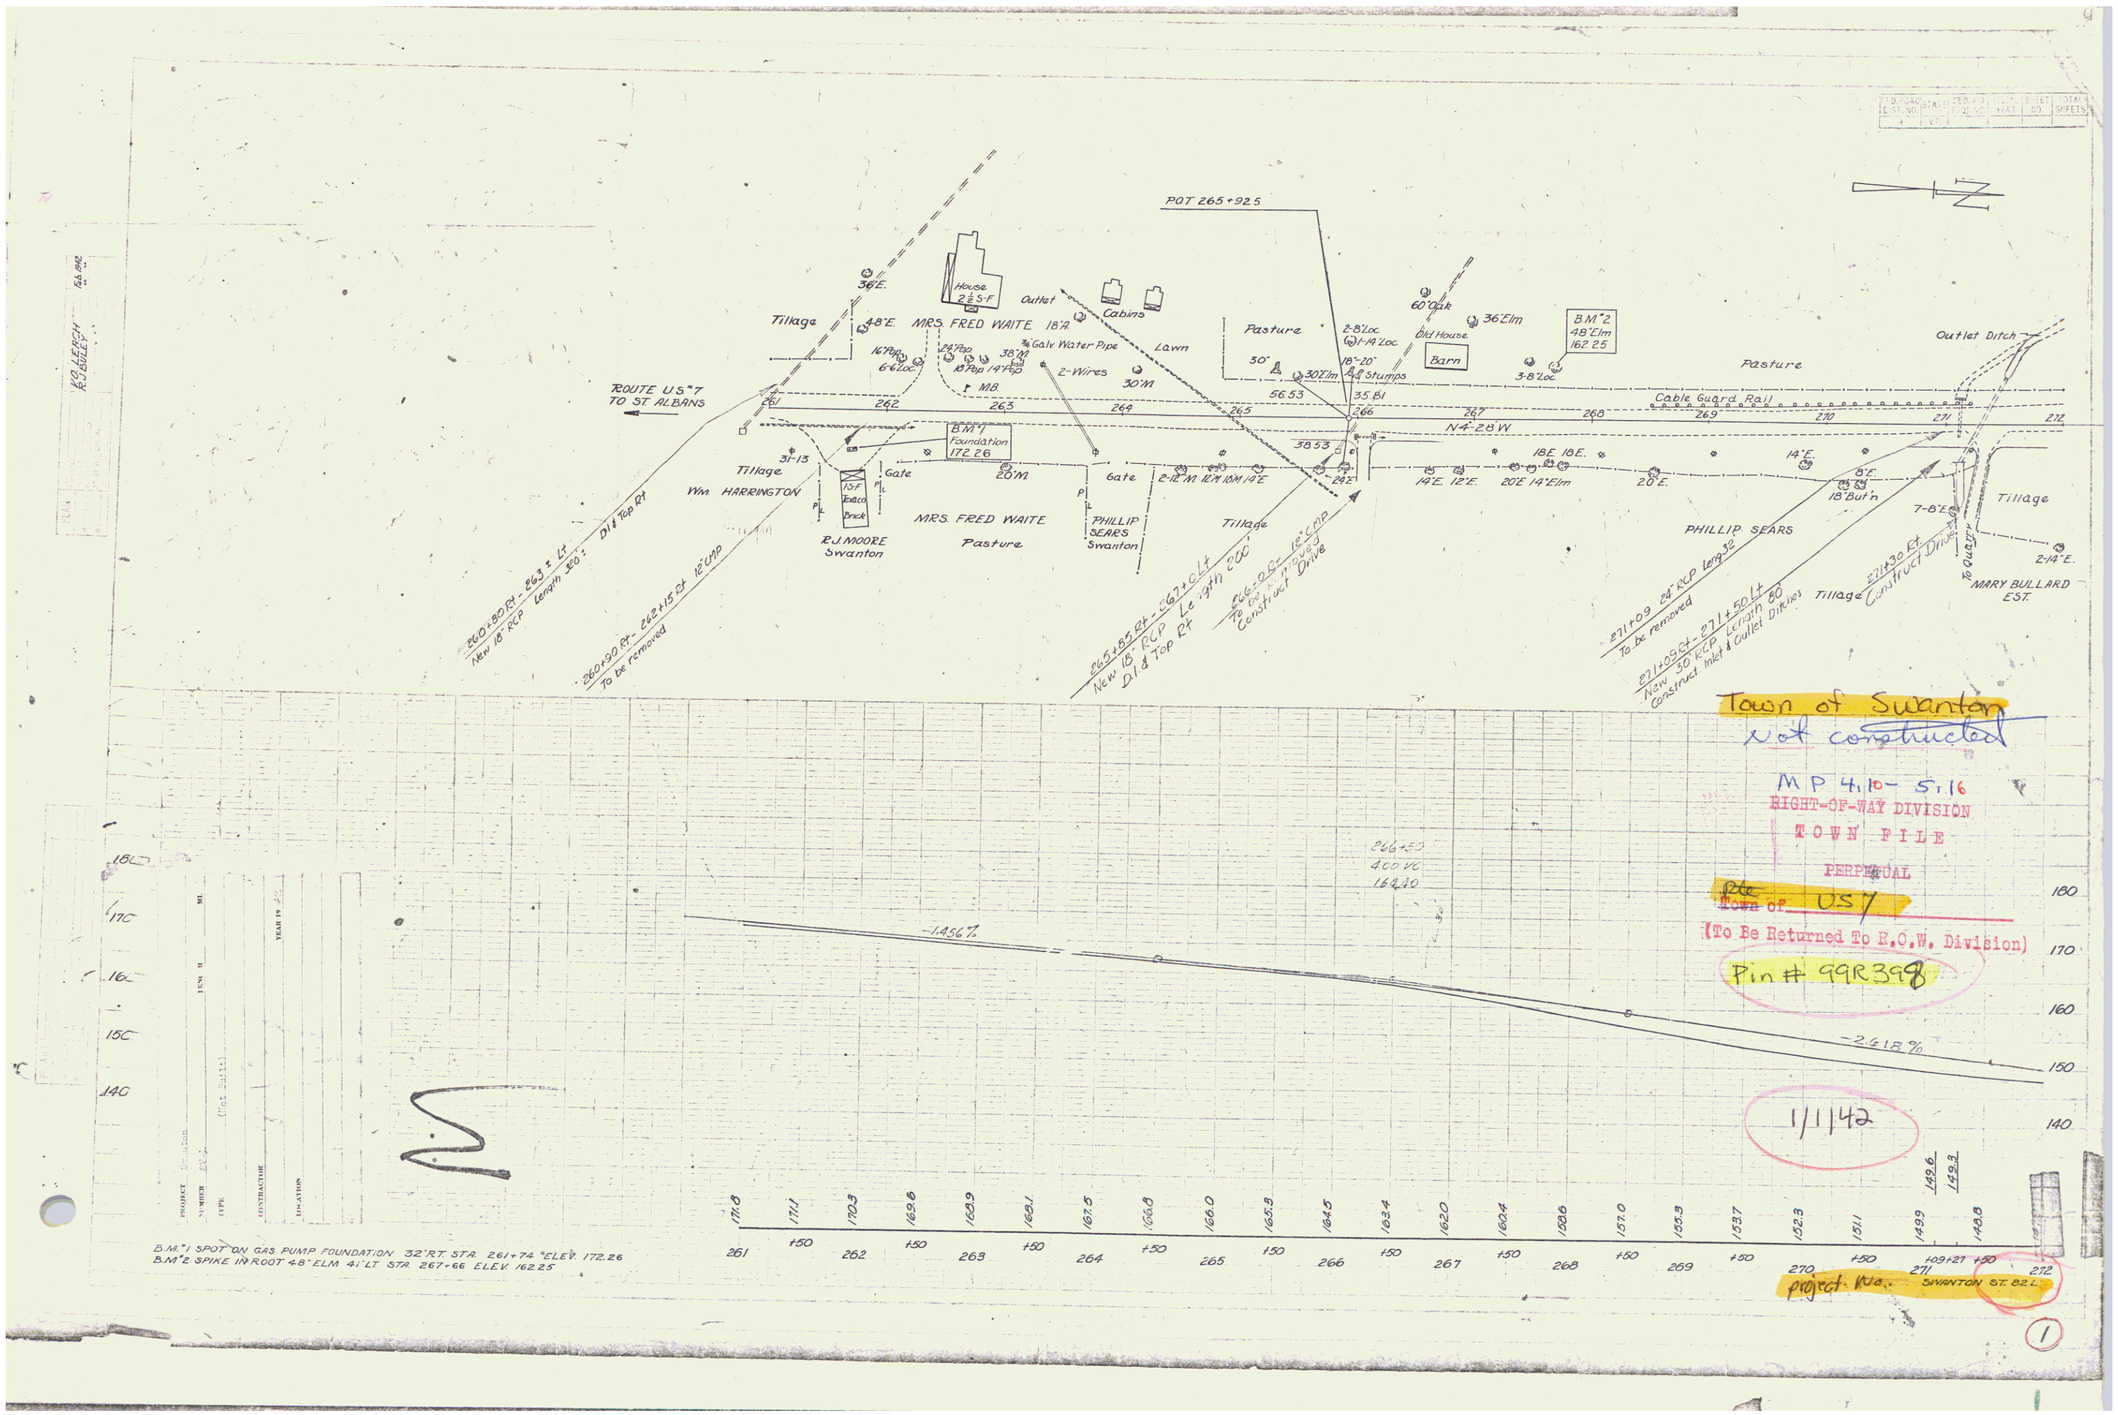
POT 265+92.5
ROUTE US 7
TO ST. ALBANS
Tillage
MRS. FRED WAITE 18.7A
House
Outlet
Cabins
Lawn
Pasture
Barn
Old House
B.M. 2
48" Elm
162.25
Cable Guard Rail
Outlet Ditch
N 4°-28' W
Wm HARRINGTON
R.J. MOORE
Swanton
PHILLIP SEARS
Swanton
PHILLIP SEARS
MARY BULLARD
EST.
Gate
B.M. 1
Foundation
172.26
Construct Drive
Construct Inlet & Outlet Dikes
Town of Swanton
not constructed
MP 4.10 - 5.16
RIGHT-OF-WAY DIVISION
TOWN FILE
PERPETUAL
Town of US 7
(To Be Returned To R.O.W. Division)
Pin # 99R398
1/1/42
-1.456%
-2.612%
266+50
400 VC
164.40
B.M. #1 SPOT ON GAS PUMP FOUNDATION 32' RT. STA. 261+74 ELEV. 172.26
B.M. #2 SPIKE IN ROOT 48" ELM 41' LT. STA. 267+66 ELEV. 162.25
project No. SWANTON ST. 82 L
1