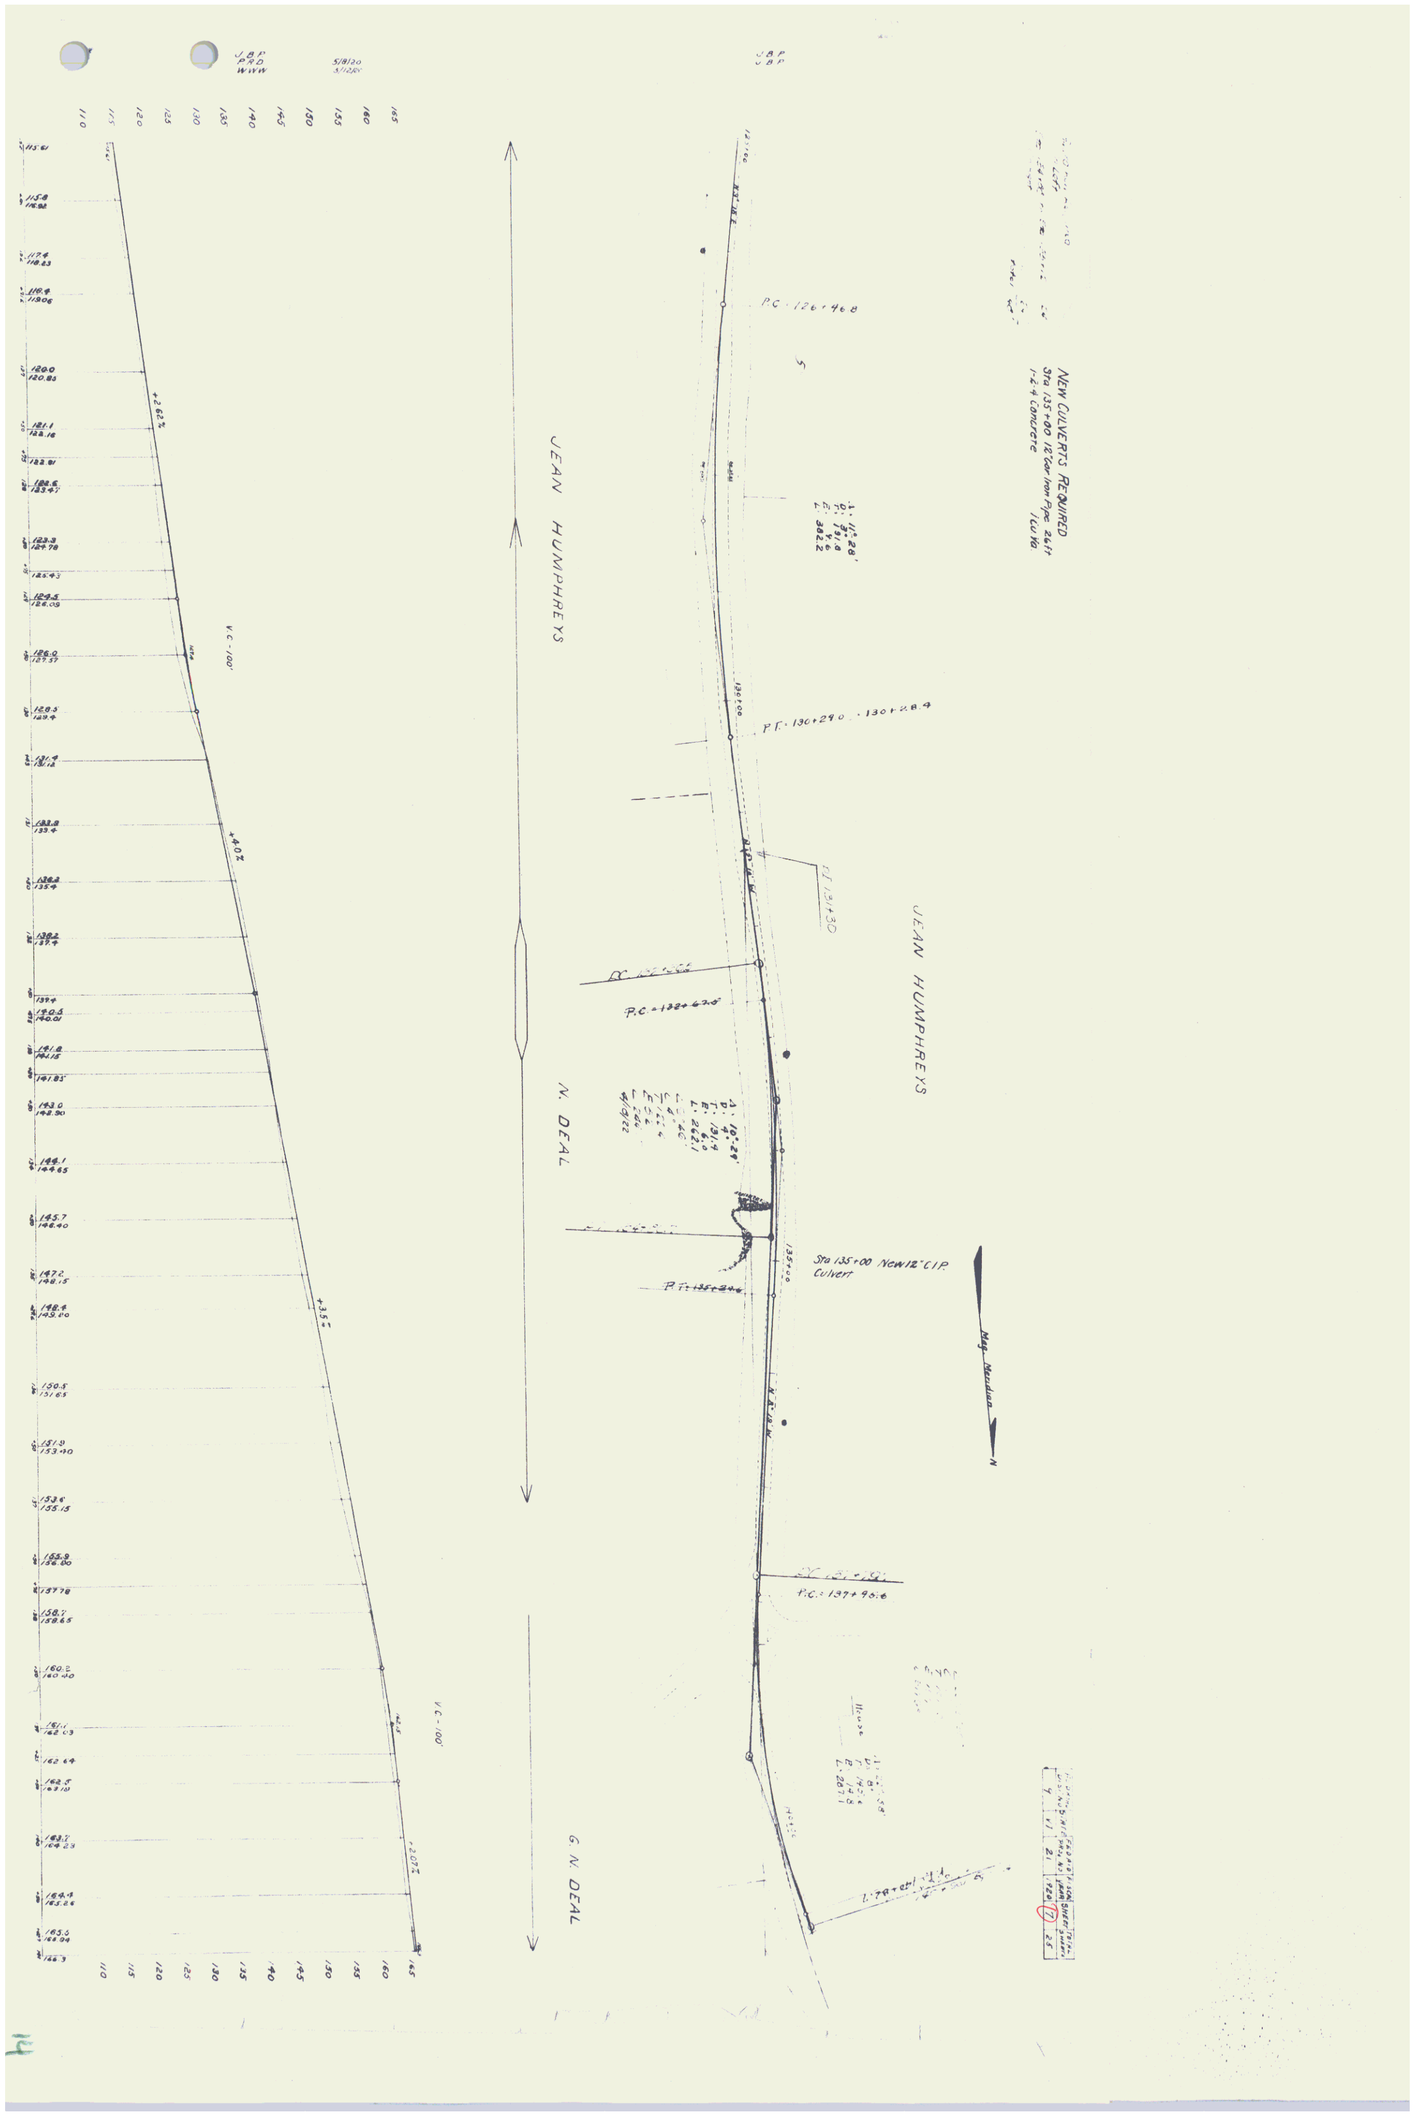
NEW CULVERTS REQUIRED
1:2:4 Concrete
P.C. 126+46.8
P.F. 130+29.0 - 130+28.4
P.T. 131+30
P.C. = 132+67.0
Sta 135+00 New 12" C.I.P. Culvert
P.C. = 137+96.6
JEAN HUMPHREYS
N. DEAL
G. N. DEAL
Mag. Meridian
N
VC - 100'
+2.62%
+4.0%
+3.5%
-2.07%