G[illegible] QUIRED
ON LEFT 30 280
Sta 172+50 to Sta. 175+~~00~~ Length ~~280 M~~
" 182+35 " " 182+59 " 24 "
ON RIGHT
Sta 182+35 to Sta 182+59 Length 24 M
TOTAL THIS SHEET ~~304 M~~

NEW CULVERTS REQUIRED

Sta 182+47 12" Cor Iron Pipe 28 M.
Concrete 1-2-4 1.0 cu yds

FED ROAD DIST NO	STATE	PROJ NO	
4	VI	21	1020 (10)

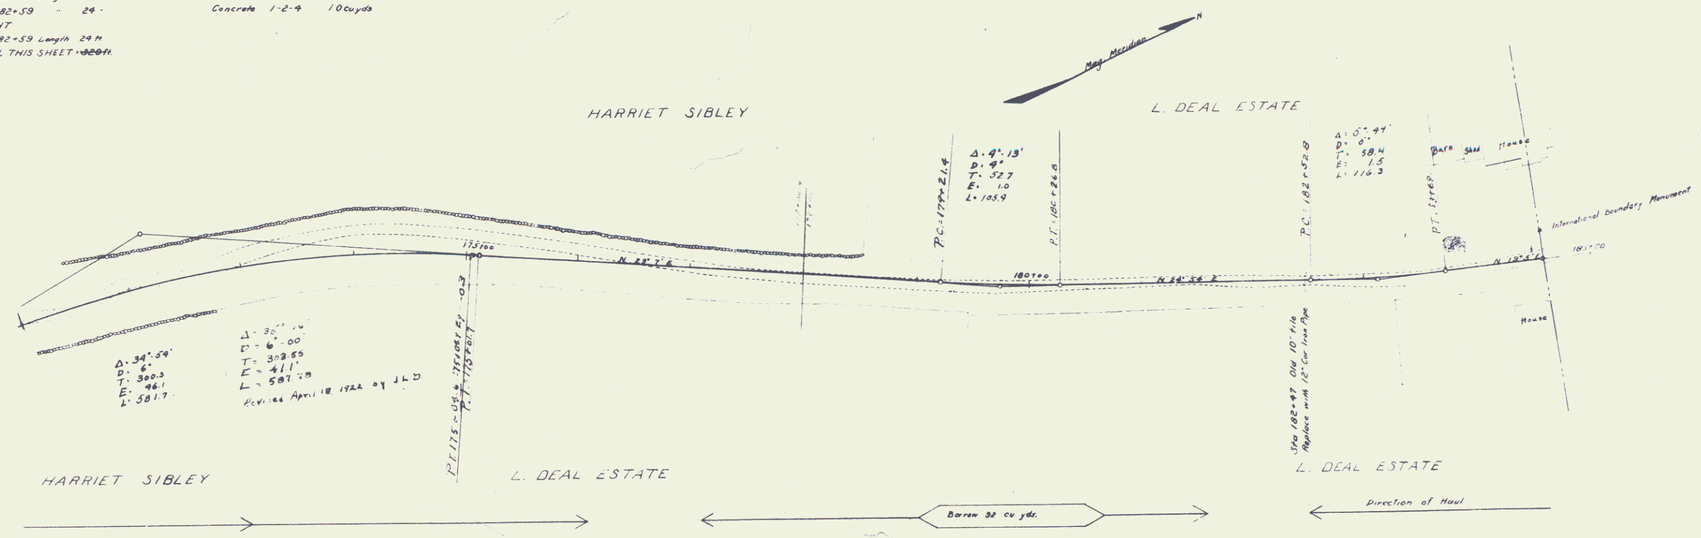

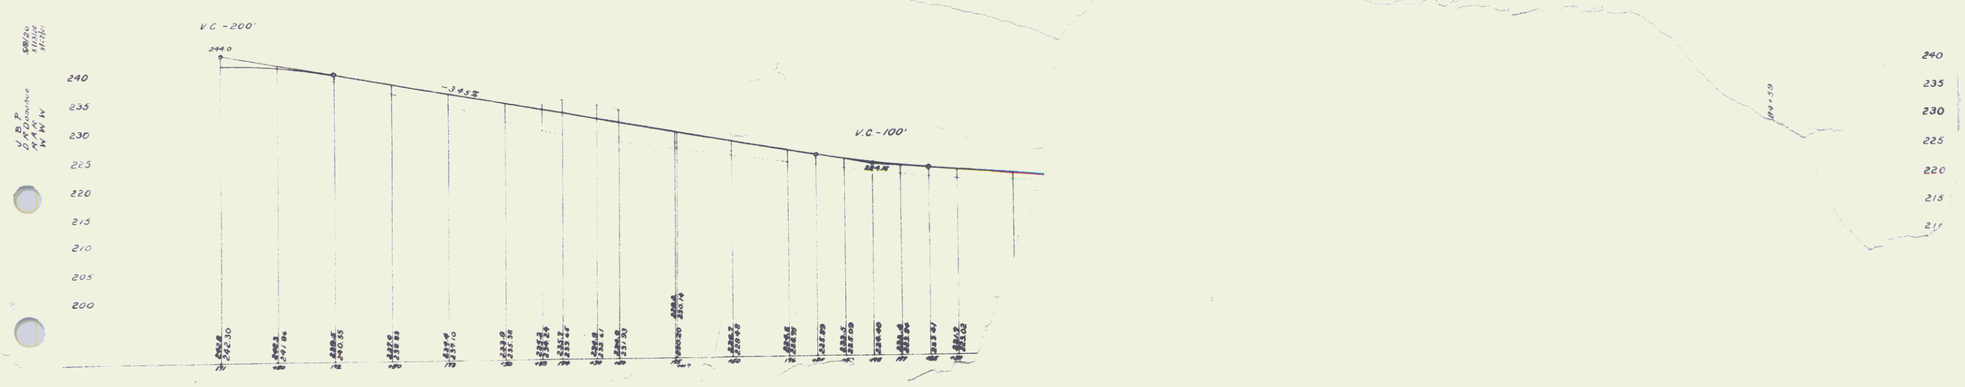

19