EST. No.	SHT. No.	TOTAL SHTS. IN PROJ.	DATE	SCALE	DRAWN	CHKD.
9	19	192-B	1923	20	84	



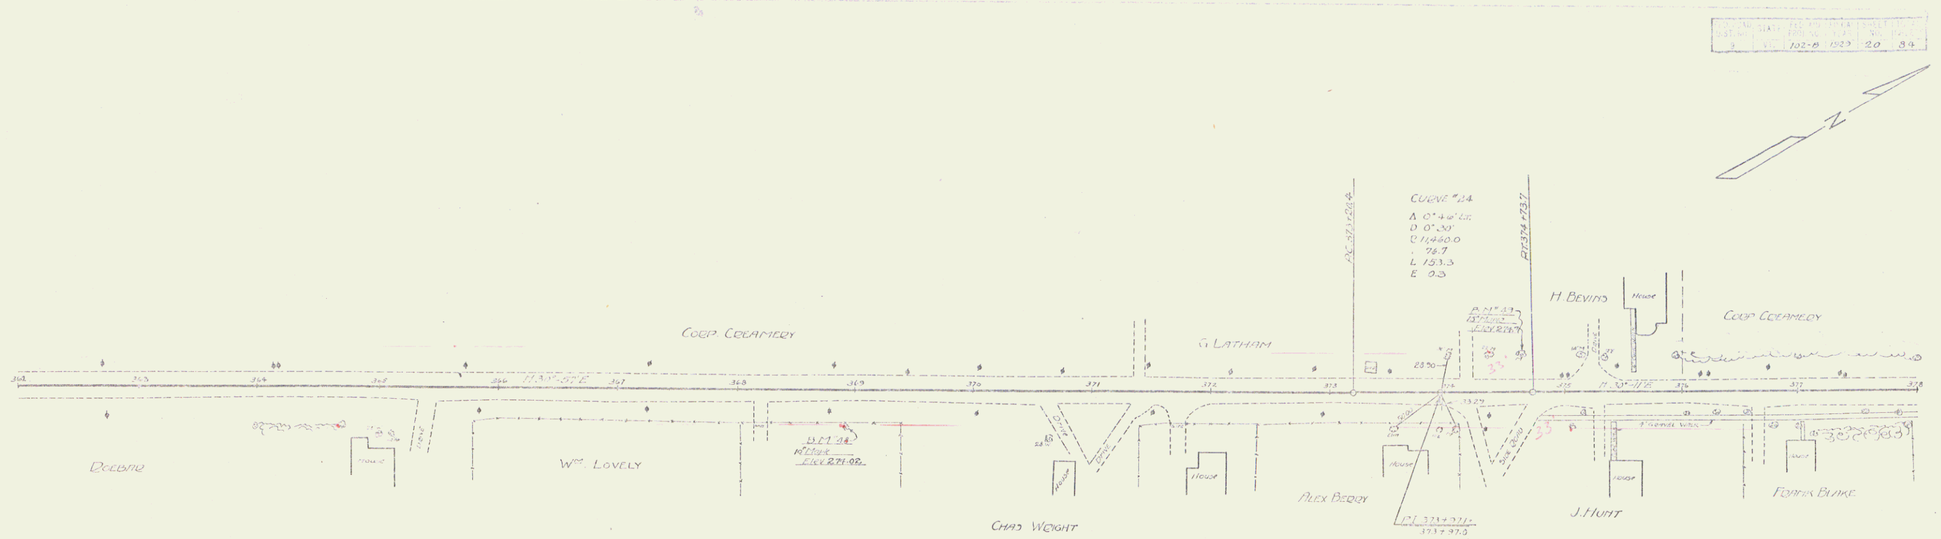

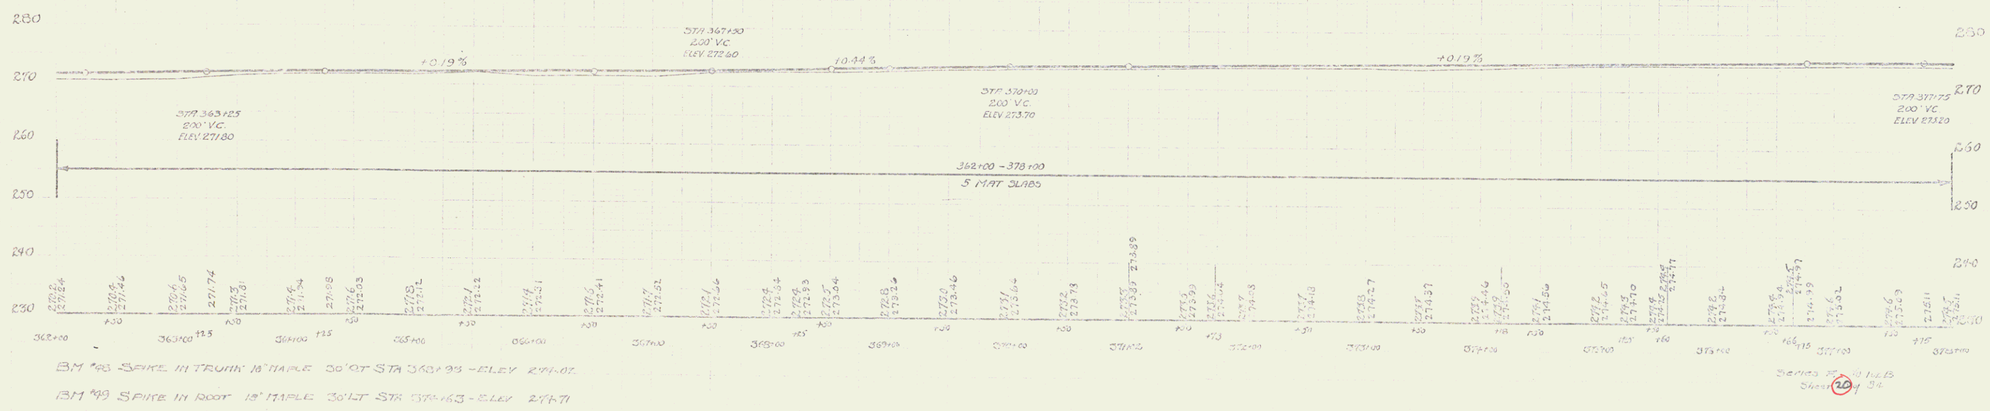

19