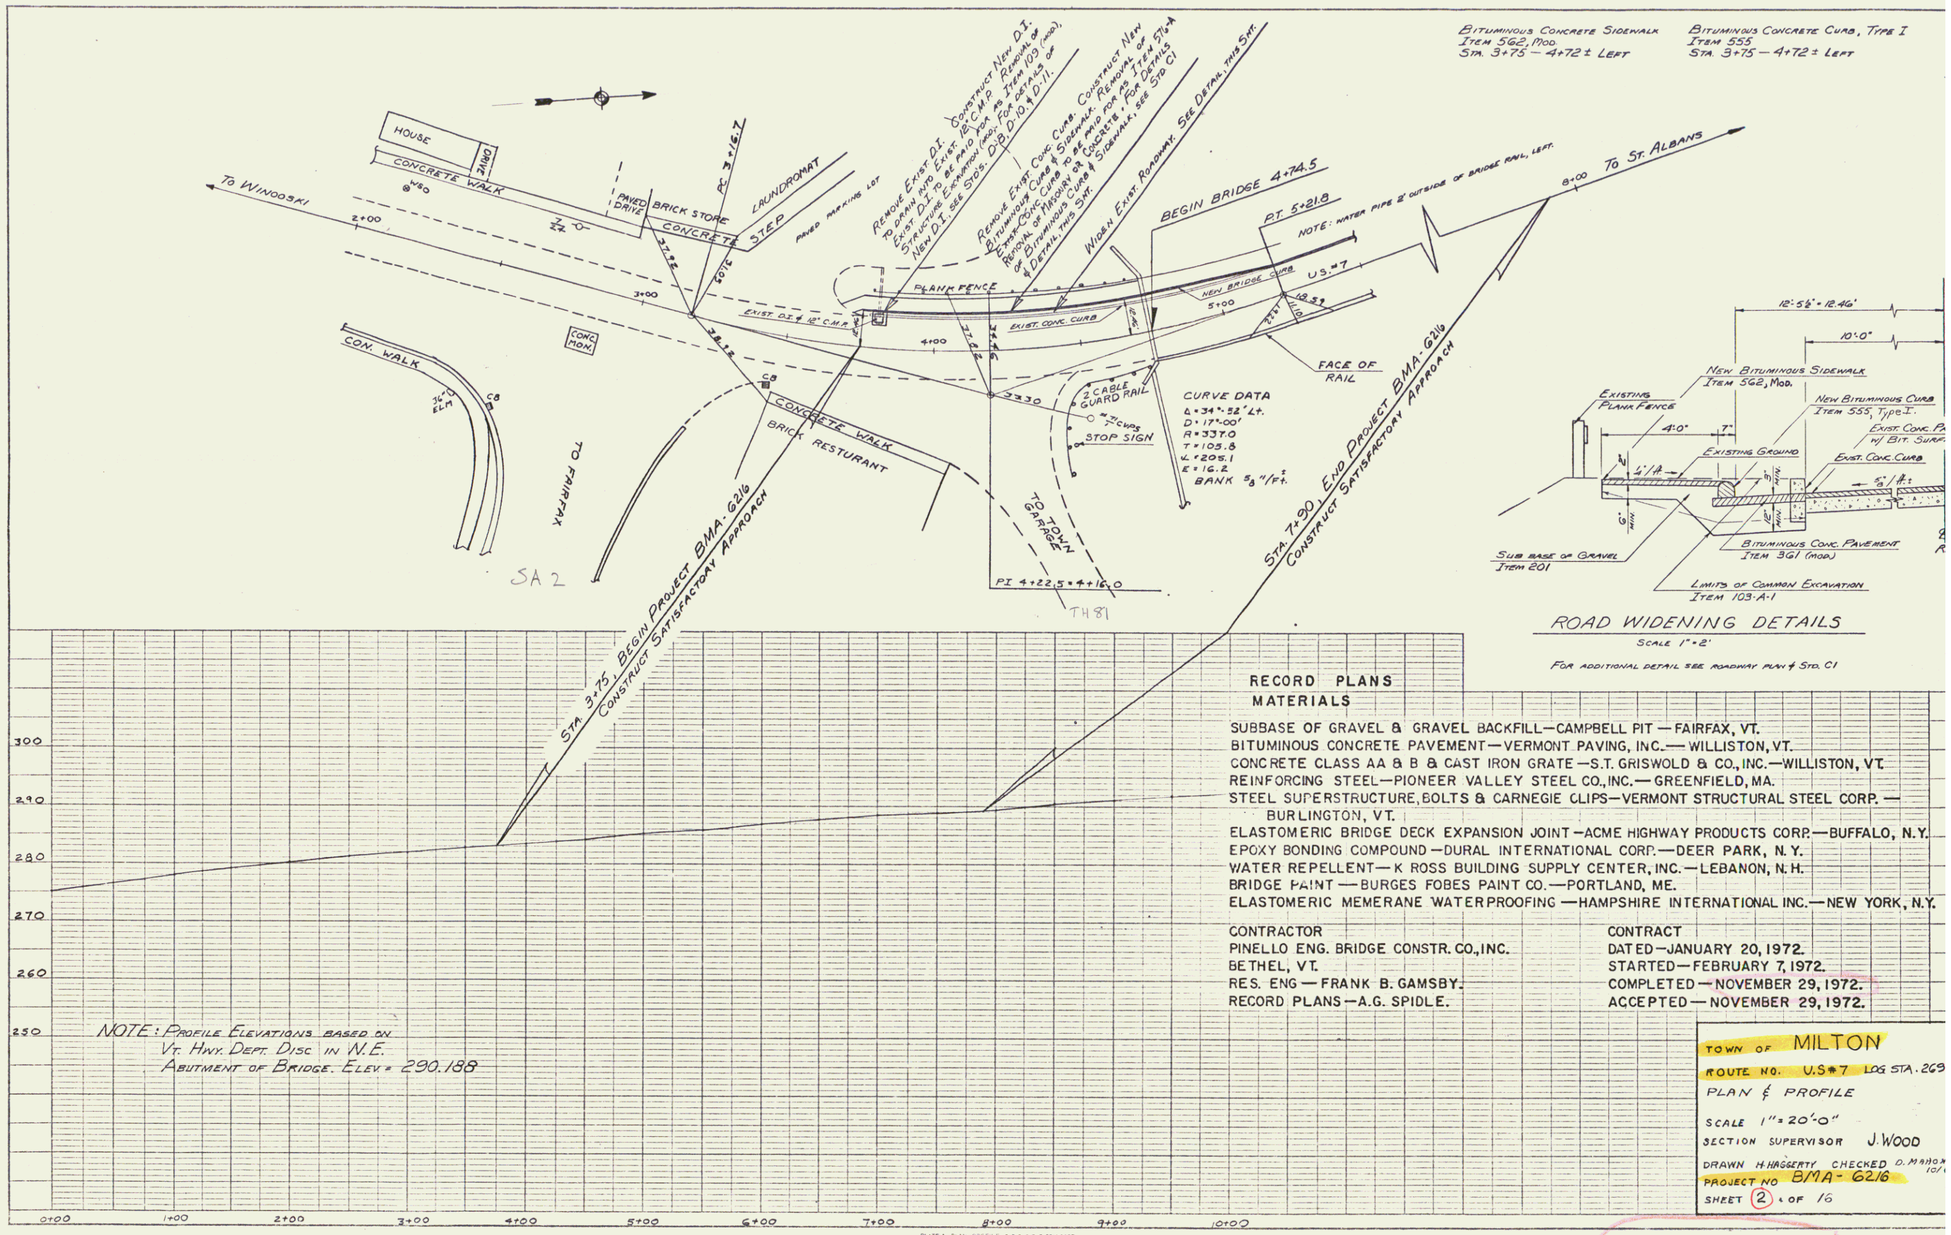

RECORD PLANS
MATERIALS

SUBBASE OF GRAVEL & GRAVEL BACKFILL—CAMPBELL PIT — FAIRFAX, VT.
BITUMINOUS CONCRETE PAVEMENT — VERMONT PAVING, INC.— WILLISTON, VT.
CONCRETE CLASS AA & B & CAST IRON GRATE — S.T. GRISWOLD & CO., INC.—WILLISTON, VT.
REINFORCING STEEL—PIONEER VALLEY STEEL CO., INC.— GREENFIELD, MA.
STEEL SUPERSTRUCTURE, BOLTS & CARNEGIE CLIPS—VERMONT STRUCTURAL STEEL CORP. — BURLINGTON, VT.
ELASTOMERIC BRIDGE DECK EXPANSION JOINT — ACME HIGHWAY PRODUCTS CORP.—BUFFALO, N.Y.
EPOXY BONDING COMPOUND — DURAL INTERNATIONAL CORP.—DEER PARK, N.Y.
WATER REPELLENT— K ROSS BUILDING SUPPLY CENTER, INC. — LEBANON, N.H.
BRIDGE PAINT — BURGES FOBES PAINT CO.—PORTLAND, ME.
ELASTOMERIC MEMERANE WATERPROOFING — HAMPSHIRE INTERNATIONAL INC.— NEW YORK, N.Y.

CONTRACTOR
PINELLO ENG. BRIDGE CONSTR. CO., INC.
BETHEL, VT.
RES. ENG — FRANK B. GAMSBY.
RECORD PLANS — A.G. SPIDLE.

CONTRACT
DATED — JANUARY 20, 1972.
STARTED — FEBRUARY 7, 1972.
COMPLETED — NOVEMBER 29, 1972.
ACCEPTED — NOVEMBER 29, 1972.

TOWN OF MILTON
ROUTE NO. U.S. #7 LOG STA. 269
PLAN & PROFILE
SCALE 1" = 20'-0"
SECTION SUPERVISOR J. WOOD
DRAWN H. HAGGERTY CHECKED D. MATTON 10/
PROJECT NO BMA-6216
SHEET 2 OF 16

PLATE 1 - PLAN - PROFILE O.P.R. & R.E. STANDARD
KEUFFEL & ESSER CO., NEW YORK.

2