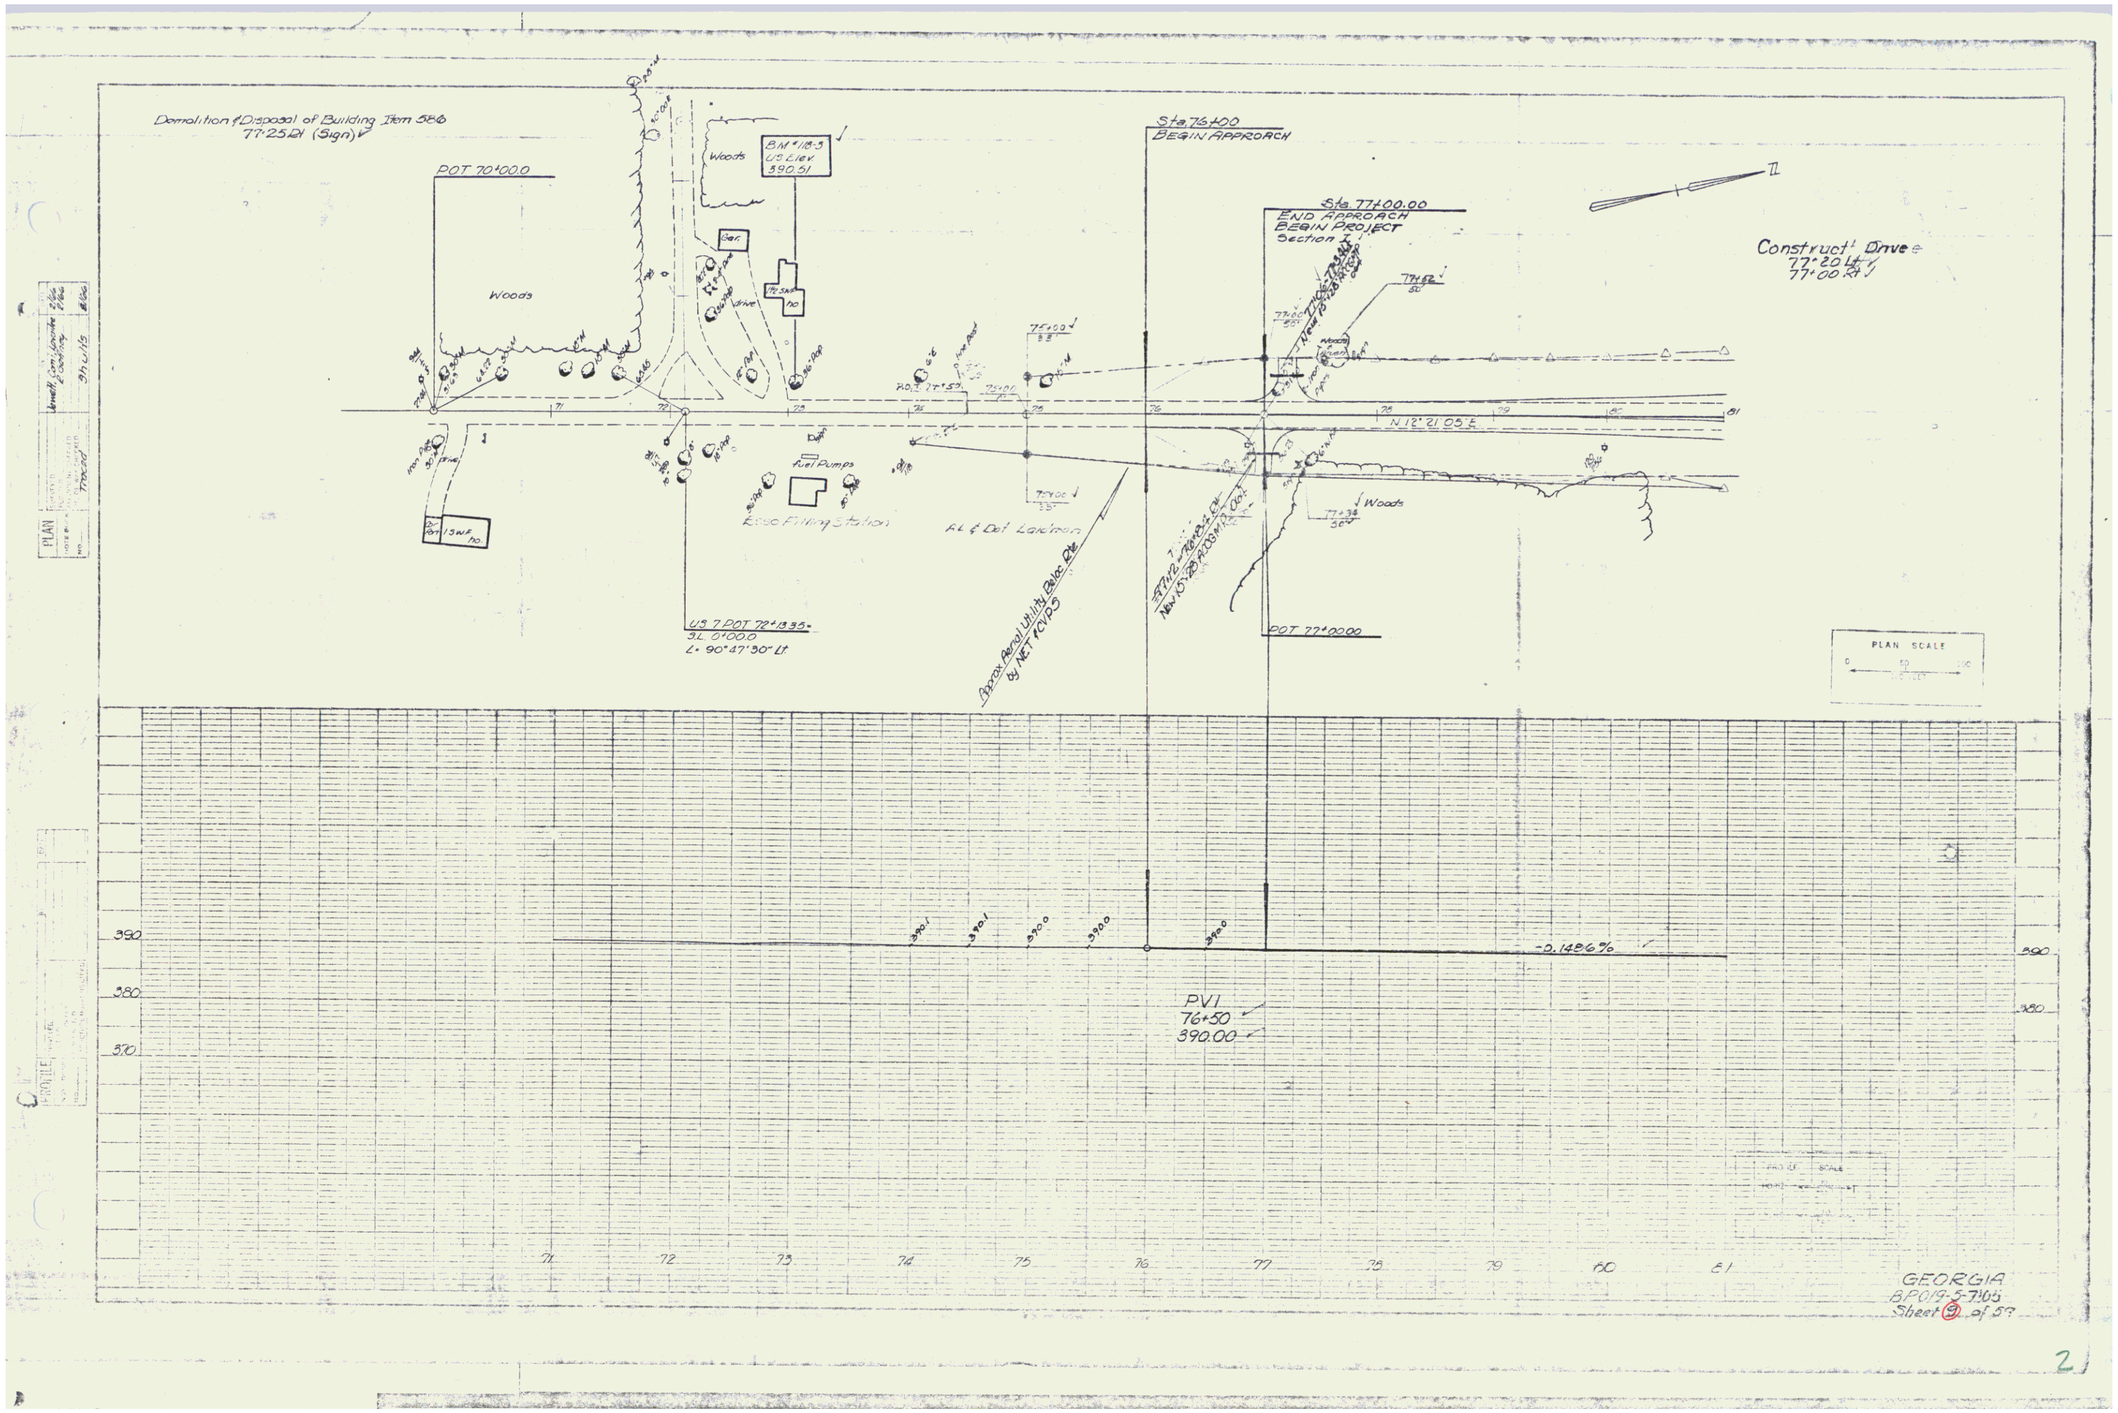
Demolition & Disposal of Building Item 5E6
77+25.21 (Sign)
POT 70+00.0
Woods
BM #18-3
US Elev
390.51
Bar.
Sta 76+00
BEGIN APPROACH
Sta 77+00.00
END APPROACH
BEGIN PROJECT
Section I
Construct' Drive
77+20 Lt.
77+00 Rt.
N 12° 21' 05" E
Woods
Fuel Pumps
Esso Filling Station
AL & Dot Location
US 7 POT 72+13.35
SL 0+00.0
L = 90° 47' 50" Lt.
Approx. Aerial Utility Poles Rte
by NET Corps
POT 77+00.00
PLAN SCALE
-0.1486%
PVI
76+50
390.00
390
380
370
71
72
73
74
75
76
77
78
79
80
81
GEORGIA
BP019-5-7105
Sheet 9 of 59

2