52-B 1928 12 79

WOOD GUARD RAIL REQUIRED

ON LEFT
Sta 247+27 to Sta 247+51 Length 24 ft

ON RIGHT
Sta 247+27 to Sta 247+51 Length 24 ft

CABLE GUARD RAIL REQUIRED

ON LEFT
Sta 240+80 to Sta 241+76 Length 96 ft

ON RIGHT
Sta 240+80 to Sta 241+76 Length 96 ft

NEW CULVERTS REQUIRED.

Sta. 241+62 5'x5' Reinf. Conc. Box Culvert.
See Sheet 27 for Details of Construction.

Sta. 247+39 3'x3' Reinf. Conc. Box Culvert.
Concrete Class A (1-2-4) 15.3 cu. yds.
Reinforcing Steel 993 pounds.

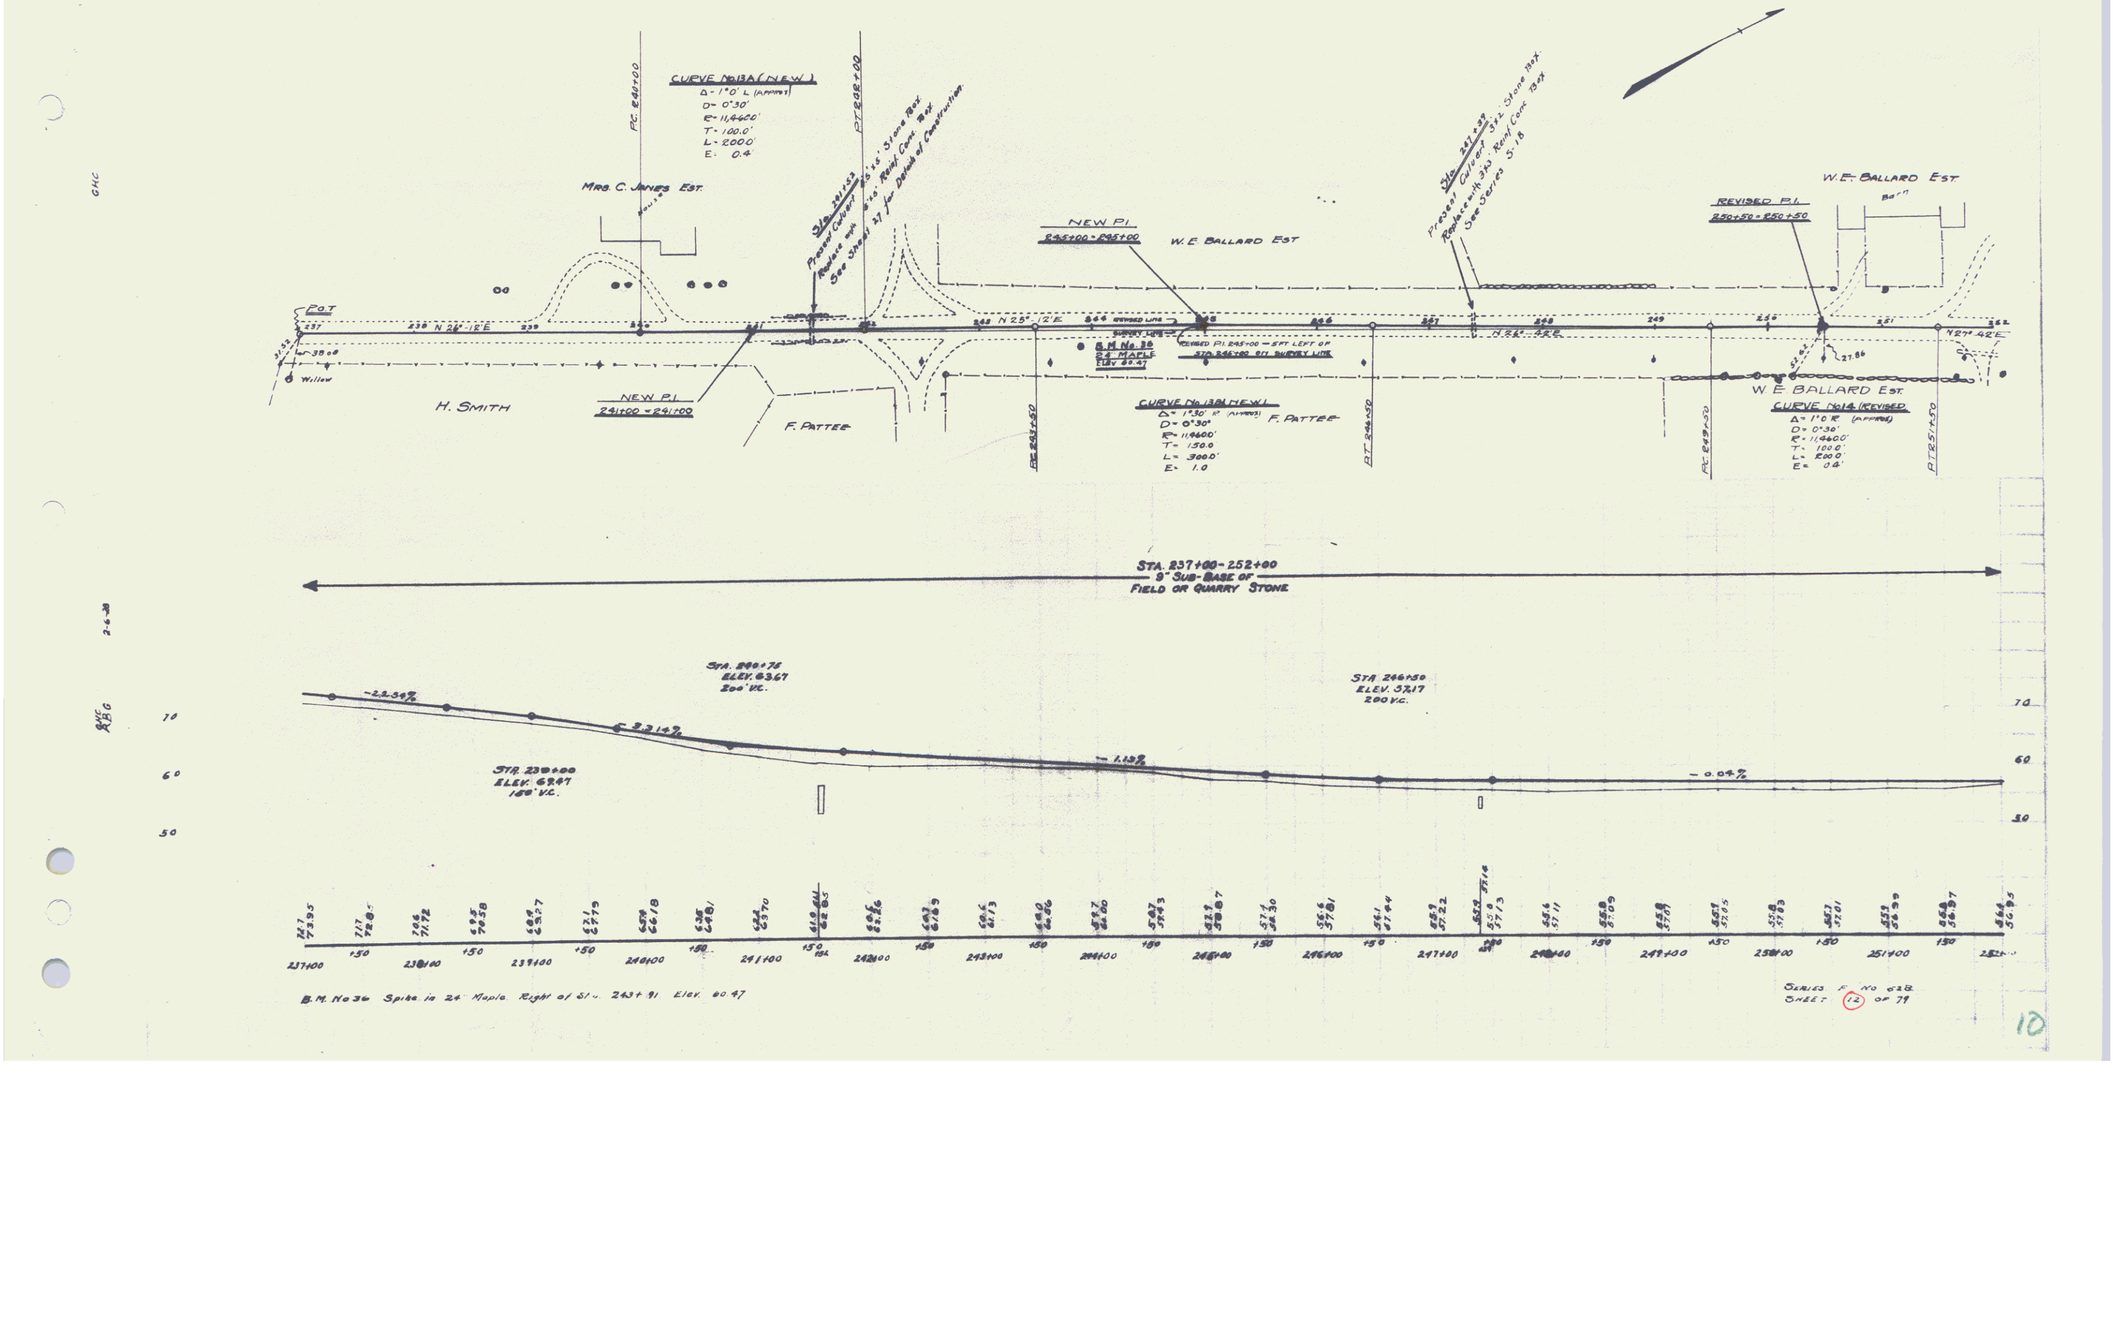

B.M. No 36 Spike in 24" Maple Right of Sta. 243+91 Elev. 60.47

Series E No 628
Sheet 12 of 79

10