WOOD GUARD RAIL REQUIRED

ON LEFT
Sta. 306+70 to Sta. 306+94 Length 24 ft.

ON RIGHT
Sta. 306+70 to Sta. 306+94 Length 24 ft.

CABLE GUARD RAIL REQUIRED

ON LEFT
Sta. 299+72 to Sta. 301+00 Length 128 ft.

ON RIGHT
Sta. 300+20 to Sta. 302+52 Length 232 ft.

NEW CULVERTS REQUIRED

Sta. 306+82 16" Cast Iron Pipe Culvert 32 ft.
Concrete Class B (1:2:4) 2.7 Cu. Yds.
Reinforcing Steel 33 pounds.

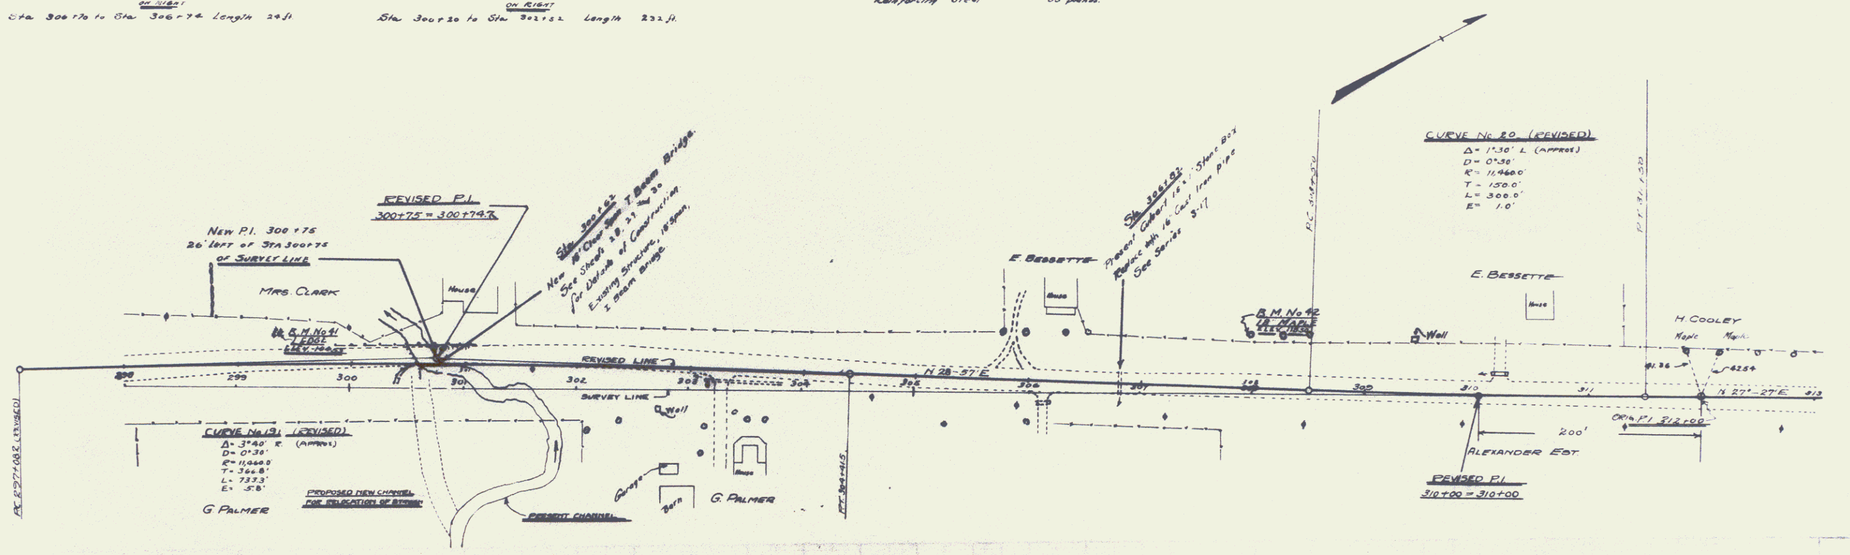

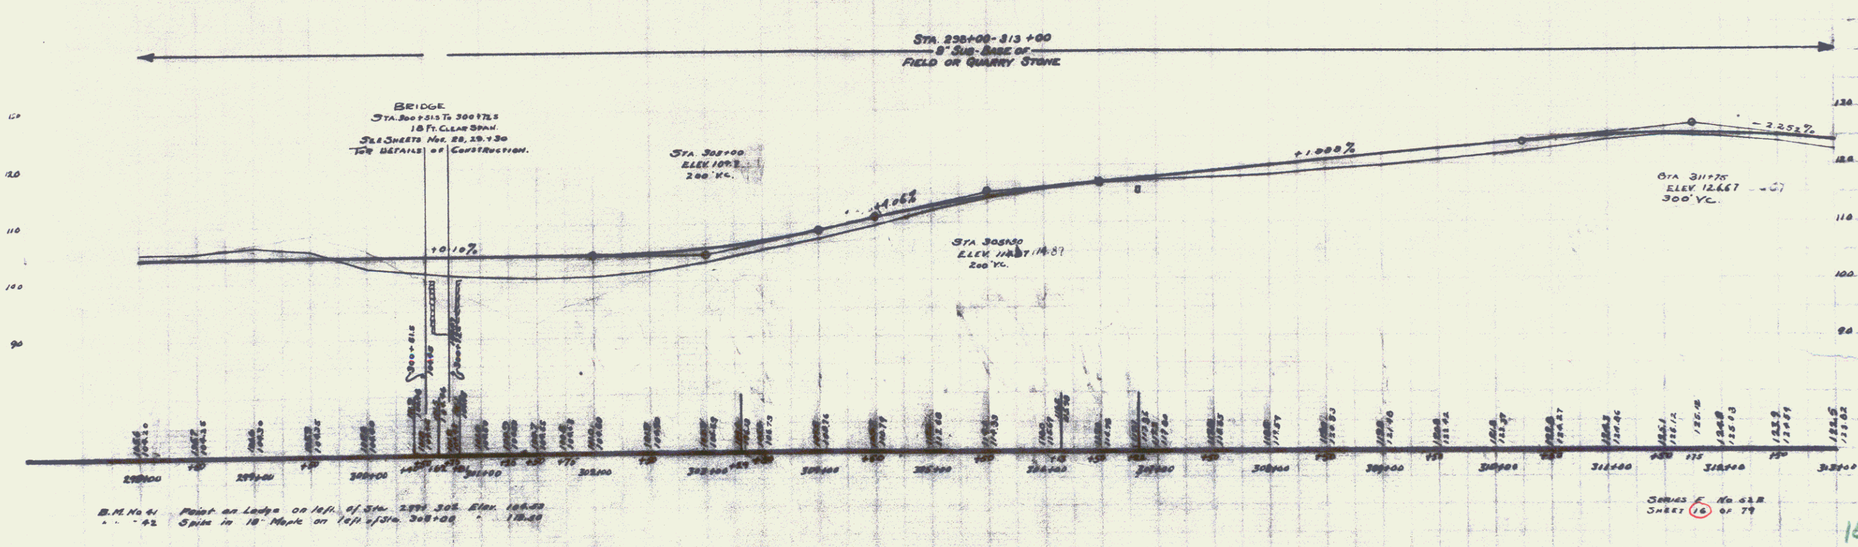

14