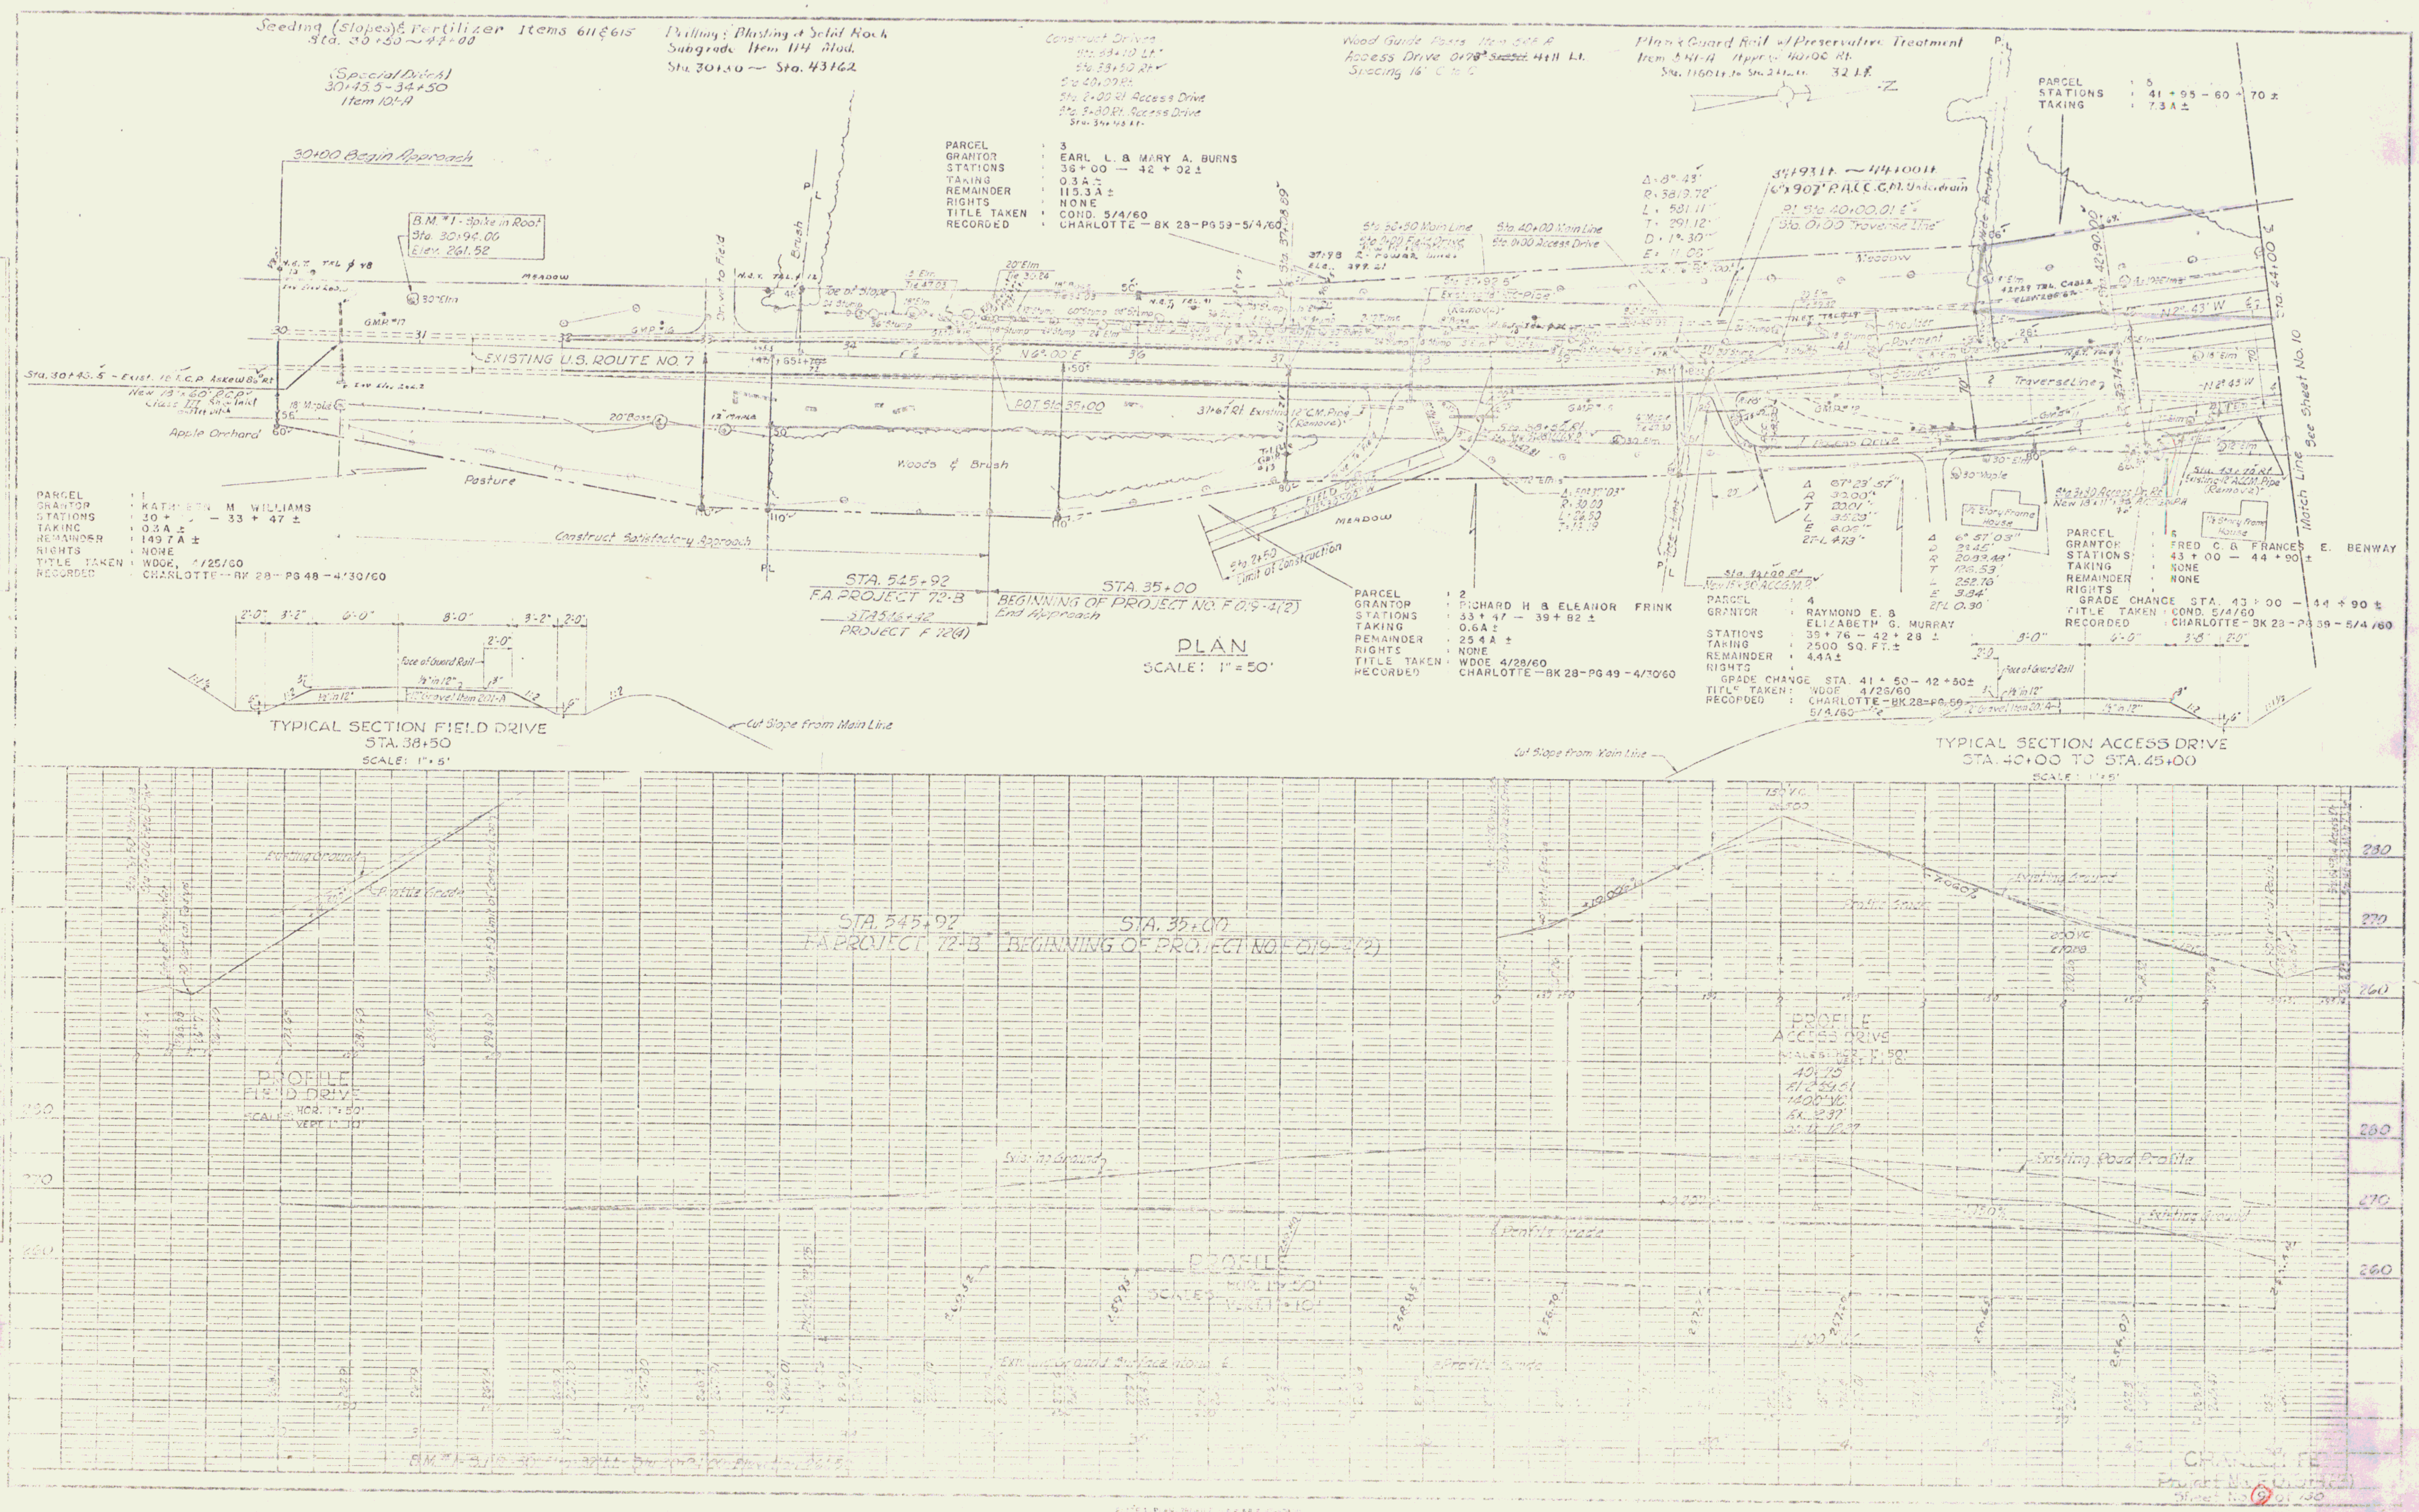

Seeding (Slopes) & Fertilizer Items 611 & 615
Sta. 30+50 ~ 47+00
(Special Ditch)
30+45.5 - 34+50
Item 101-A
Drilling; Blasting & Solid Rock
Subgrade Item 114 Mod.
Sta. 30+30 — Sta. 43+62
Construct Drives
Sta. 33+10 Lt.
Sta. 33+50 Rt.
Sta. 40+00 Rt.
Sta. 2+00 Rt. Access Drive
Sta. 3+80 Rt. Access Drive
Wood Guide Posts Item 568 A
Access Drive 0+78 4+11 Lt.
Spacing 16' C to C
Plank Guard Rail w/ Preservative Treatment
Item 581-A
30+00 Begin Approach
B.M. #1 - Spike in Root
Sta. 30+94.00
Elev. 261.52
EXISTING U.S. ROUTE NO. 7
Sta. 30+45.5 - Exist. 18" C.P. Askew 86° Rt.
New 18"x60' R.C.P. Class III Shu Inlet
Apple Orchard
Pasture
Meadow
Woods & Brush
Construct Satisfactory Approach
PARCEL : 1
GRANTOR : KATHLEEN M. WILLIAMS
STATIONS : 30 + — 33 + 47 ±
TAKING : 0.3 A ±
REMAINDER : 149.7 A ±
RIGHTS : NONE
TITLE TAKEN : WDOE, 4/25/60
RECORDED : CHARLOTTE — BK 28 — PG 48 — 4/30/60
PARCEL : 3
GRANTOR : EARL L. & MARY A. BURNS
STATIONS : 36 + 00 — 42 + 02 ±
TAKING : 0.3 A ±
REMAINDER : 115.3 A ±
RIGHTS : NONE
TITLE TAKEN : COND. 5/4/60
RECORDED : CHARLOTTE — BK 28 — PG 59 — 5/4/60
PARCEL : 5
STATIONS : 41 + 95 — 60 + 70 ±
TAKING : 7.3 A ±
Δ = 8° 43'
R = 3819.72'
L = 581.11'
T = 291.12'
D = 1° 30'
E = 11.00'
34+93 Lt. ~ 44+00 Lt.
6"x 907' P.A.C.C.G.M. Underdrain
P.I. Sta. 40+00.01
Sta. 0+00 Traverse Line
Traverse Line
Match Line See Sheet No. 10
Sta. 44+00
STA. 545+92
F.A. PROJECT 72-B
STA. 546+42
PROJECT F 72(4)
STA. 35+00
BEGINNING OF PROJECT NO. F 019-4(2)
End Approach
Sta. 2+50 Limit of Construction
FIELD DRIVE
PLAN
SCALE: 1" = 50'
PARCEL : 2
GRANTOR : RICHARD H. & ELEANOR FRINK
STATIONS : 33 + 47 — 39 + 82 ±
TAKING : 0.6 A ±
REMAINDER : 25.4 A ±
RIGHTS : NONE
TITLE TAKEN : WDOE 4/28/60
RECORDED : CHARLOTTE — BK 28 — PG 49 — 4/30/60
PARCEL : 4
GRANTOR : RAYMOND E. & ELIZABETH G. MURRAY
STATIONS : 39 + 76 — 42 + 28 ±
TAKING : 2500 SQ. FT. ±
REMAINDER : 4.4 A ±
RIGHTS :
GRADE CHANGE STA. 41 + 50 — 42 + 50 ±
TITLE TAKEN : WDOE 4/26/60
RECORDED : CHARLOTTE — BK 28 — PG 59 5/4/60
PARCEL : 6
GRANTOR : FRED C. & FRANCES E. BENWAY
STATIONS : 43 + 00 — 44 + 90 ±
TAKING : NONE
REMAINDER : NONE
RIGHTS :
GRADE CHANGE STA. 43 + 00 — 44 + 90 ±
TITLE TAKEN : COND. 5/4/60
RECORDED : CHARLOTTE — BK 28 — PG 59 — 5/4/60
1½ Story Frame House
Face of Guard Rail
12" Gravel Item 201-A
Cut Slope from Main Line
TYPICAL SECTION FIELD DRIVE
STA. 38+50
SCALE: 1" = 5'
TYPICAL SECTION ACCESS DRIVE
STA. 40+00 TO STA. 45+00
SCALE: 1" = 5'
Existing Ground
Profile Grade
PROFILE
FIELD DRIVE
SCALES: HOR. 1" = 50' VERT. 1" = 10'
STA. 545+92
F.A. PROJECT 72-B
STA. 35+00
BEGINNING OF PROJECT NO. F 019-4(2)
PROFILE
ACCESS DRIVE
SCALES: HOR. 1" = 50' VERT. 1" = 10'
Existing Road Profile
PROFILE
SCALES: HOR. 1" = 50' VERT. 1" = 10'
280
270
260
CHARLOTTE
Project No. F 019-4(2)
Sheet No. 9 of 30