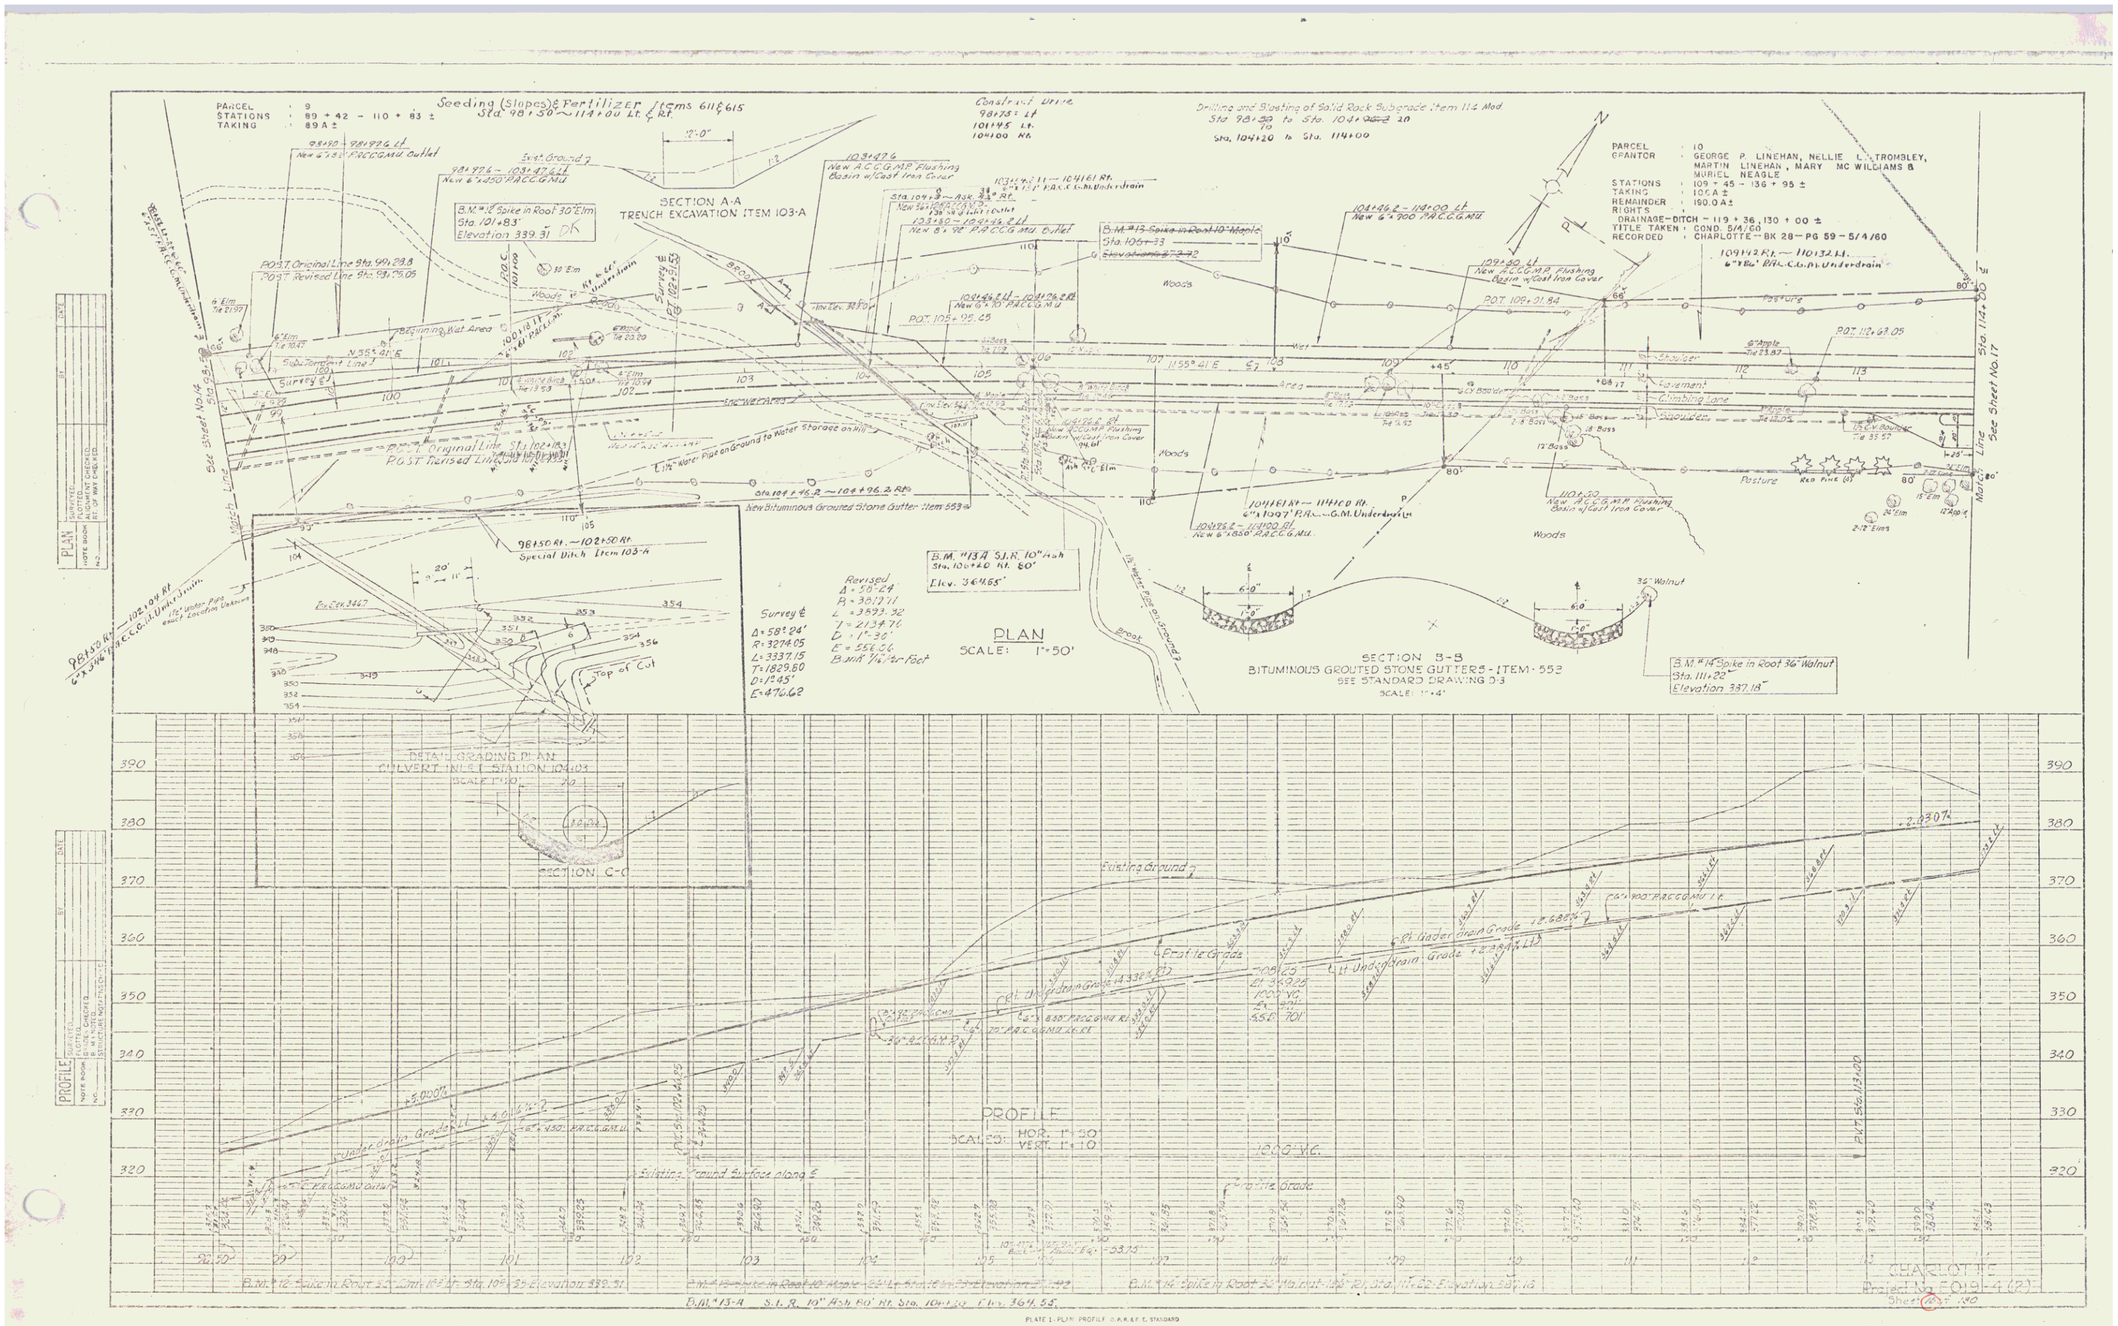

PLATE 1: PLAN PROFILE & P.R.&F.E. STANDARD
KEUFFEL & ESSER CO., NEW YORK.

8