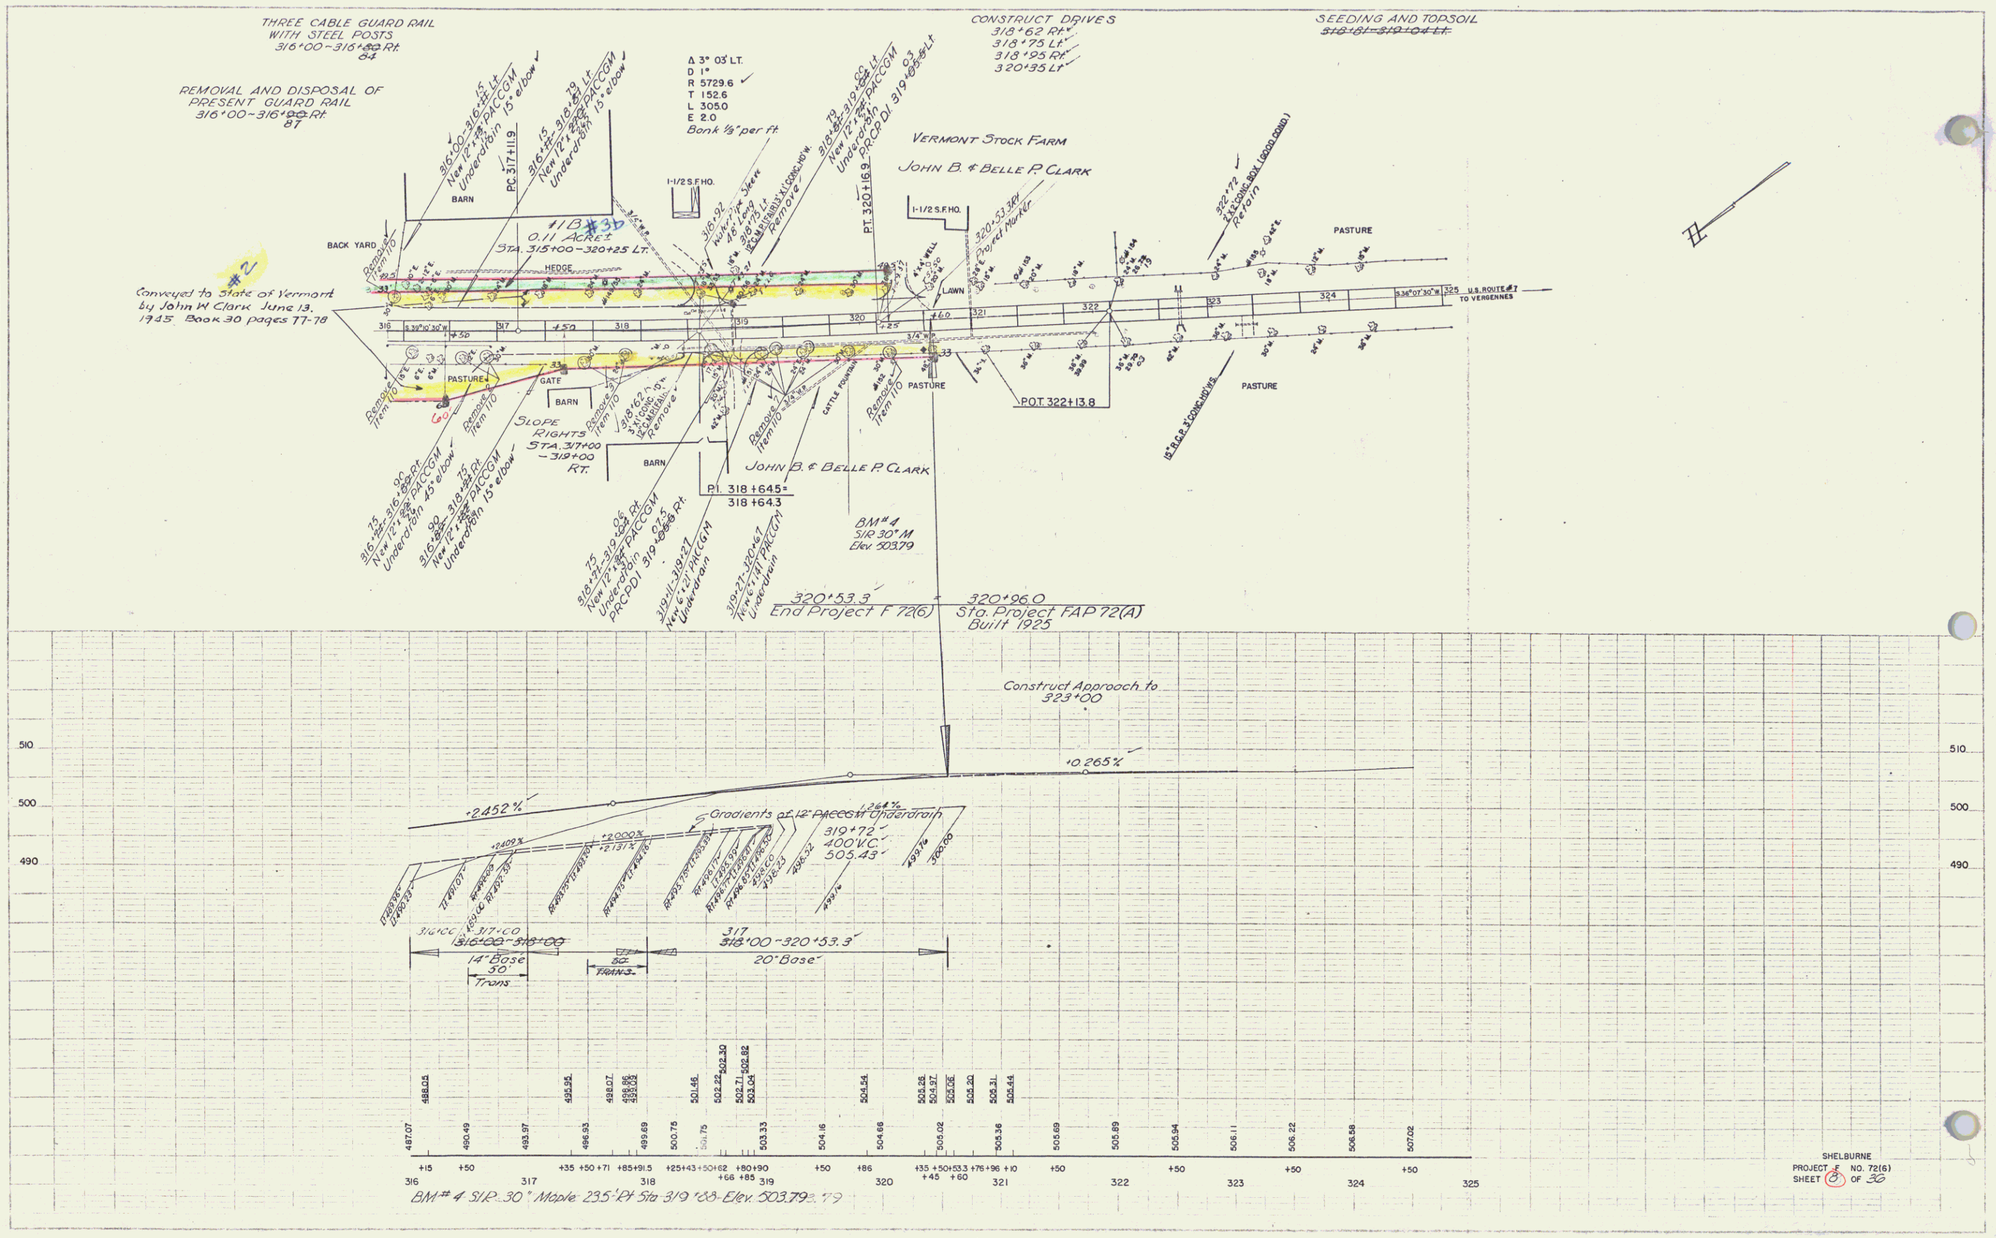

SHELBURNE
PROJECT F NO. 72(6)
SHEET 8 OF 30