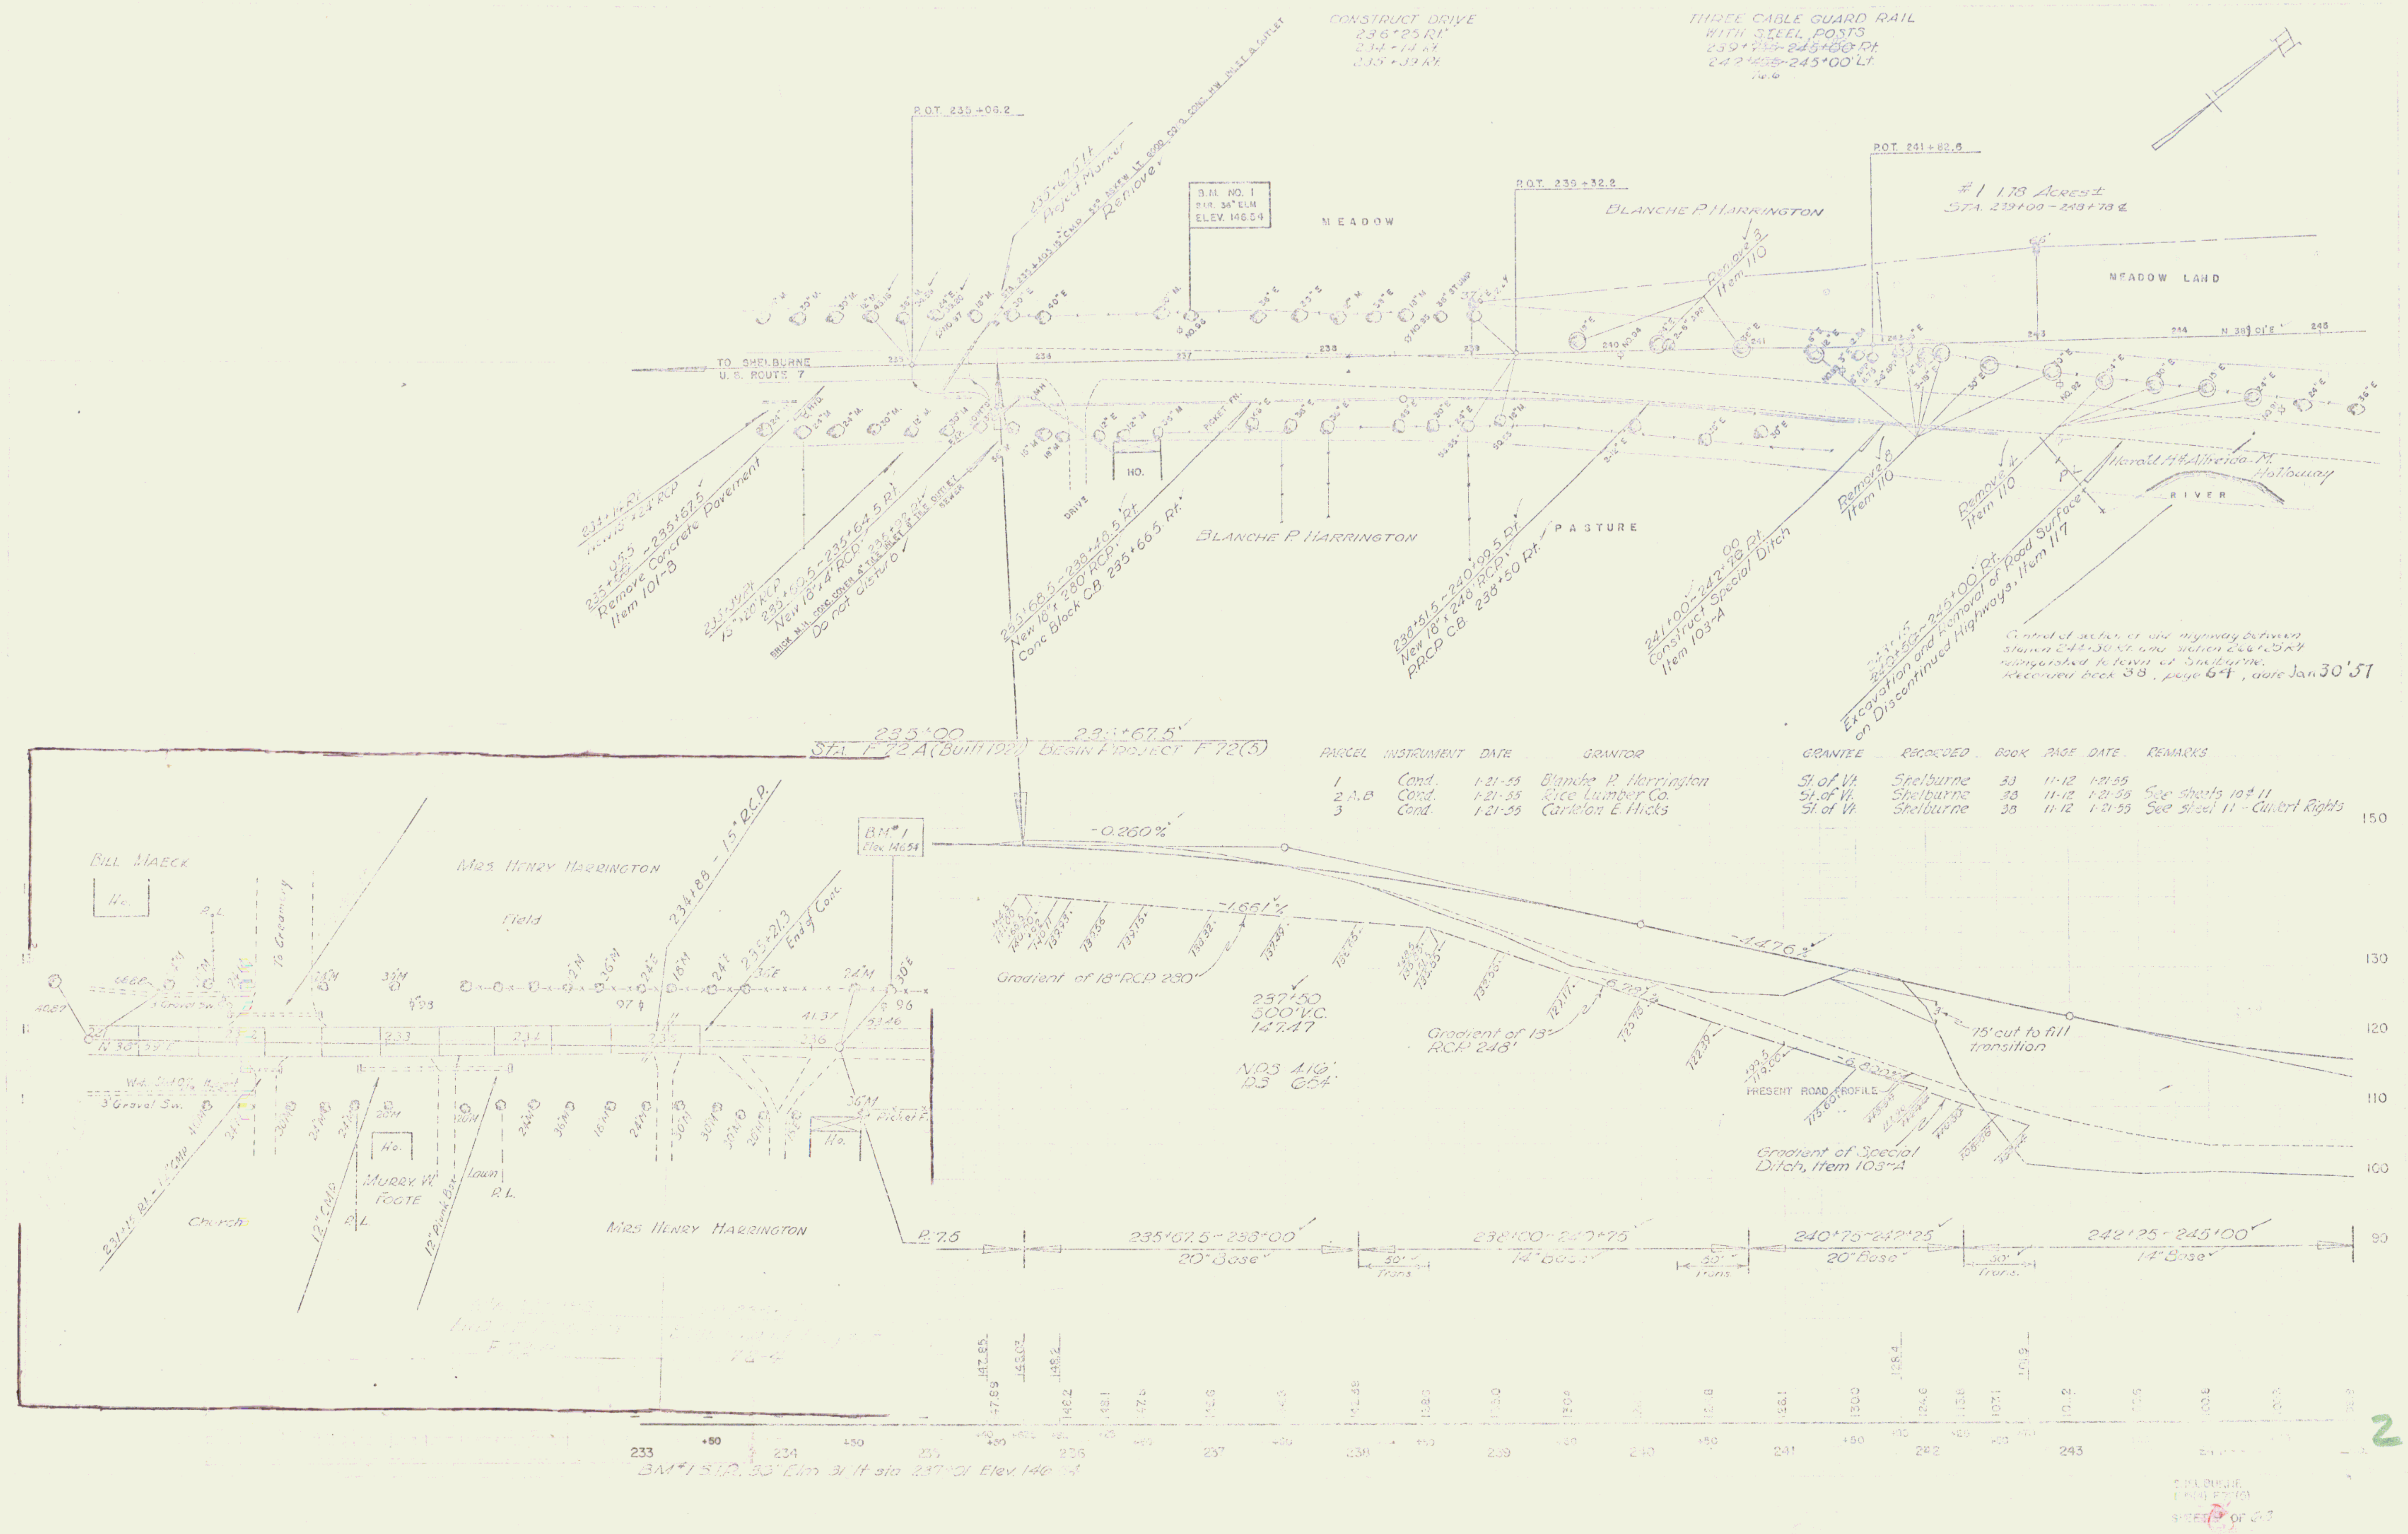

PARCEL	INSTRUMENT	DATE	GRANTOR	GRANTEE	RECORDED	BOOK	PAGE	DATE	REMARKS
1	Cond.	1-21-55	Blanche P. Harrington	St. of Vt.	Shelburne	38	11-12	1-21-55	
2 A,B	Cond.	1-21-55	Rice Lumber Co.	St. of Vt.	Shelburne	38	11-12	1-21-55	See sheets 10 & 11
3	Cond.	1-21-55	Carleton E. Hicks	St. of Vt.	Shelburne	38	11-12	1-21-55	See sheet 11 - Culvert Rights