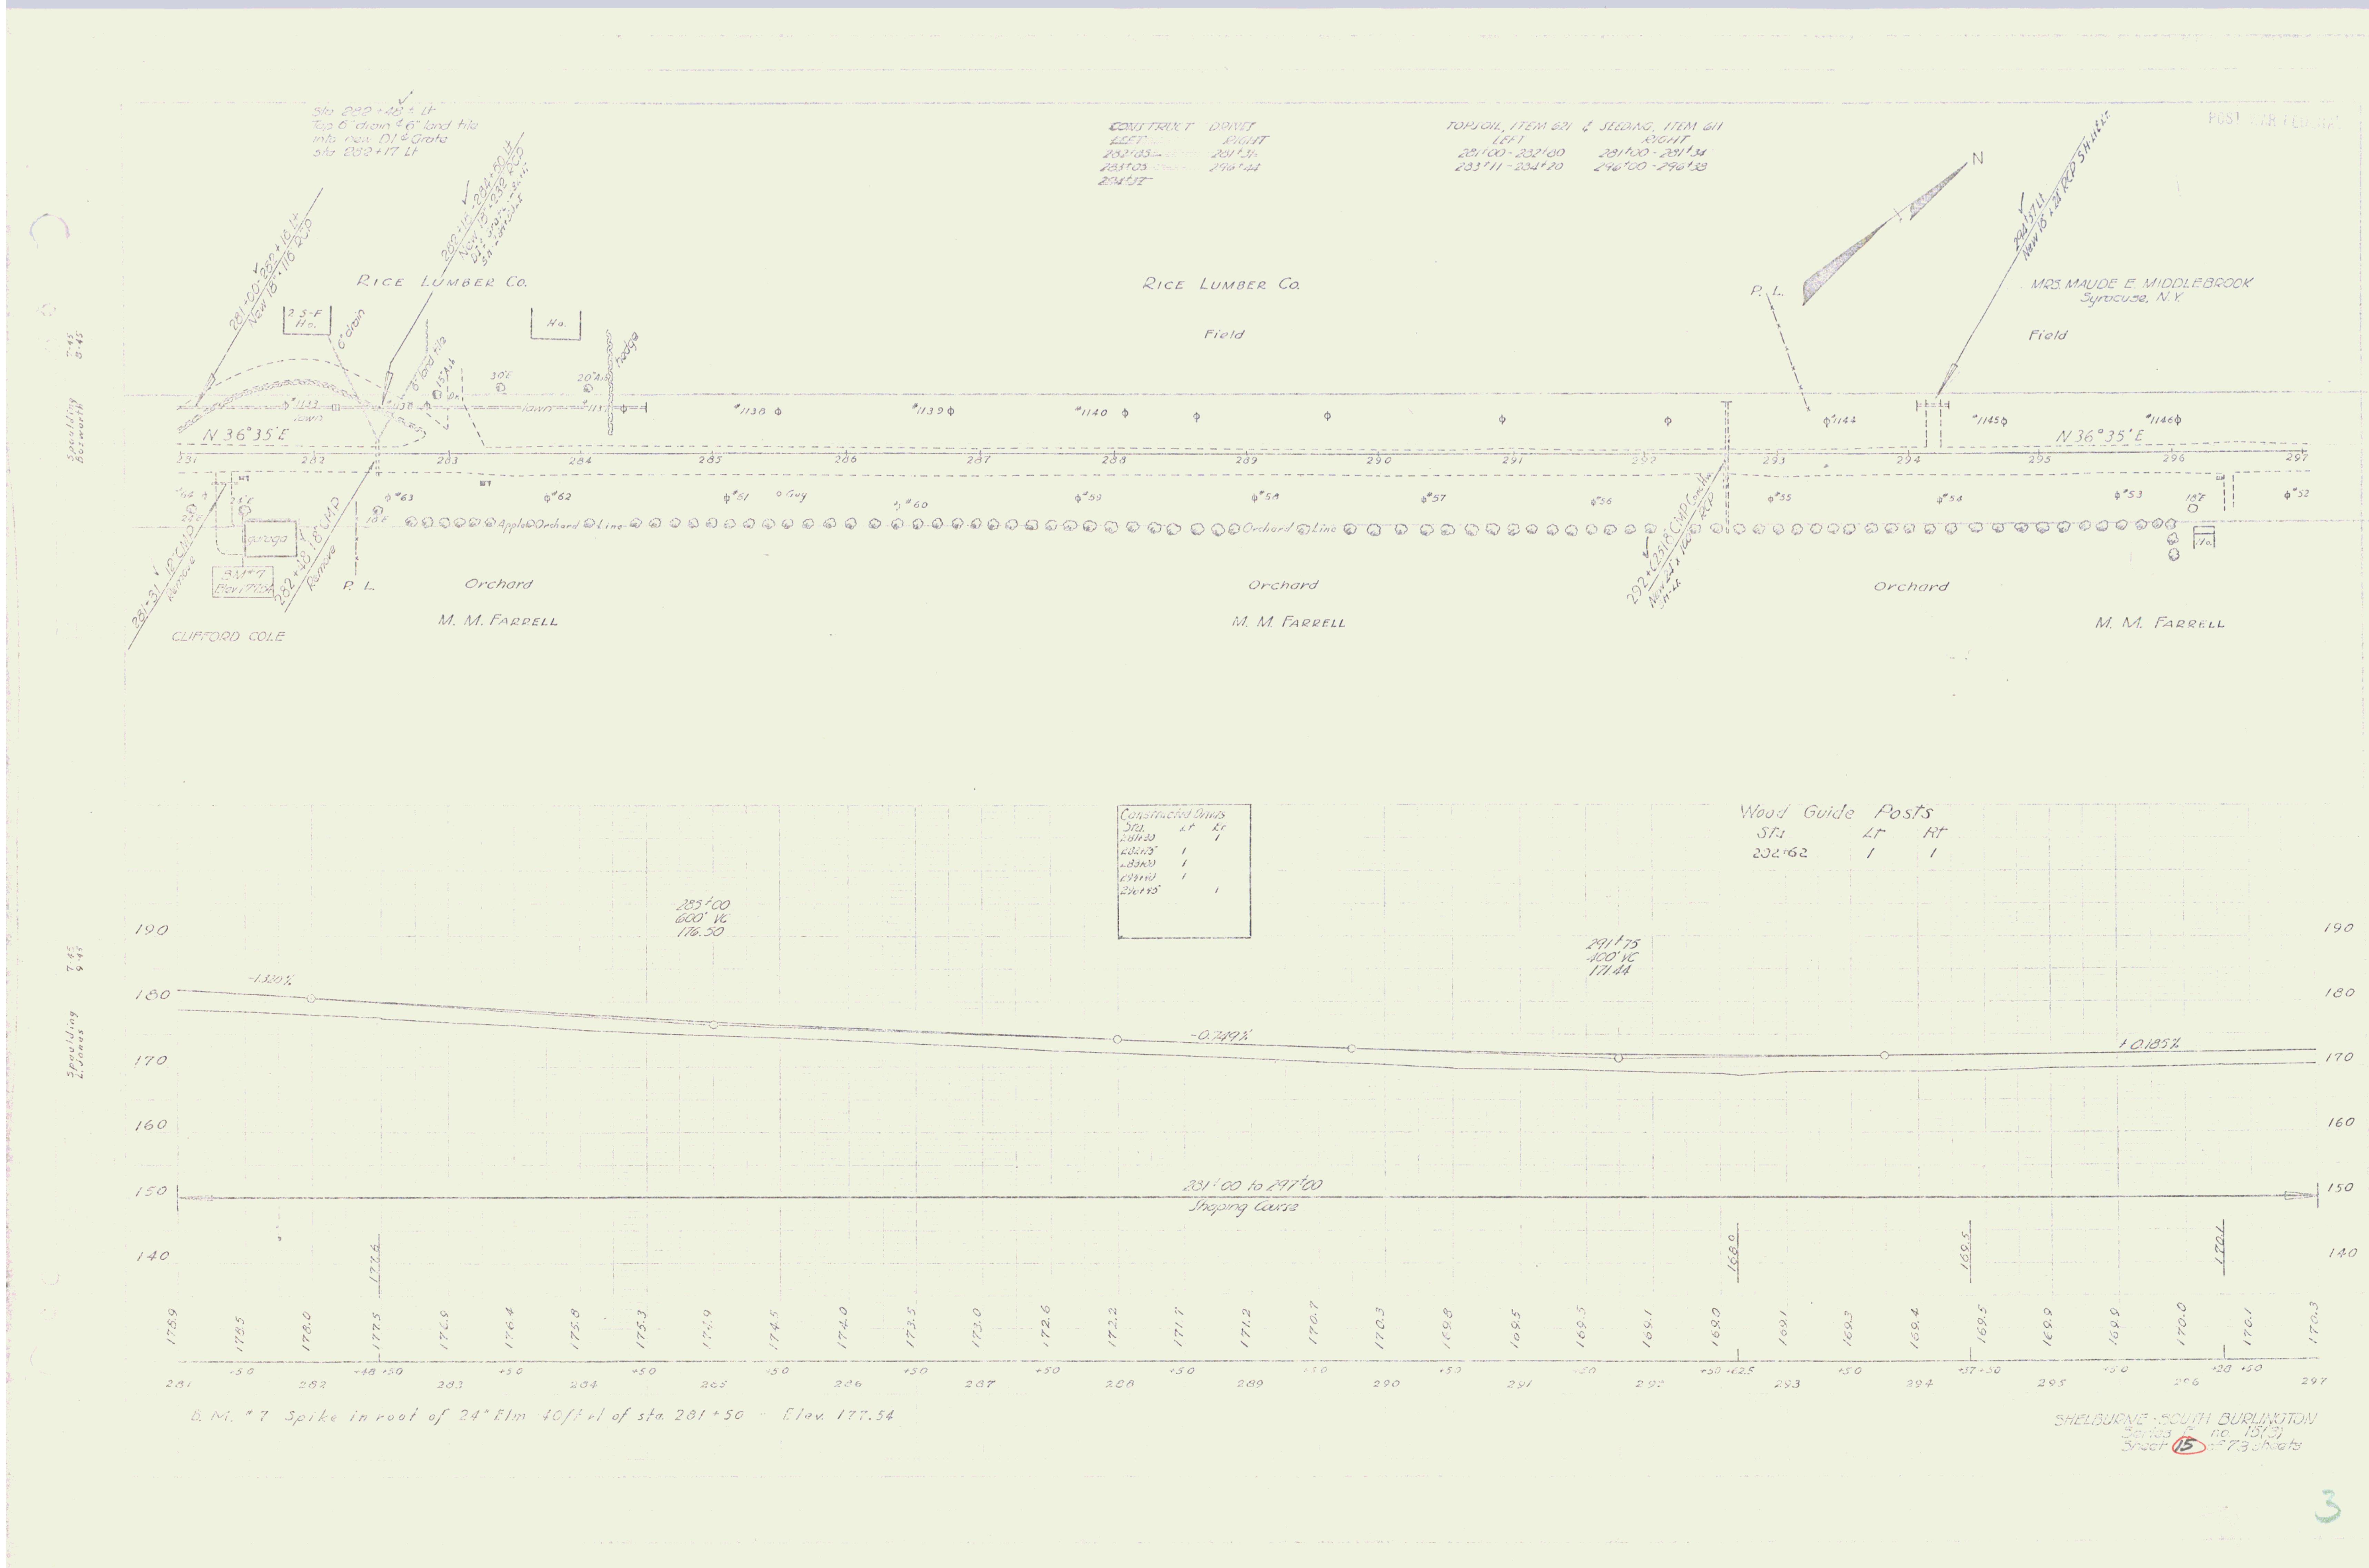

CONSTRUCT DRIVES
LEFT RIGHT
282+85 281+31
283+05 296+44
284+37
TOPSOIL, ITEM 621 & SEEDING, ITEM 611
LEFT RIGHT
281+00 - 282+80 281+00 - 281+34
283+11 - 284+20 296+00 - 296+38
RICE LUMBER Co.
RICE LUMBER Co.
Field
MRS. MAUDE E. MIDDLEBROOK
Syracuse, N.Y.
Field
N
P. L.
N 36°35' E
N 36°35' E
Orchard
M. M. FARRELL
Orchard
M. M. FARRELL
Orchard
M. M. FARRELL
CLIFFORD COLE
Wood Guide Posts
STA. LT. RT.
292+62 1 1
283+00
600' VC
176.50
291+75
400' VC
171.44
-1.320%
-0.389%
+0.185%
281+00 to 297+00
Shaping Course
B. M. #7 Spike in root of 24" Elm 40 ft. Lt. of sta. 281+50 - Elev. 177.54
SHELBURNE - SOUTH BURLINGTON
Series F no. 15(3)
Sheet 15 of 73 sheets
3