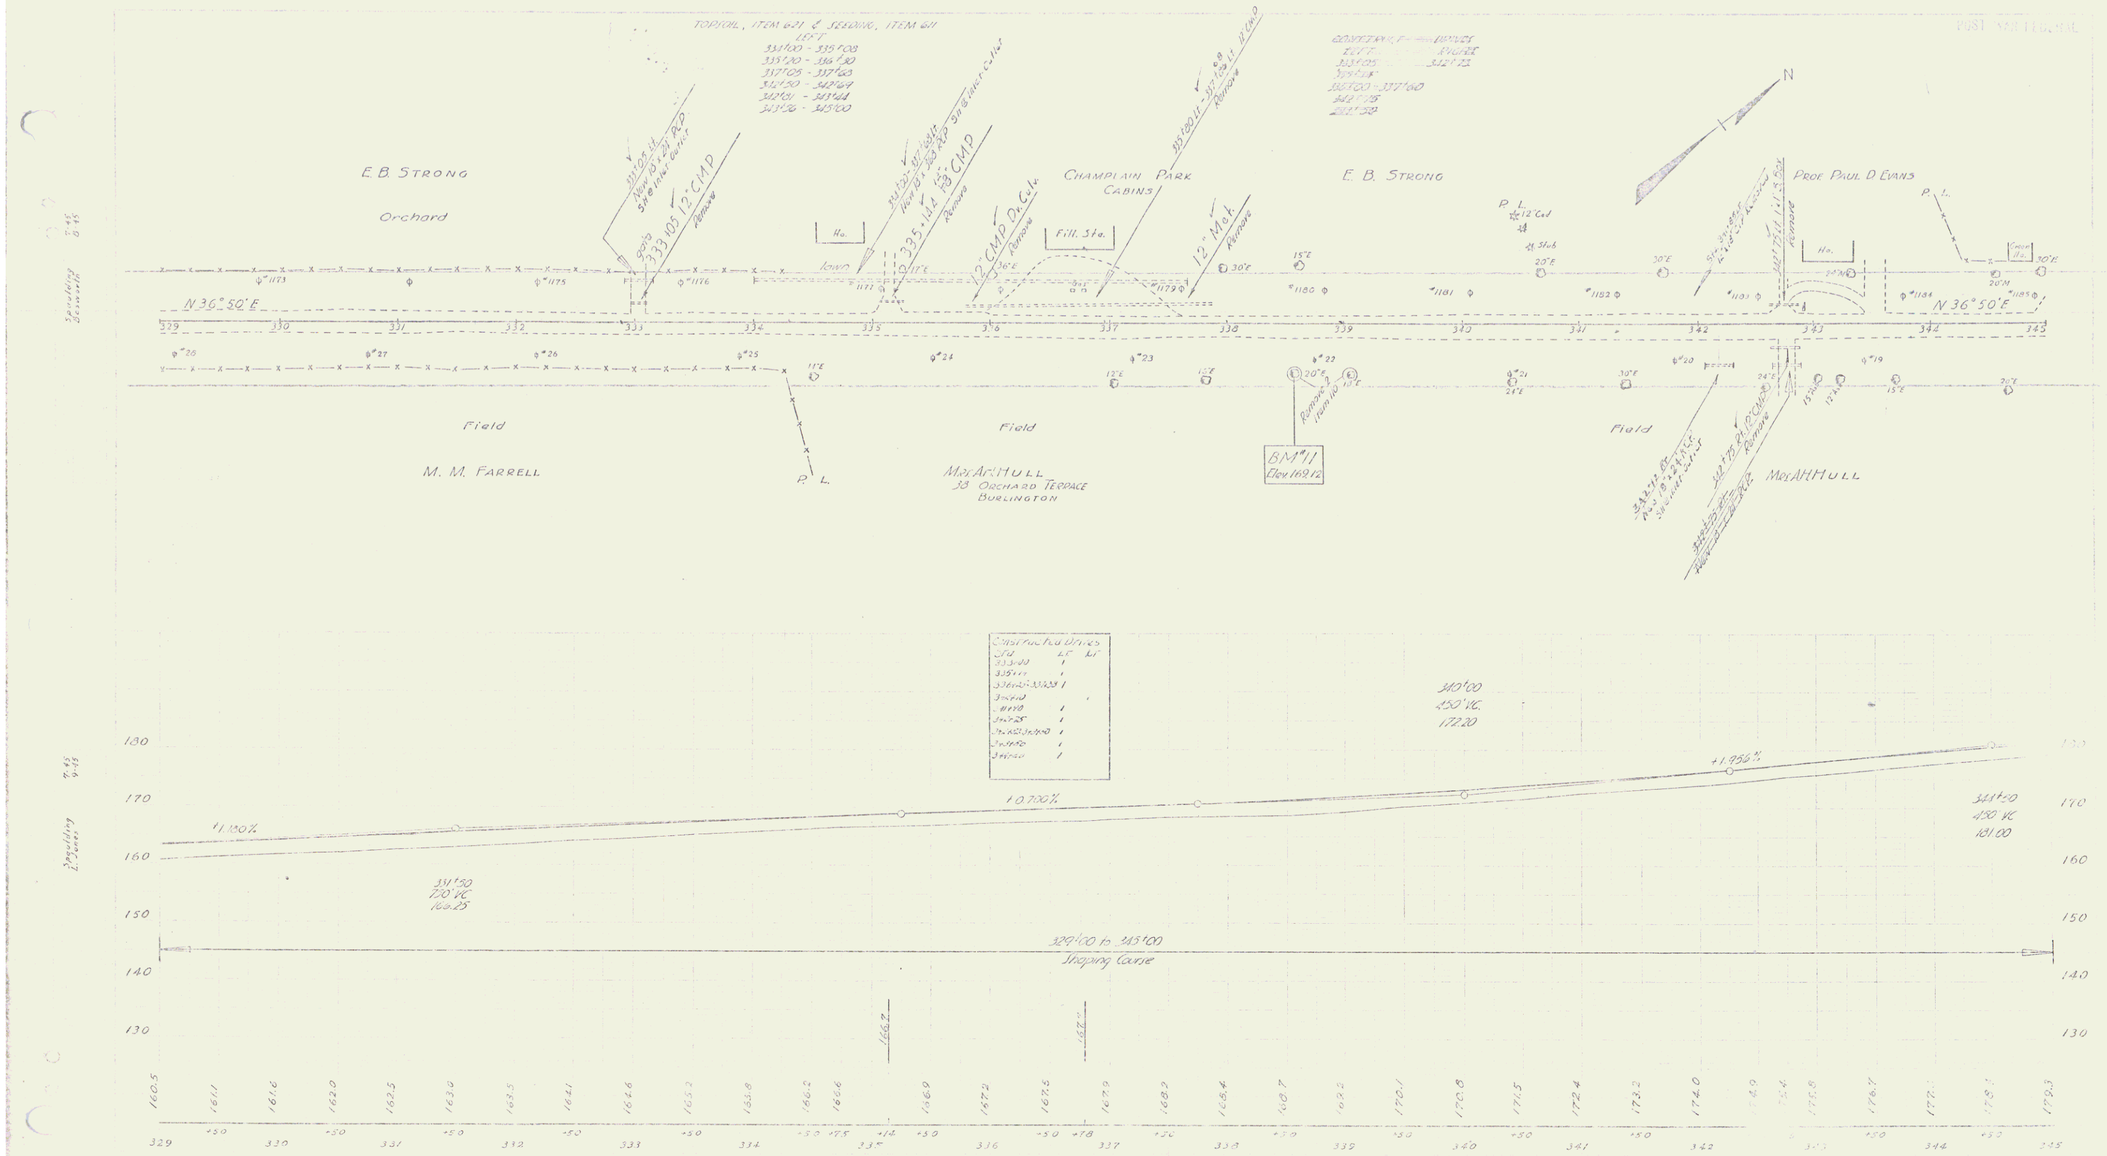
TOPSOIL, ITEM 621 & SEEDING, ITEM 611
LEFT
333+00 - 339+08
339+20 - 336+40
337+08 - 337+60
342+50 - 342+64
342+01 - 343+44
343+26 - 345+00
E. B. STRONG
Orchard
CHAMPLAIN PARK CABINS
E. B. STRONG
PROF. PAUL D. EVANS
N 36° 50' E
N 36° 50' E
Field
Field
Field
M. M. FARRELL
Mrs. ARMULL
38 ORCHARD TERRACE
BURLINGTON
BM #11
Elev 169.12
MRS. ARMULL
N
Spalding Sawmill
331+50
730' VC.
166.25
329+00 to 345+00
Shaping Course
341+50
450' VC.
181.00
+1.130%
-0.700%
+1.956%
B.M #11 Spike in root of 20" Elm 41 ft. rt. of sta. 336+56 - Elev. 169.12
SHELBURNE - SOUTH BURLINGTON
Sheet 18 of 19 Sheets