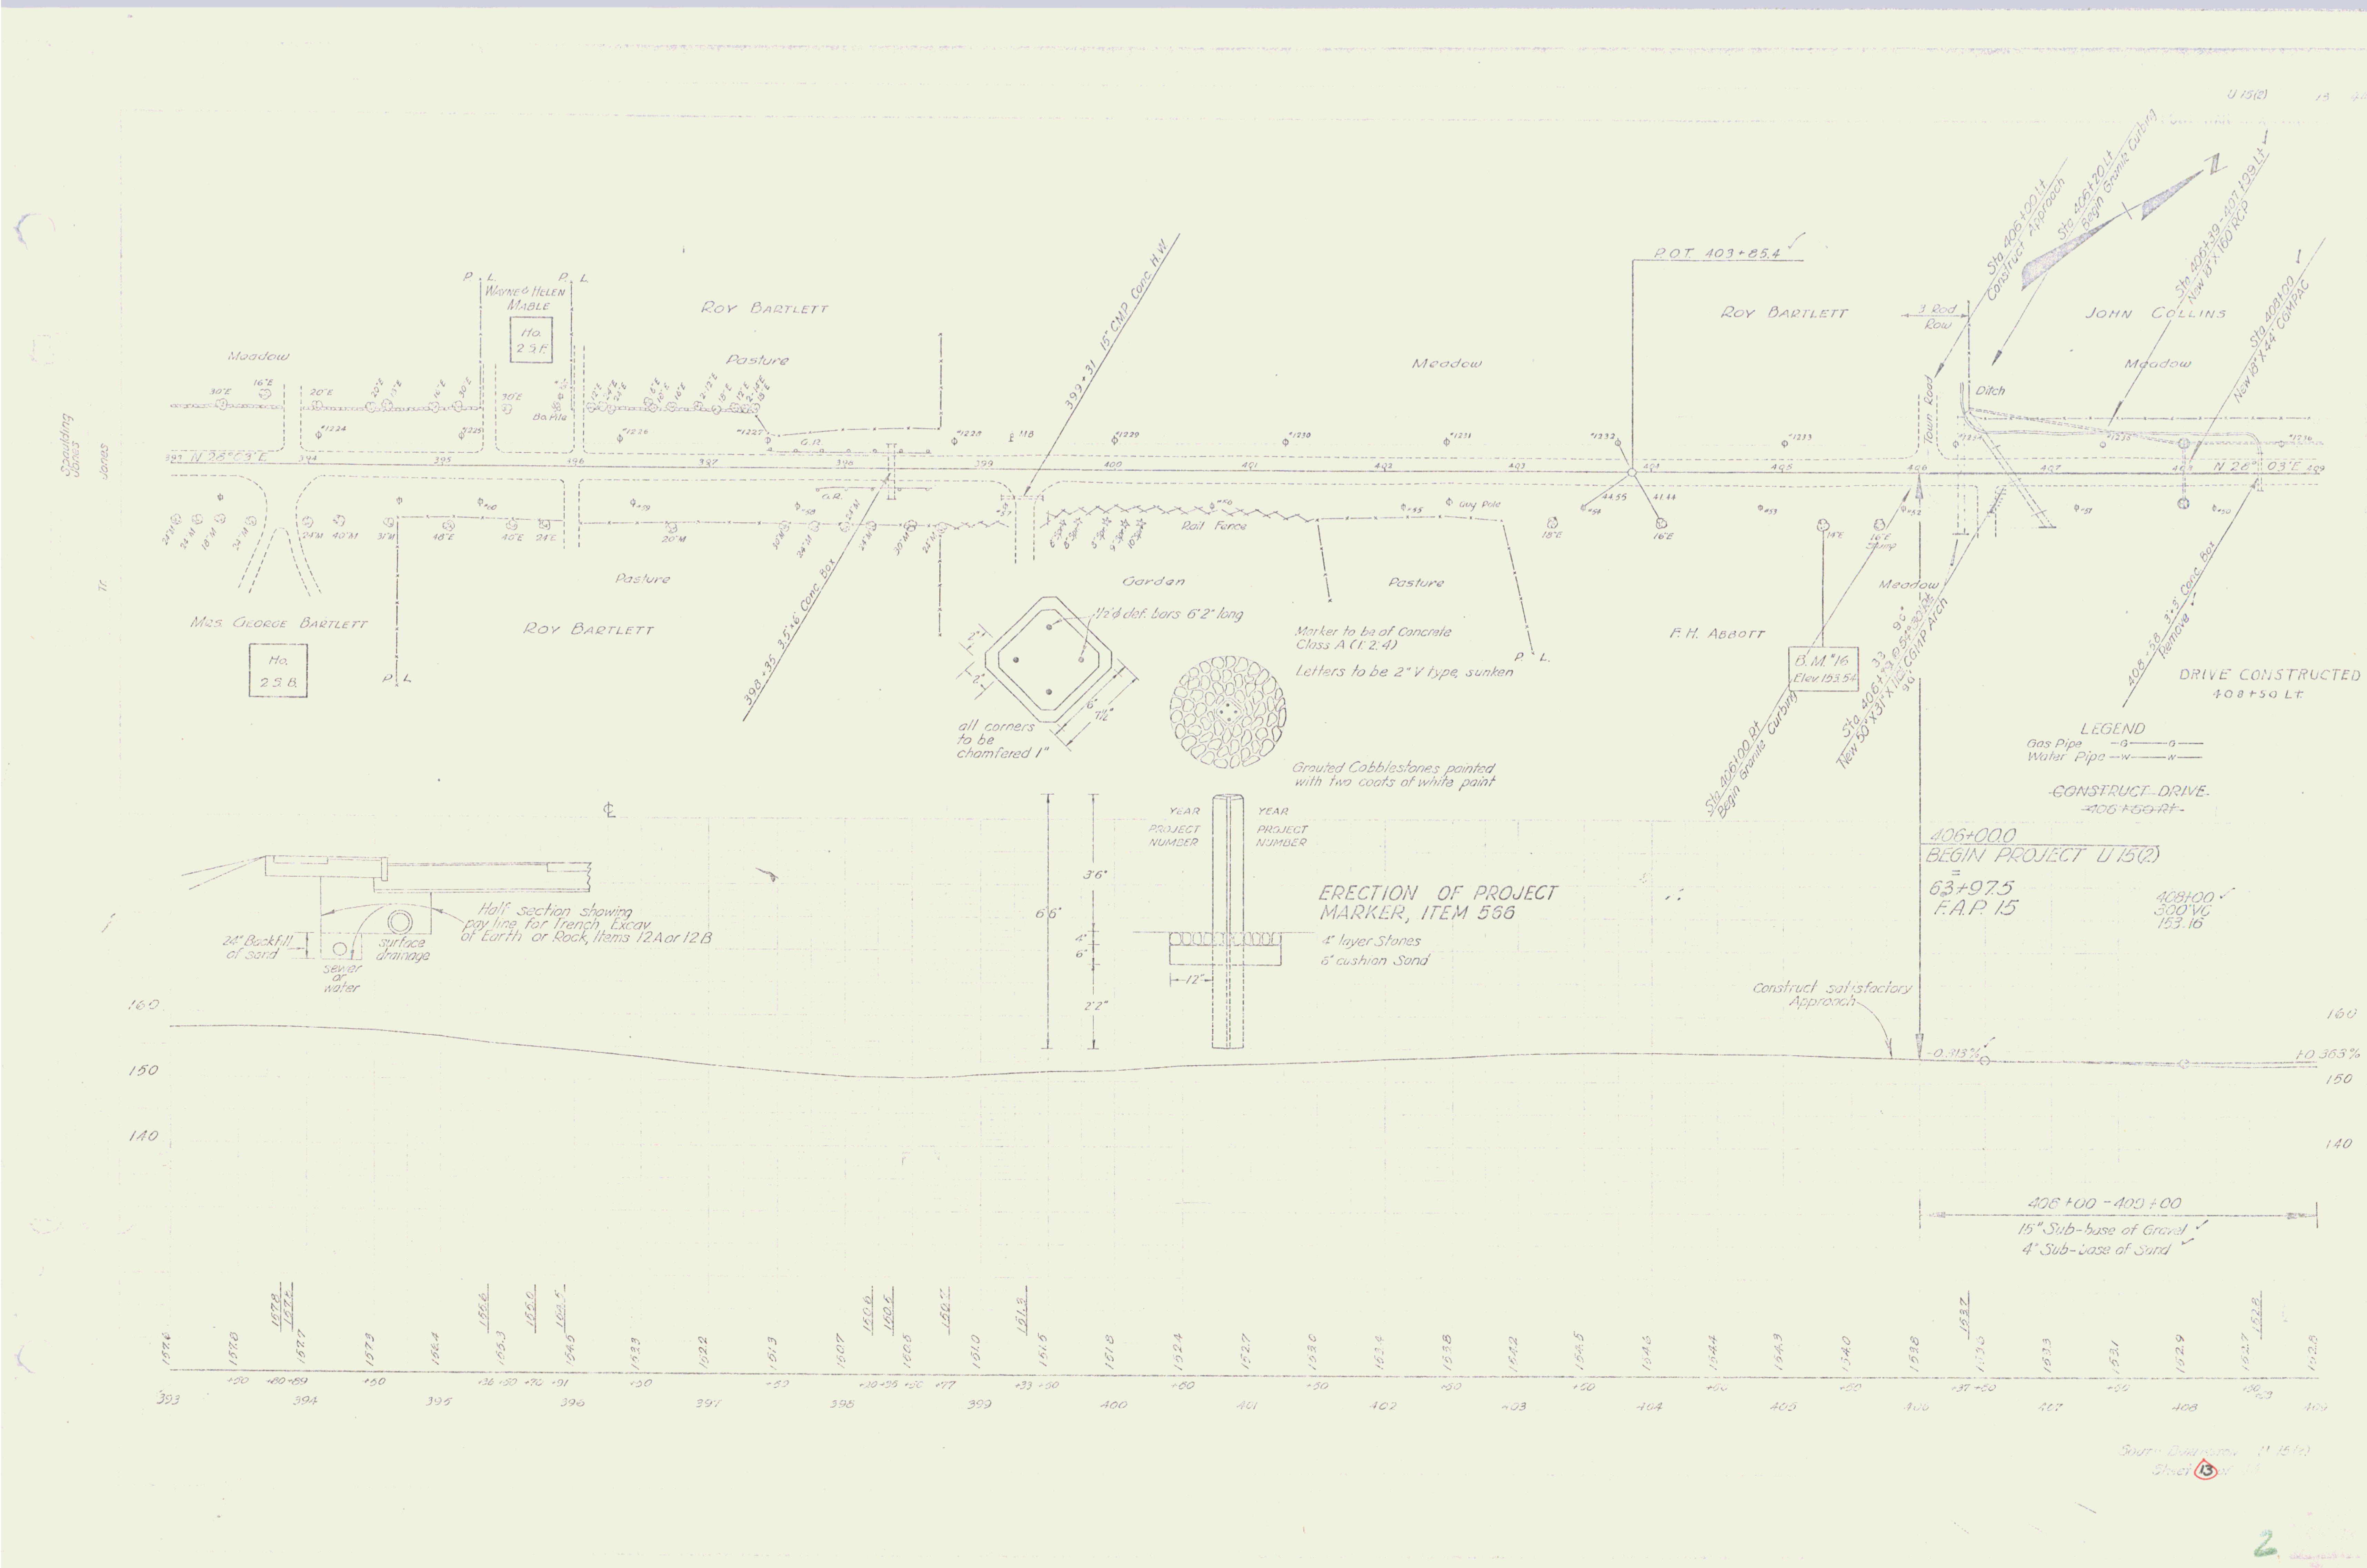

ROY BARTLETT
Pasture
Meadow
WAYNE & HELEN MABLE
Ha. 23 P.
399+31 15" CMP Conc. H.W.
P.O.T. 403+65.4
JOHN COLLINS
Meadow
Town Road
Ditch
Garden
Pasture
Rail Fence
Mrs GEORGE BARTLETT
Ha. 25 B.
398+35 3.5'x6 Conc. Box
Marker to be of Concrete Class A (1:2:4)
Letters to be 2" V type, sunken
all corners to be chamfered 1"
Grouted Cobblestones pointed with two coats of white paint
P. H. ABBOTT
B.M. 16 Elev. 153.54
DRIVE CONSTRUCTED 408+50 Lt.
LEGEND
Gas Pipe
Water Pipe
CONSTRUCT DRIVE 406+50 Rt.
406+00.0
BEGIN PROJECT U 15(2)
=
63+97.5
F.A.P. 15
408+00
300' VC
153.16
ERECTION OF PROJECT MARKER, ITEM 586
4" layer Stones
6" cushion Sand
YEAR PROJECT NUMBER
Half section showing pipe line for Trench Excav. of Earth or Rock, Items 12A or 12B
Surface drainage
Sewer or water
Construct satisfactory Approach
406+00 - 409+00
15" Sub-base of Gravel
4" Sub-base of Sand