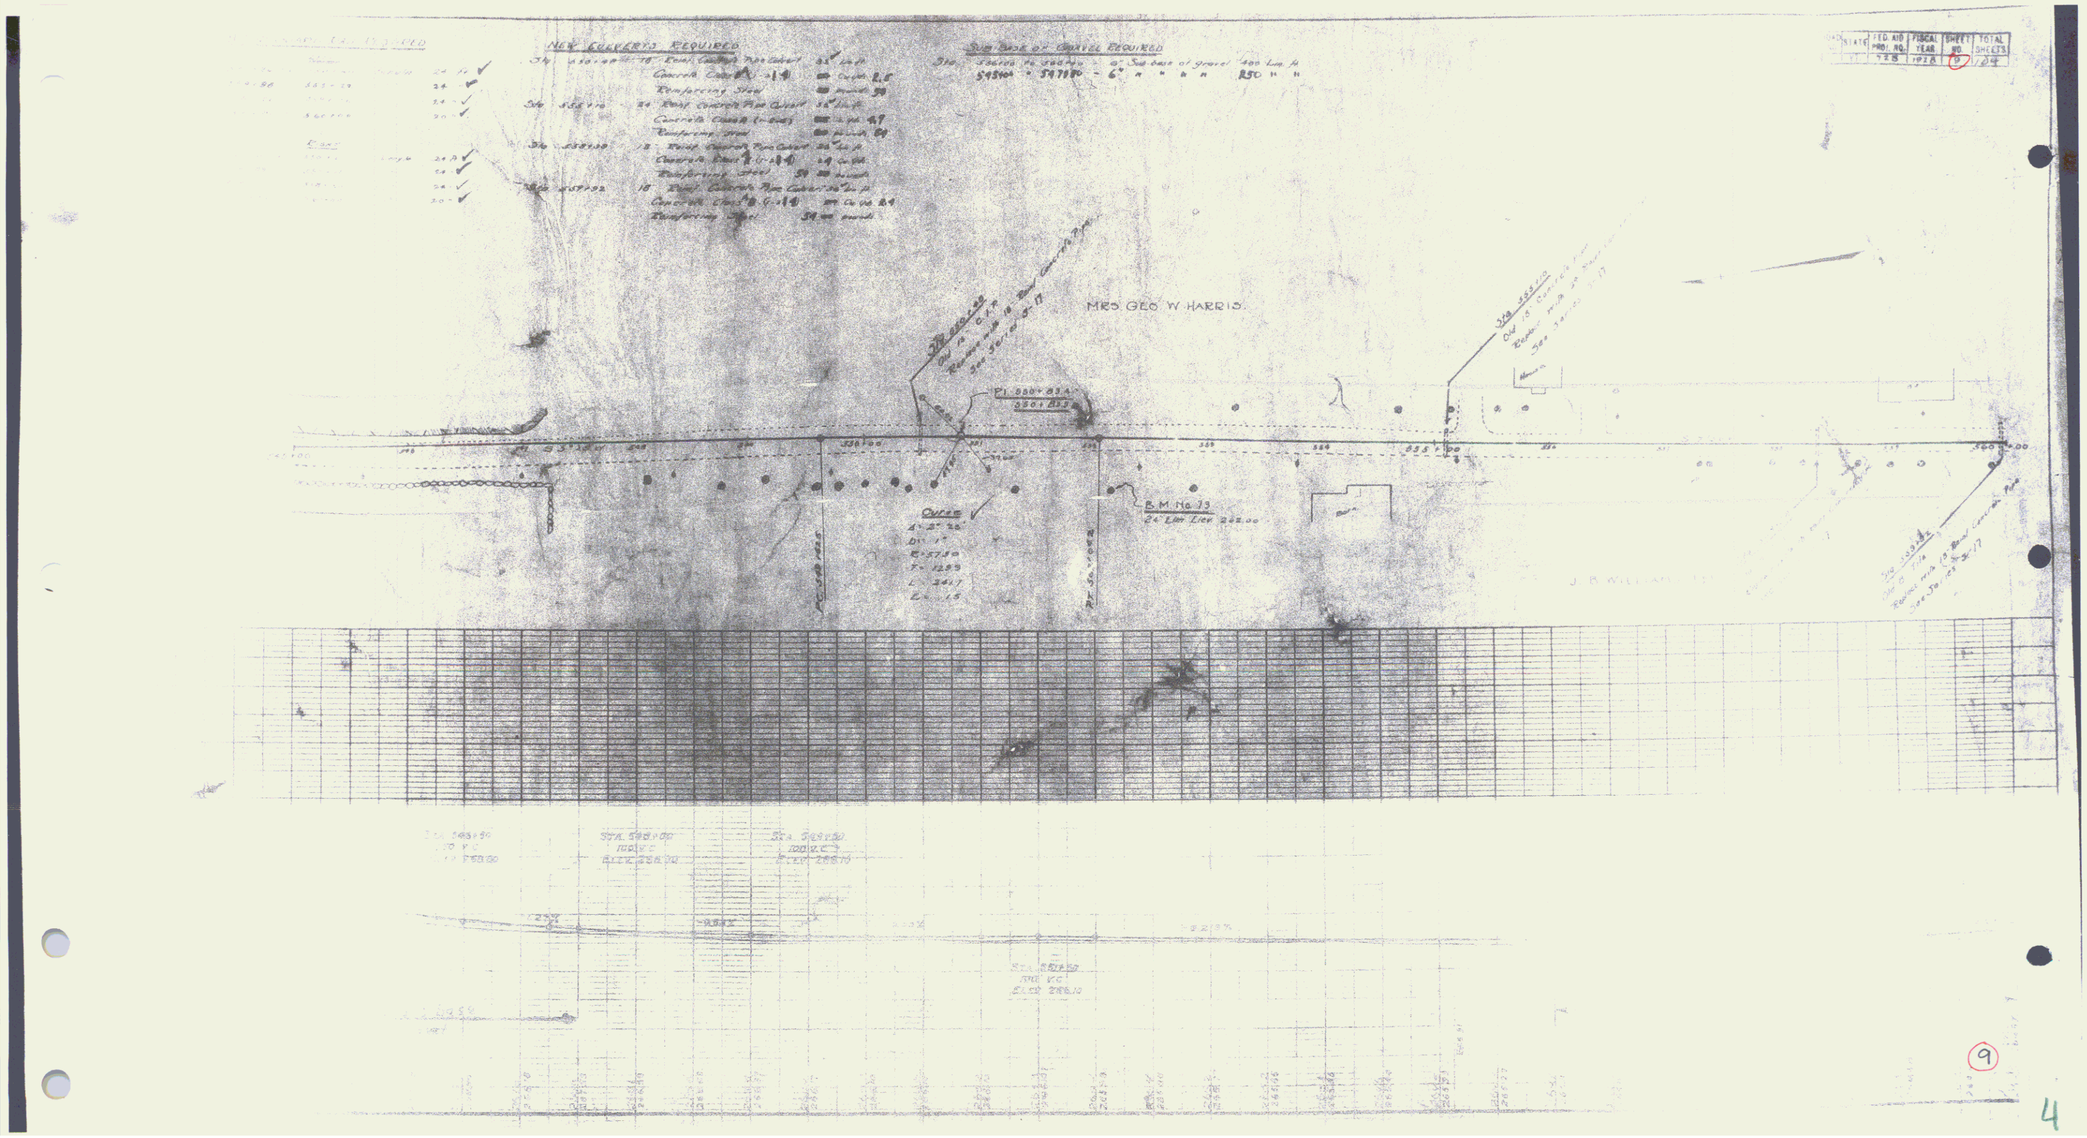
NEW CULVERTS REQUIRED
SUB BASE OR GRAVEL REQUIRED
MRS. GEO. W. HARRIS.
B.M. No. 13
24" Low Elev. 282.00
Curve
STATE
FED. AID PROJ. NO.
FISCAL YEAR
SHEET NO.
TOTAL SHEETS
9
4