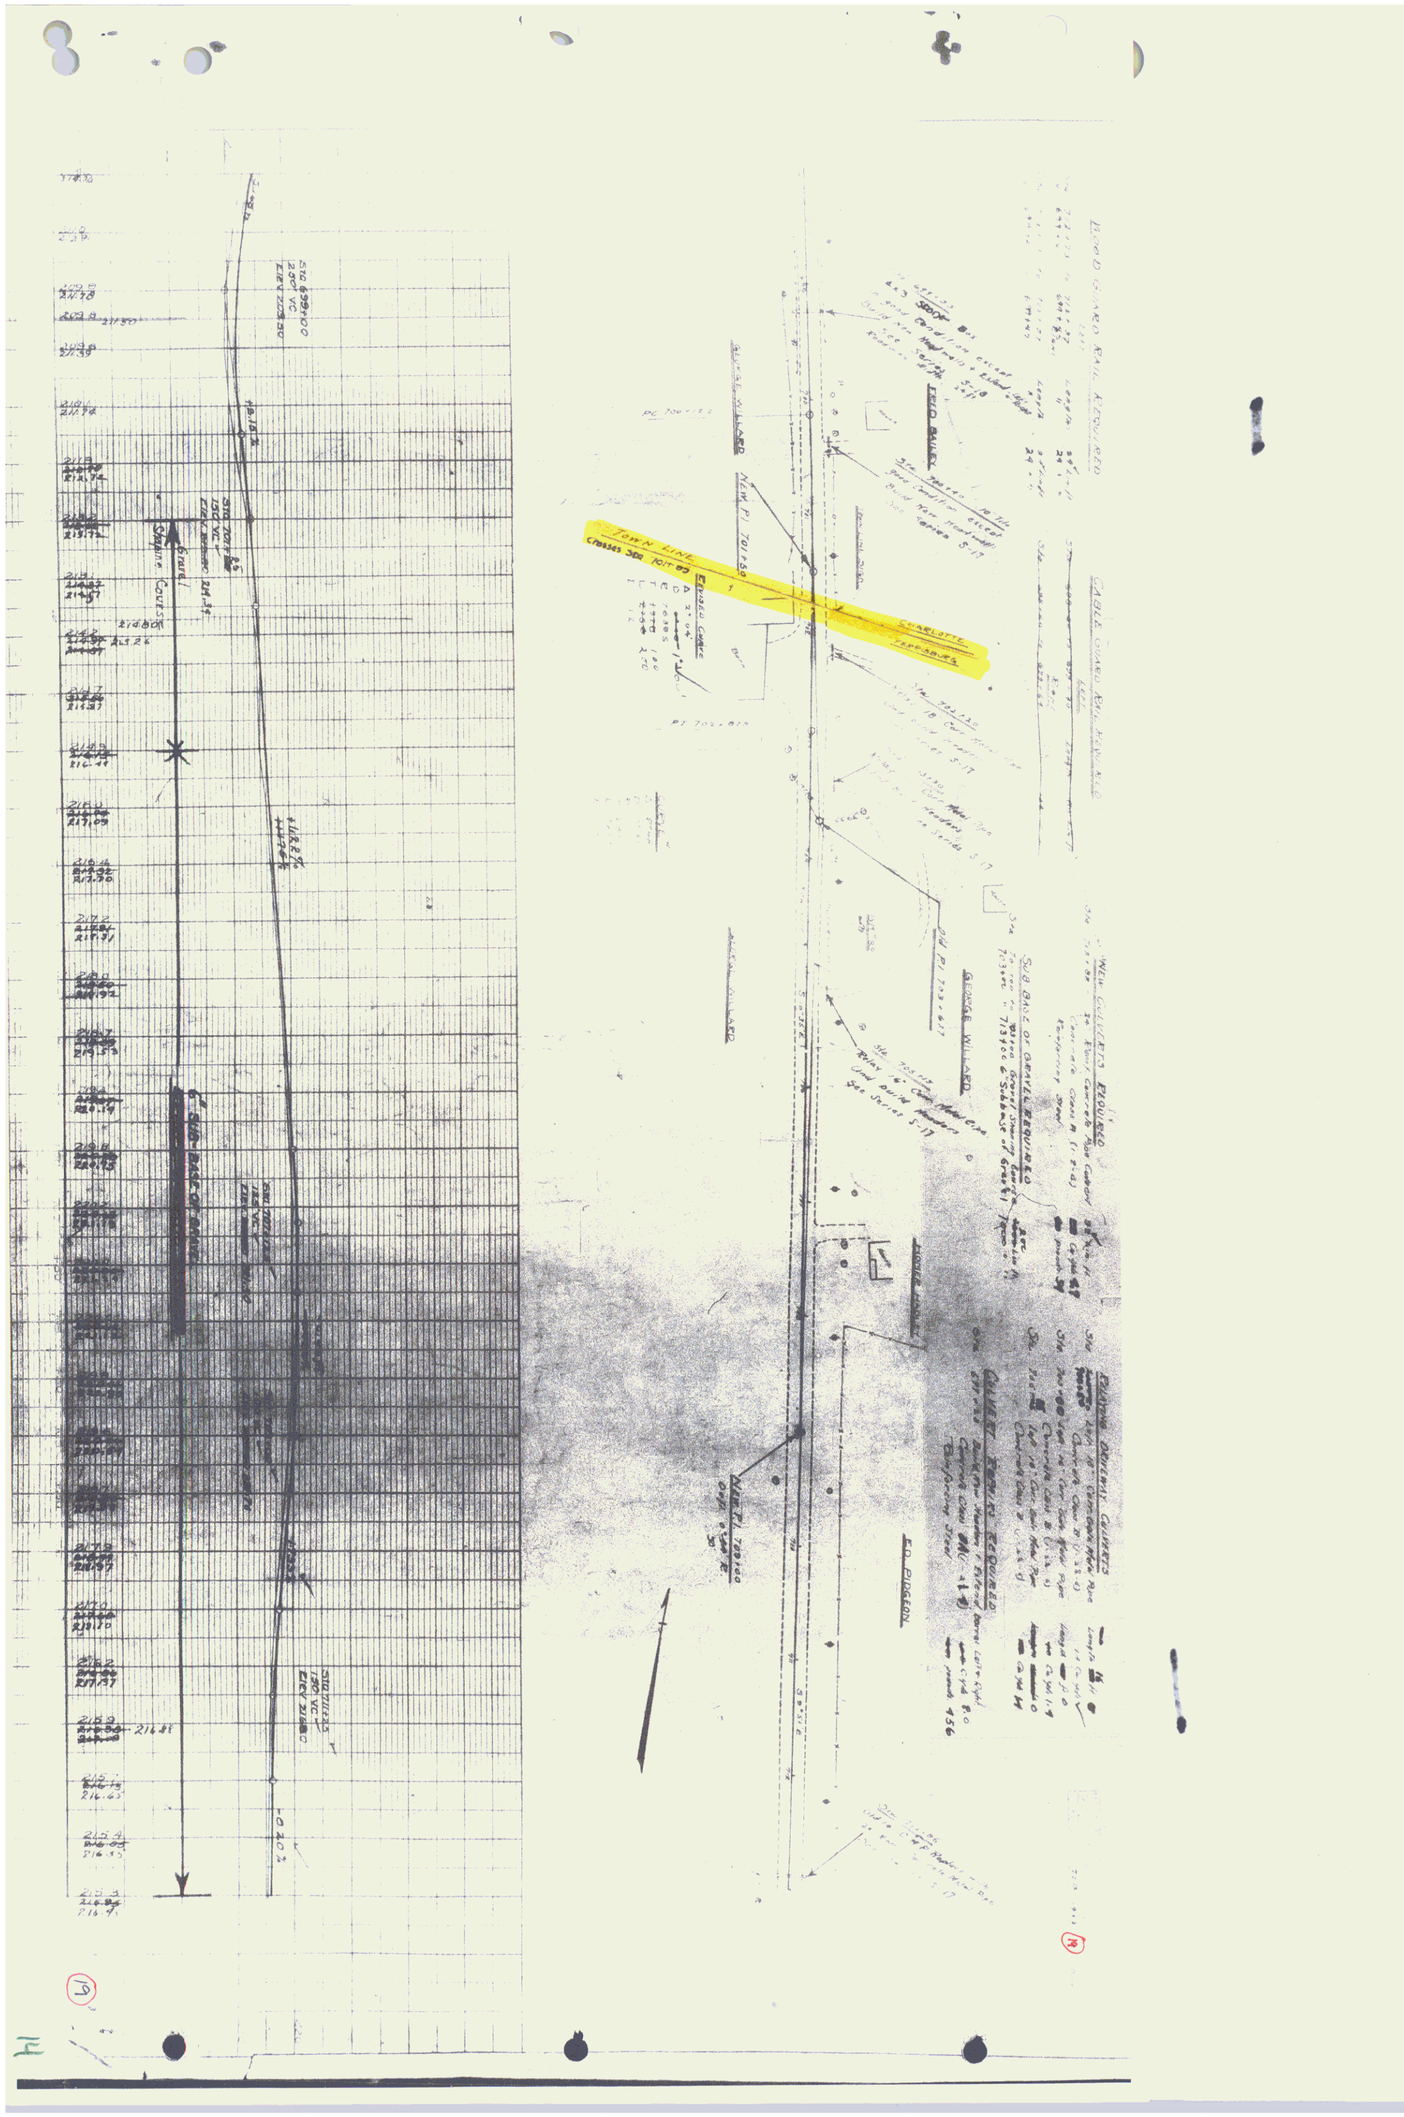
TOWN LINE
CHARLOTTE
FIELD BARREL
EXISTING ORIGINAL CULVERTS
NEW CULVERTS REQUIRED
SUB BASE OF GRAVEL REQUIRED
CULVERT REPAIRS REQUIRED
GEORGE WILLARD
ROBERT MOSLEY
ED PURDON
Square Cove Cr.
STA 699+00
20' VC
STA 701+00
20' VC
STA 702+00
20' VC
STA