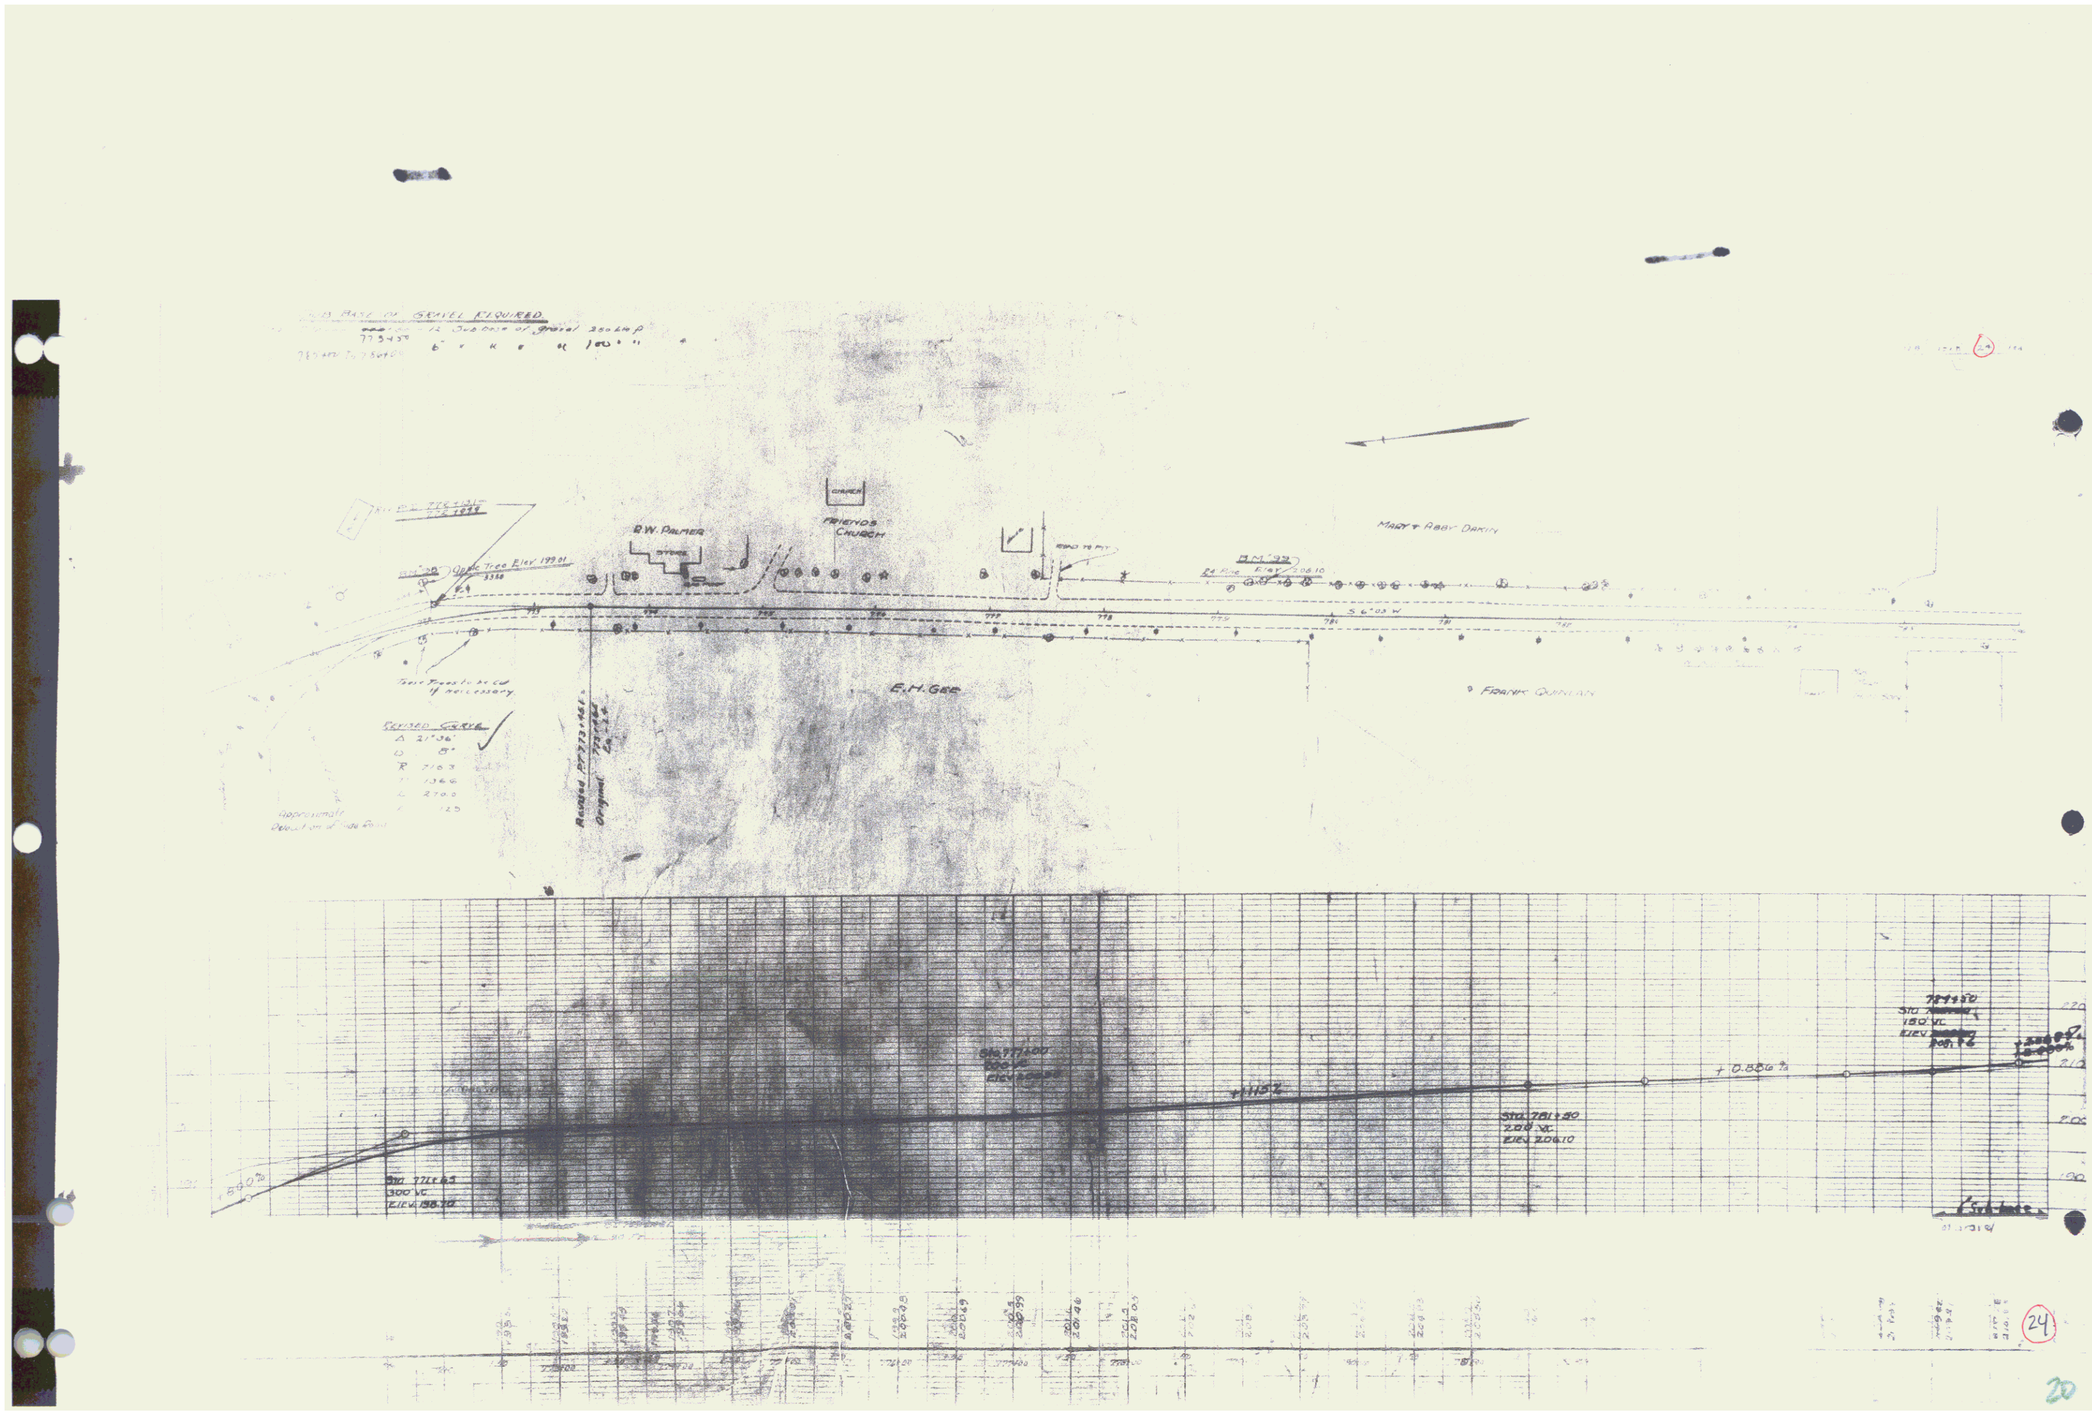
R.W. PALMER
FRIENDS CHURCH
MARY + ABBY DAKIN
E.H. GEE
FRANK QUINLAN
S 6°03 W
REVISED CURVE
Approximate Location of new Drive
Sta 771+63
300' VC
ELEV 198.70
Sta 781+50
200' VC
ELEV 206.10
+1.18%
-0.886%
24
20