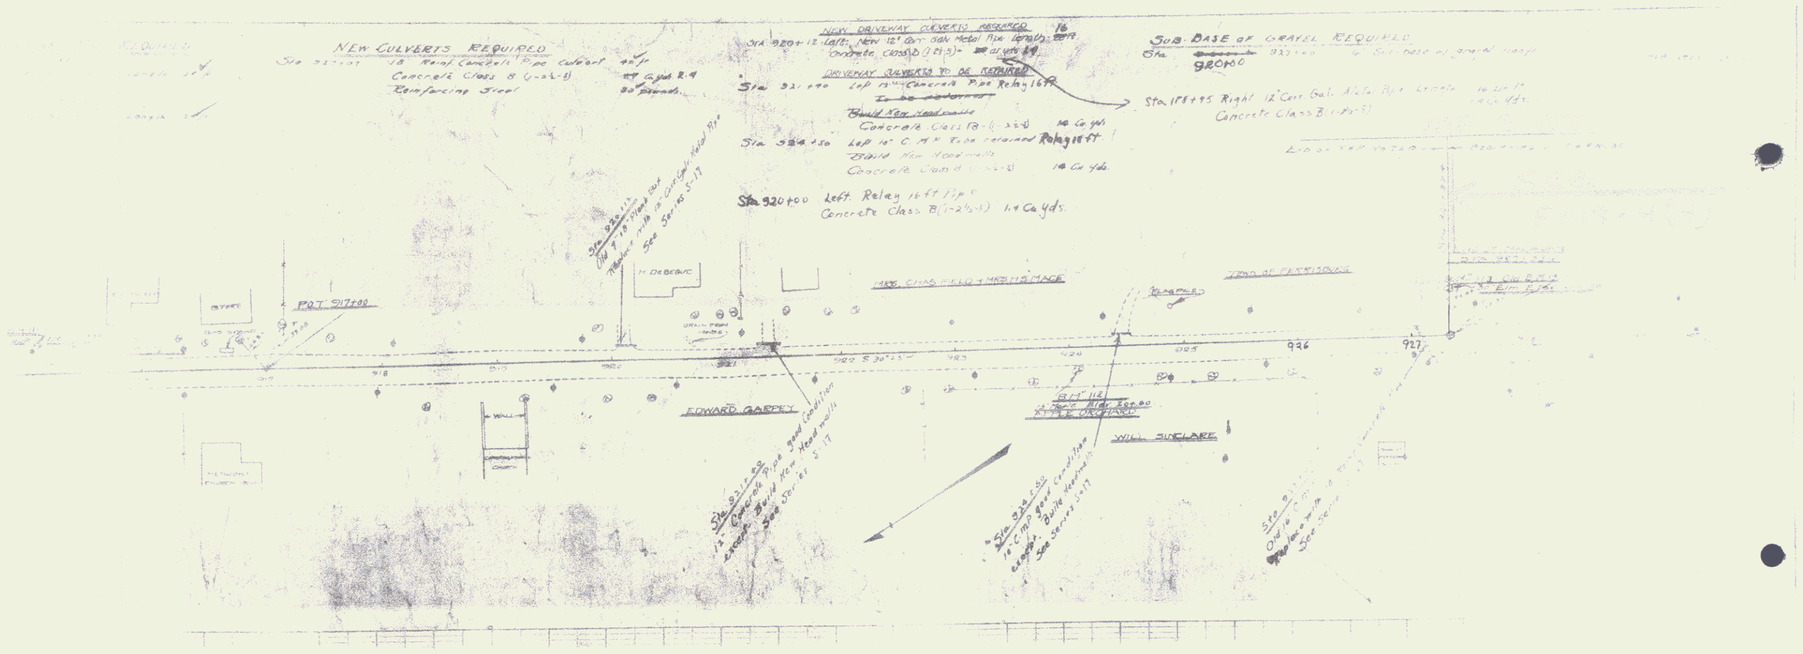
NEW CULVERTS REQUIRED
NEW DRIVEWAY CULVERTS REQUIRED
DRIVEWAY CULVERTS TO BE REPAIRED
Sta. 920+00 Left. Relay 16 ft Pipe
Concrete Class B (1-2½-3) 1.4 Cu yds.
SUB-BASE OF GRAVEL REQUIRED
Sta. 920+00
Sta. 186+95 Right 12" Corr Galv. Metal Pipe
Concrete Class B (1-2½-3)
EDWARD GARDEY
WILL SUCLARE
6" Sub-base of gravel